


T.6S., R.1E., W.M.

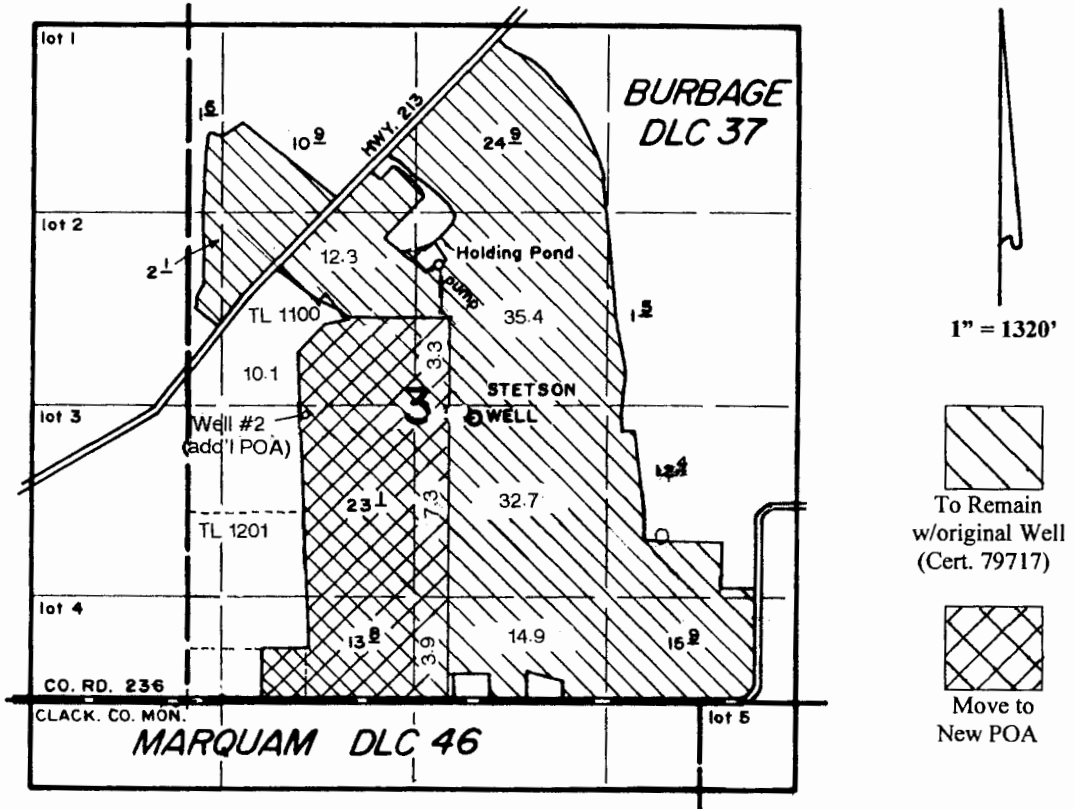


Exist'g Well is located 1930' N & 1960' E from the SW corner of DLC 37.
 Well #2 (add'l POA) is located 1960' N & 780' E from the SW corner of DLC 37.

Application Map

Ditchen Berry Farm, LLC.

Transfer #:

RECEIVED
 AUG 25 2014
 OWRD

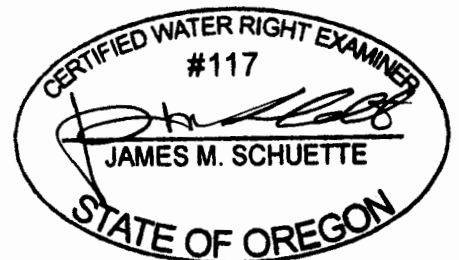

EXPIRES: 6-30-2014

This Map was Prepared for the Purpose of Identifying the Location of a Water Right Only and is Not Intended to Provide Legal Dimensions or Location of Property Ownership Lines.