
## T.9S., R.4W., W.M.

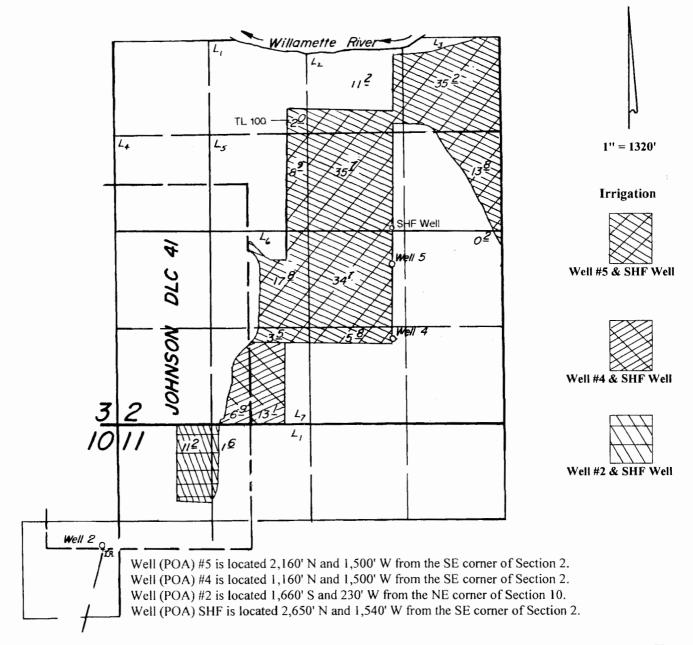

## **Application Map**

## RECEIVED

SEP 2 9 2014

Wigrich Farm Inc.

WATER RESOURCES DEPT

SALEM, OREGON

ED WATER RIGHT

EXPIRES: 6.30.16

Transfer #:

This Map was Prepared for the Purpose of Identifying the Location of a Water Right Only and is Not Intended to Provide Legal Dimensions or Location of Property Ownership Lines.