

TO LANDS
1N4W14-301
19.3 Ac OUT OF 25.3 TVID-CERT #88122

FROM LANDS
1N4W14-701
6 Ac OUT OF 25.3 TO REMAIN

N4A-27 N4A-28

KANSAS CITY

N4A-26


N4A3-2

N4A2-5

N4A2-2

BREEZY

N4A2-7
N4A2-8A
N4A2-8B

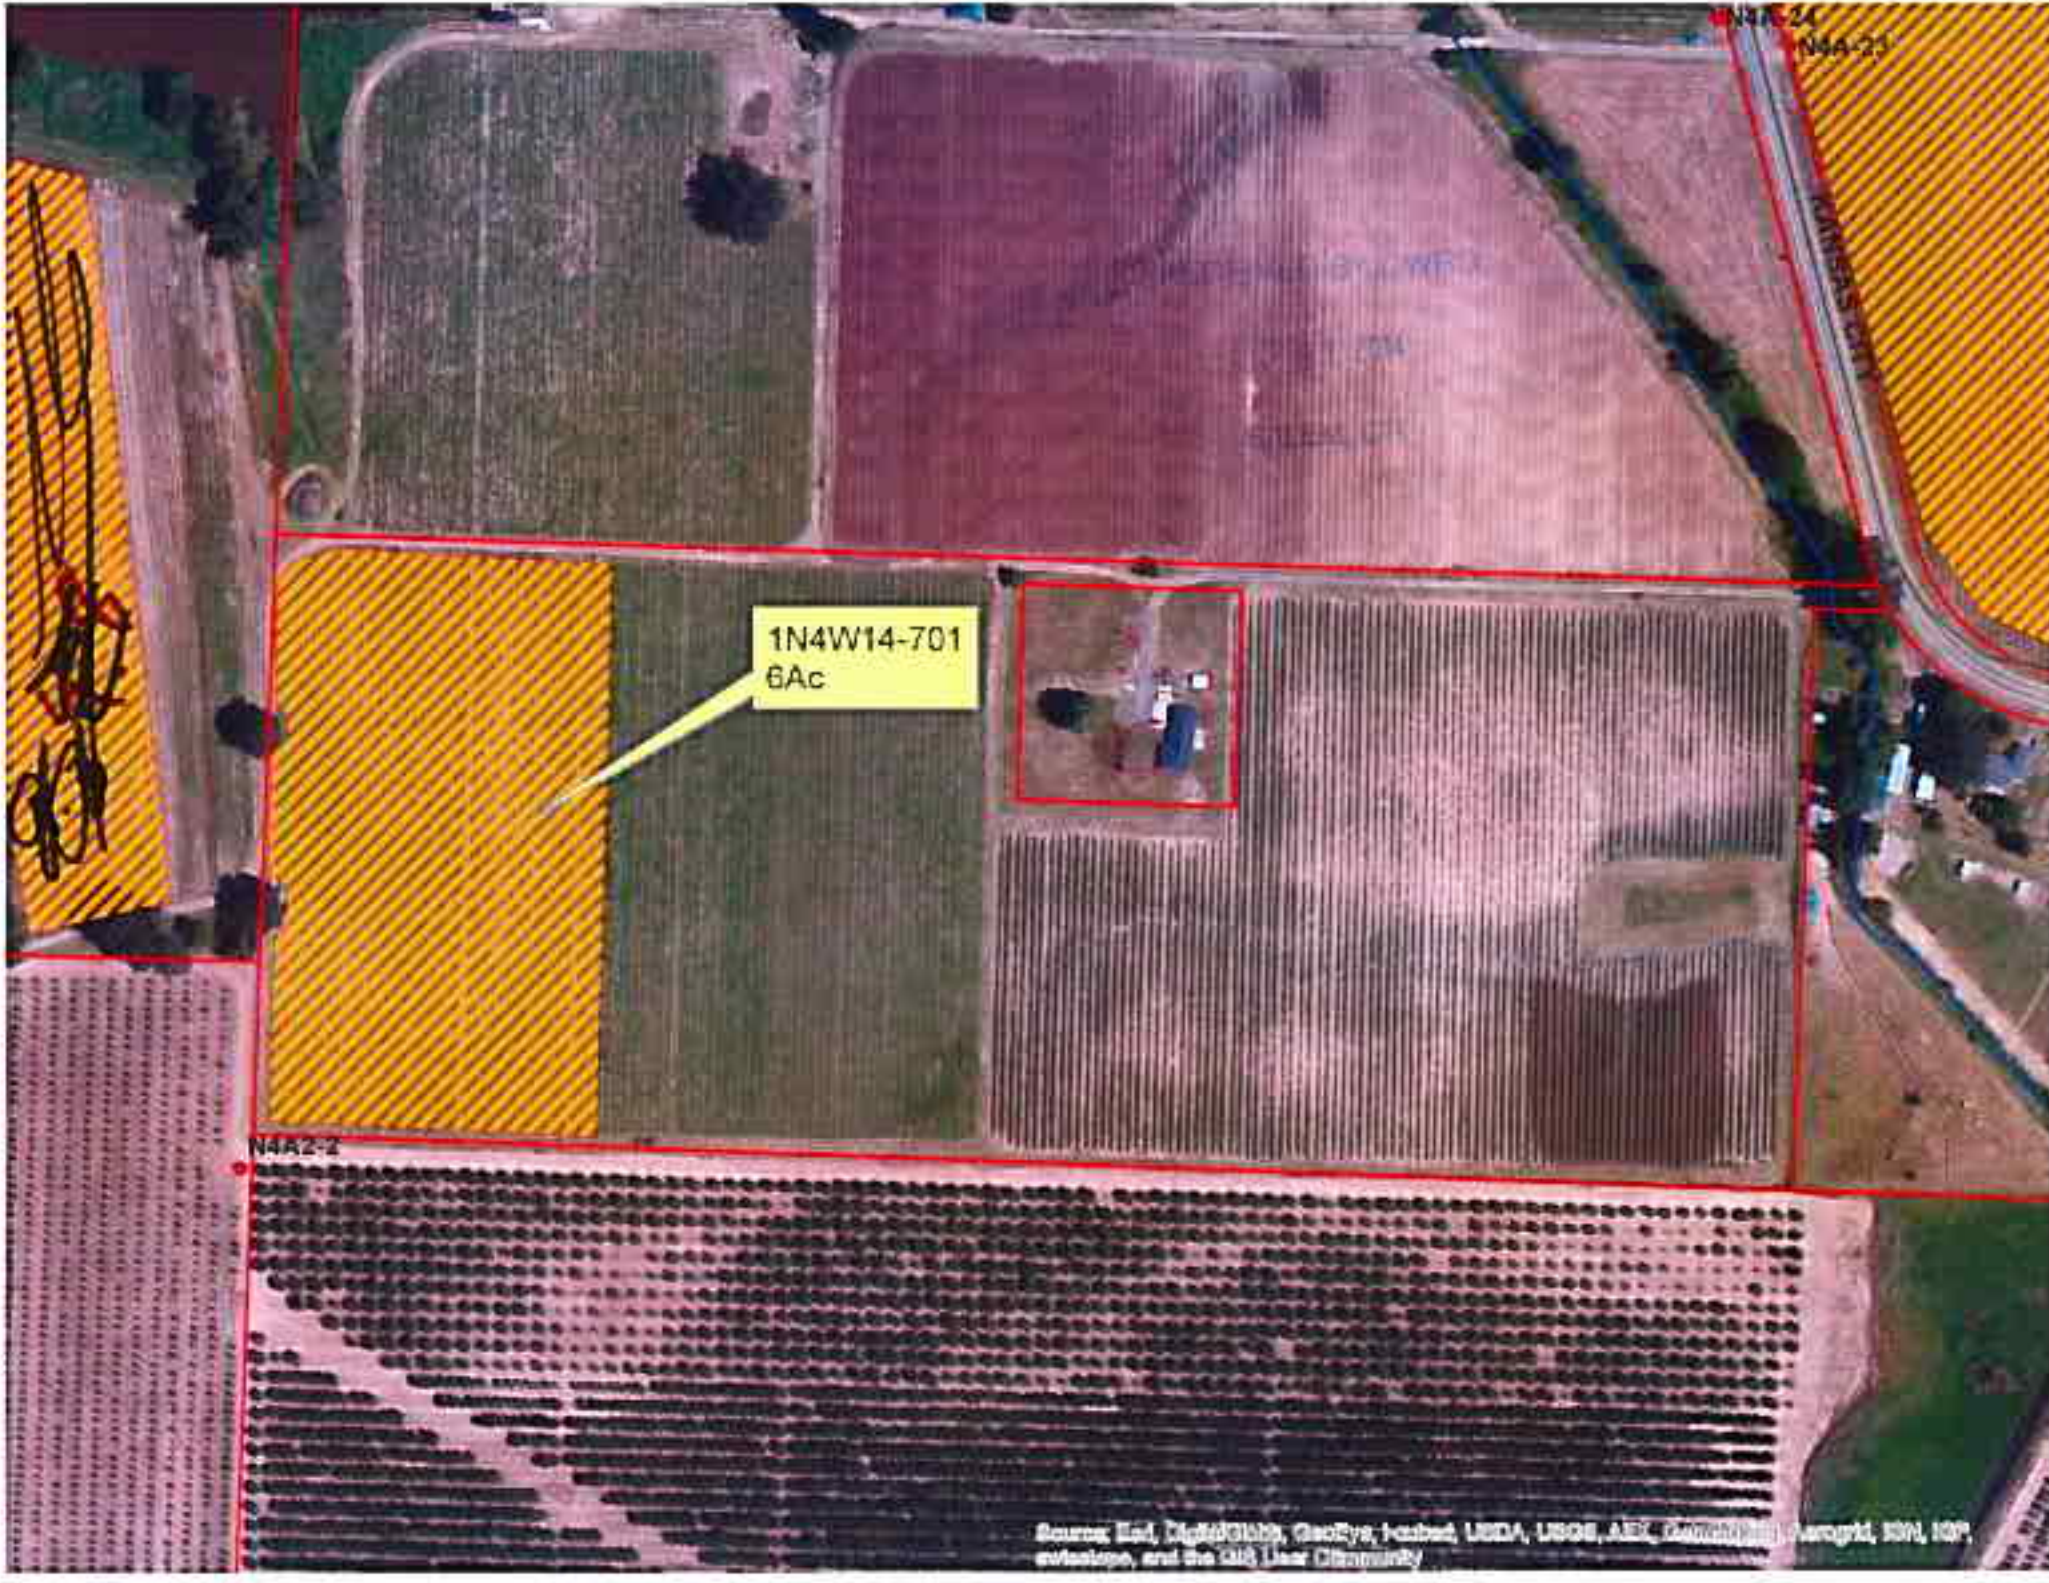

N4A-24
N4A-23

1N4W14-701
6Ac

N4A2-2



1N4W14-301
14.0 Ac

1N4W14-301
5.3 Ac

N1A2-5