


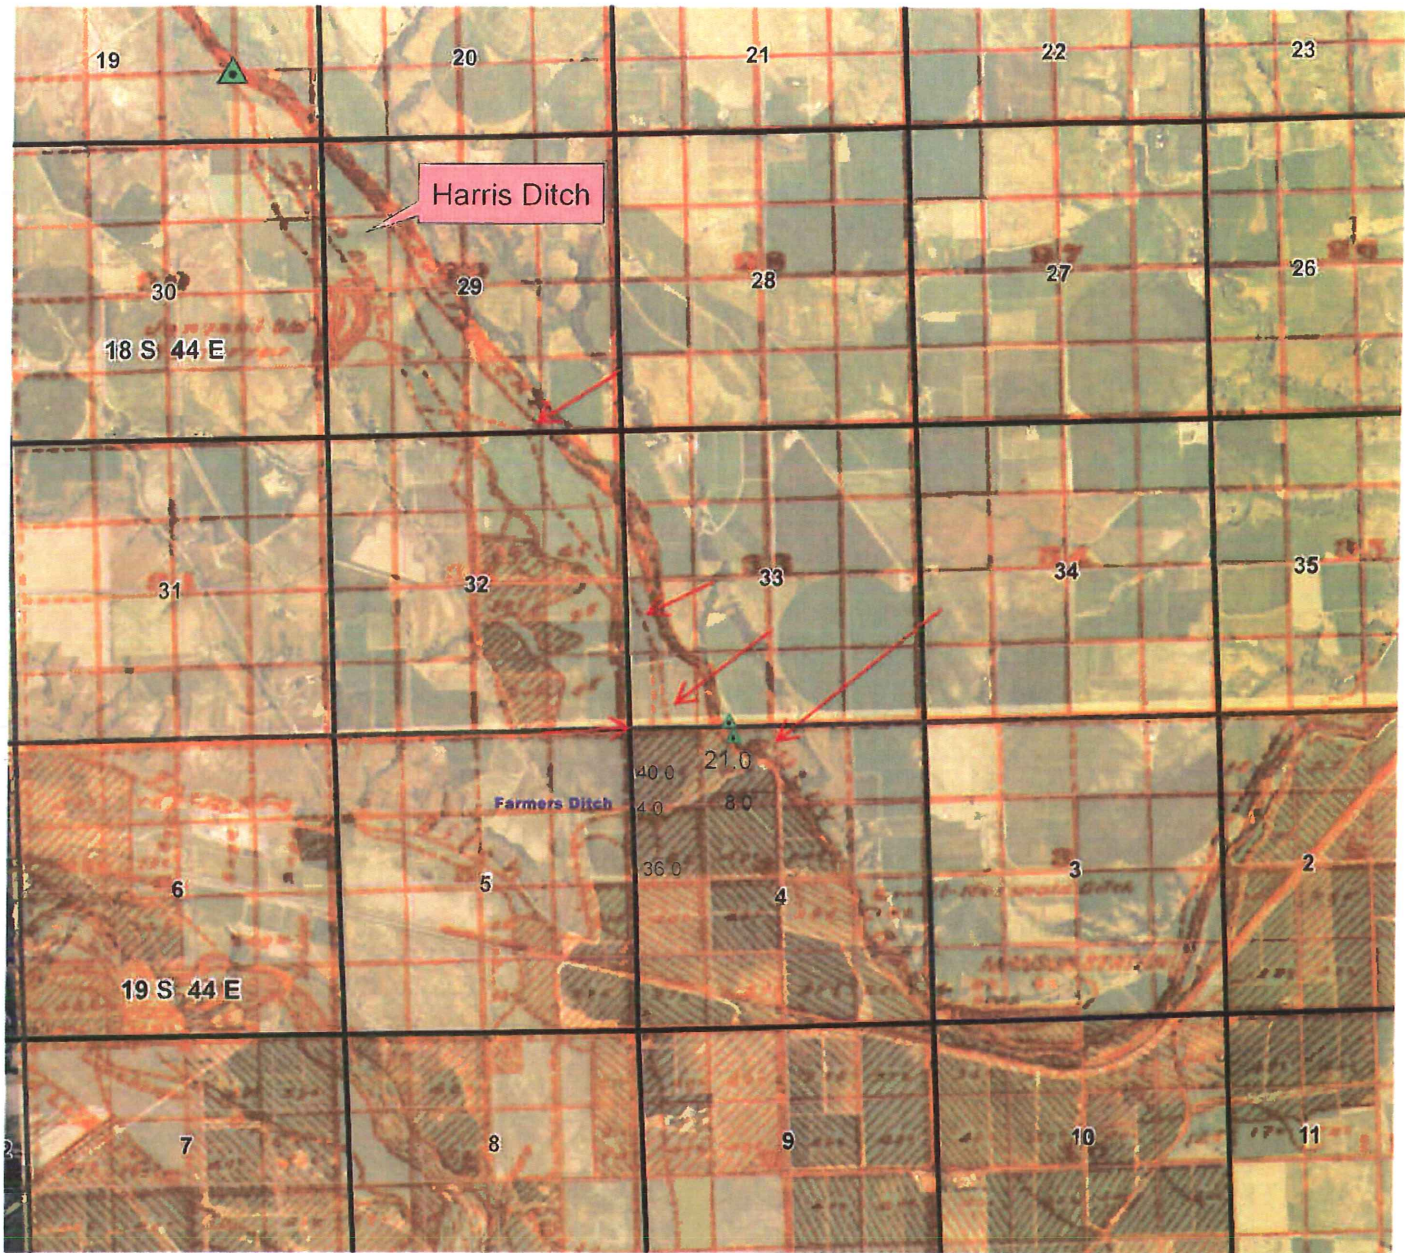

Authorized POD

ORIGINAL DECREE MAP GEOREFERENCED ONTO AERIAL PHOTO


RECEIVED BY OWRD

SEP 26 2013

SALEM, OR

T011669

CERTIFICATE 7049 MAP

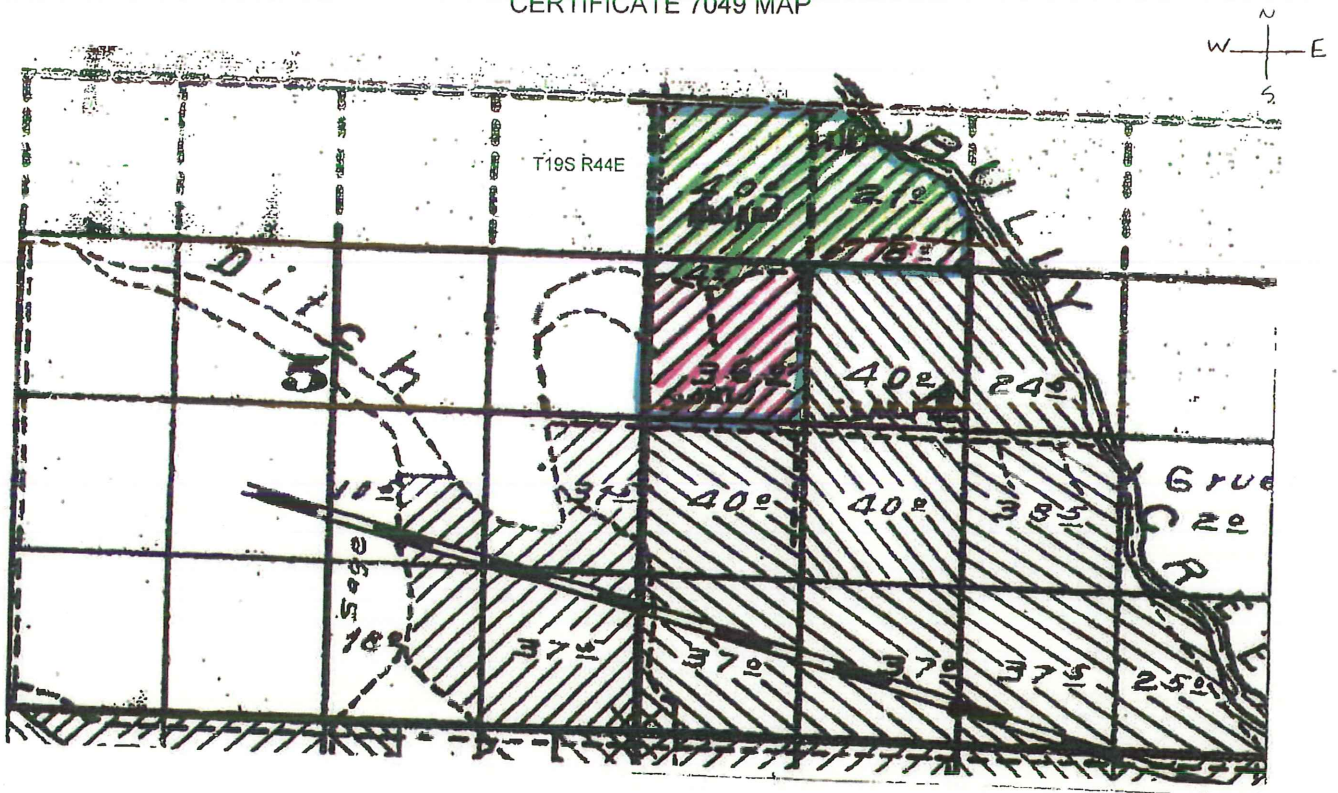

- Certificate 7049 authorized place of use
- Acres proposed for Change
- Acres unchanged

RECEIVED BY OWRD

SEP 26 2013

T011669

SALEM, OR

