



T.5S. R.2W. Section 36, W.M.

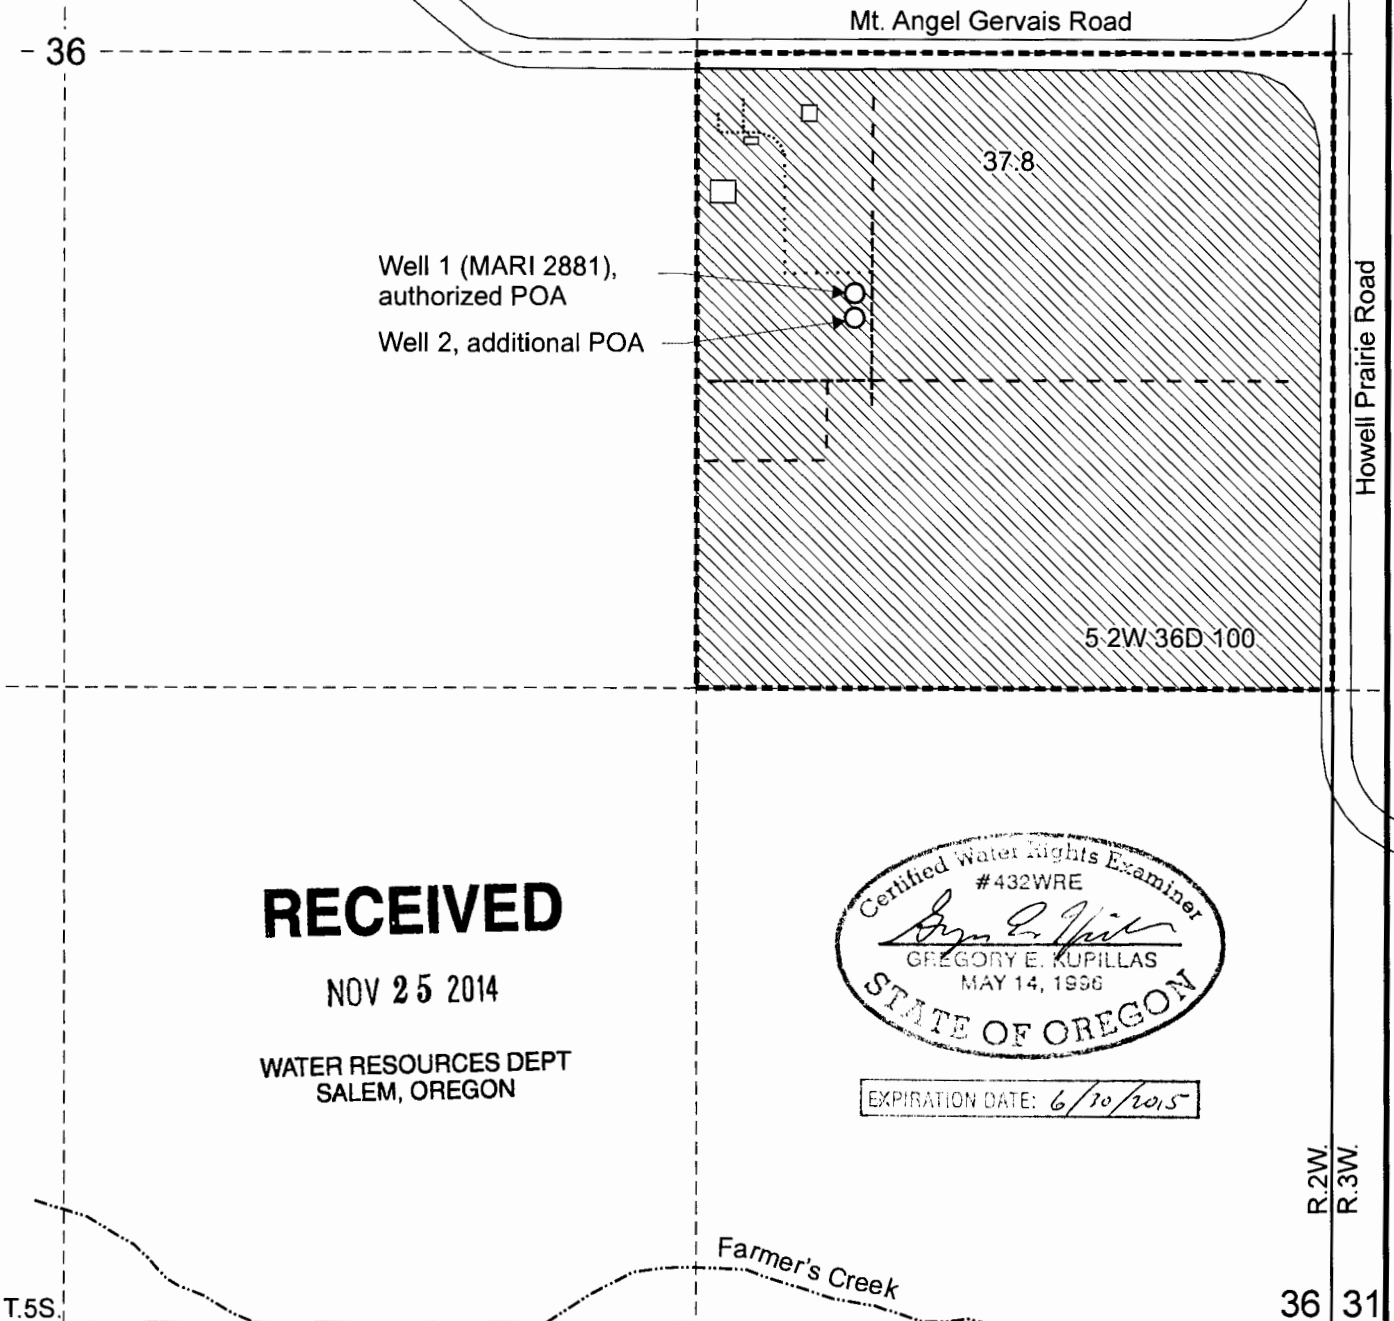

RECEIVED

NOV 25 2014

WATER RESOURCES DEPT
SALEM, OREGON

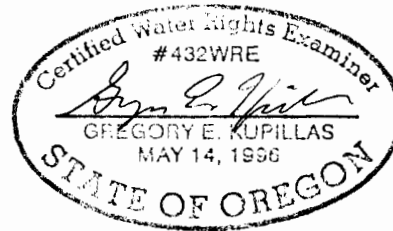

EXPIRATION DATE: 6/30/2015

T.5S. 36 31
T.6S. 1 6

Well 1 (MARI 2881), authorized point of appropriation (POA), is located 2,140 feet north and 990 feet west from the SE corner, Section 36.

Well 2, additional POA, is located 2,090 feet north and 990 feet west from the SE corner, Section 36.

Areas (37.8 acres) irrigated under GR 124

Tax lot boundary

6-inch buried mainline

6-inch above-ground mainline


4-inch buried mainline

2-inch buried mainline

This map was prepared for the purpose of identifying the location of a water right only and is not intended to provide legal dimensions or location of property ownership lines.



Scale: 1" = 400'

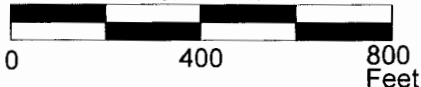

Ground Water Registration Modification Map
GR 124

Gardenscape Nursery Inc/Paul Kuschnick
T.5S. R.2W. Section 36, W.M.

Pacific Hydro-Geology Inc.

2014 - bgp