


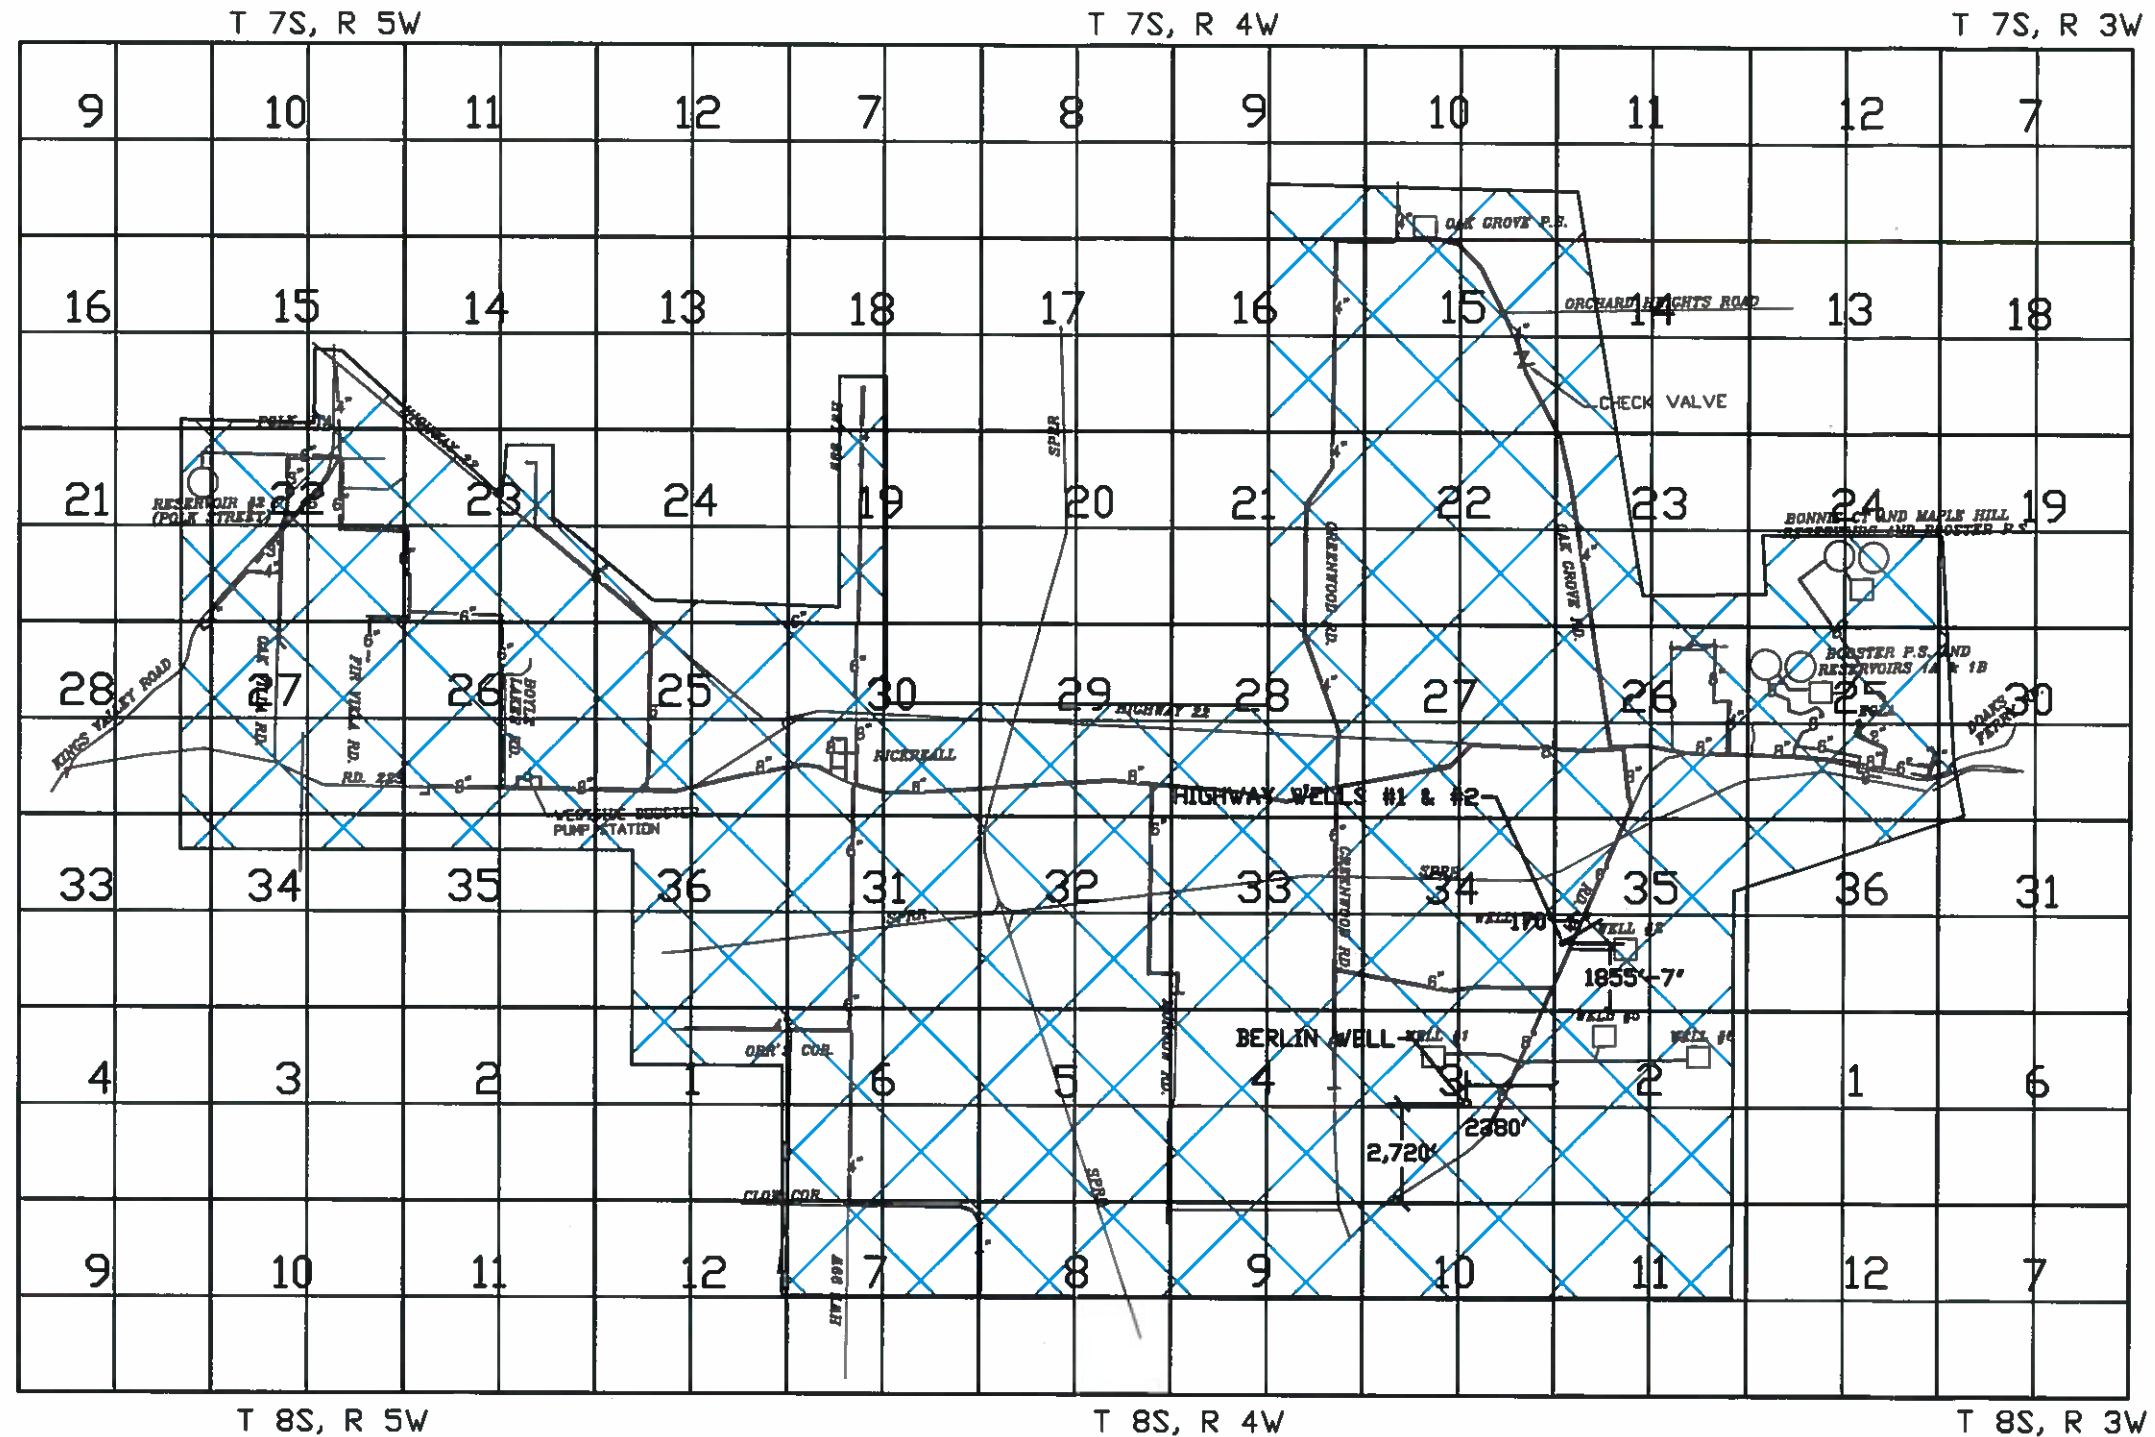


WATER USE AREA- 

NOTE: MAP IS FOR SOLE PURPOSE
OF IDENTIFYING LOCATION OF WATER
RIGHT AND HAS NO INTENT TO DIMENSION
OR LOCATE ANY PROPERTY OWNERSHIP LINES

PERMIT# G-11288

BERLIN WELL IS 2,720' NORTH AND 2,380'
WEST OF THE SE CORNER OF TOWNSHIP 8S,
RANGE 4W, SECTION 3.

HIGHWAY WELLS #1 AND #2 ARE 1855'-7"
NORTH AND 235'-6" EAST OF THE SW CORNER
OF TOWNSHIP 7S, RANGE 4W, SECTION 35.

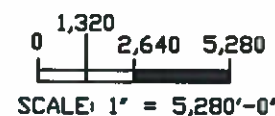

RICKREALL COMMUNITY WATER ASSOC.
HIGHWAY WELLS
LIMITED WATER USE LICENSE
WATER RIGHTS APPLICATION MAP
JANUARY 21, 2015

RECEIVED

JAN 23 2015

WATER RESOURCES DEPT
SALEM, OREGON

T 11970