


T. 2 S., R. 1 W., W.M.

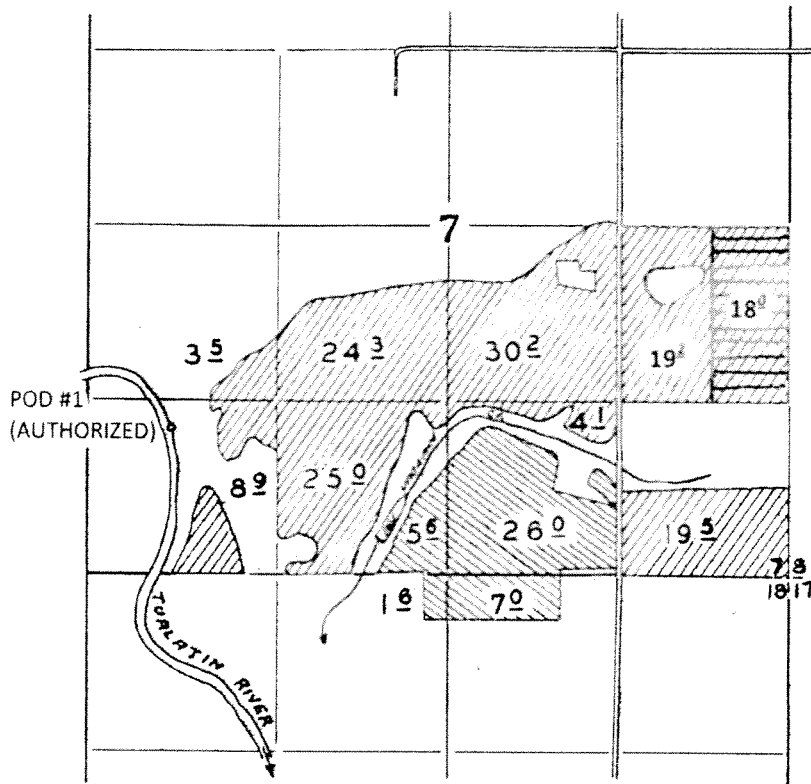

RECEIVED BY OWRD

FEB 17 2015

SALEM, OR

"FROM LANDS" T-11902  
(TUALATIN RIVER)



TUALATIN RIVER  
UNNAMED STREAM



### FINAL PROOF SURVEY

UNDER

Application No. 26823 Permit No. 21065

IN NAME OF

JOHN A. BAGGENSTOS

Surveyed 5 - 9 1956, by M. BISH

RECEIVED BY OWRD

FEB 17 2015

SALEM, OR

POD #2  
(PROPOSED)

88-2

TUALATIN  
NW

PIPELINE

19

NESW

POWER

SW

SWSW

SE

88-14

ADMINISTRATION


88-13

2S119

2S119

2S119

2S119

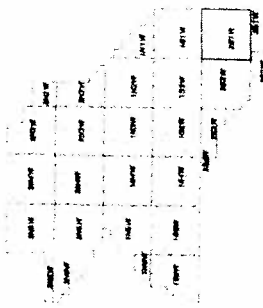

WASHINGTON COUNTY OREGON  
SECTION 19 T2S R1W W.M.  
SCALE 1" = 400'

1	2	3	4	5	6
7	8	9	10	11	12
13	14	15	16	17	18
19	20	21	22	23	24
25	26	27	28	29	30
31	32	33	34	35	36

FOR ADDITIONAL MAPS VISIT OUR WEBSITE AT  
www.co.washington.or.us

----	----	

Cancelled Tablets For: 28119  

"To Lands" T-11902  
(TUALATIN RIVER)

JIM BAGGENSTOS  
BAGGENSTOS FARMS INC.

CERTIFICATE 23580

08/03/14/19