



Certificate 47188 authorized POD Well 1- proposed Additional POD Well 2
 Certificate 50613 authorized POD Well 2- proposed Additional POD Well 1

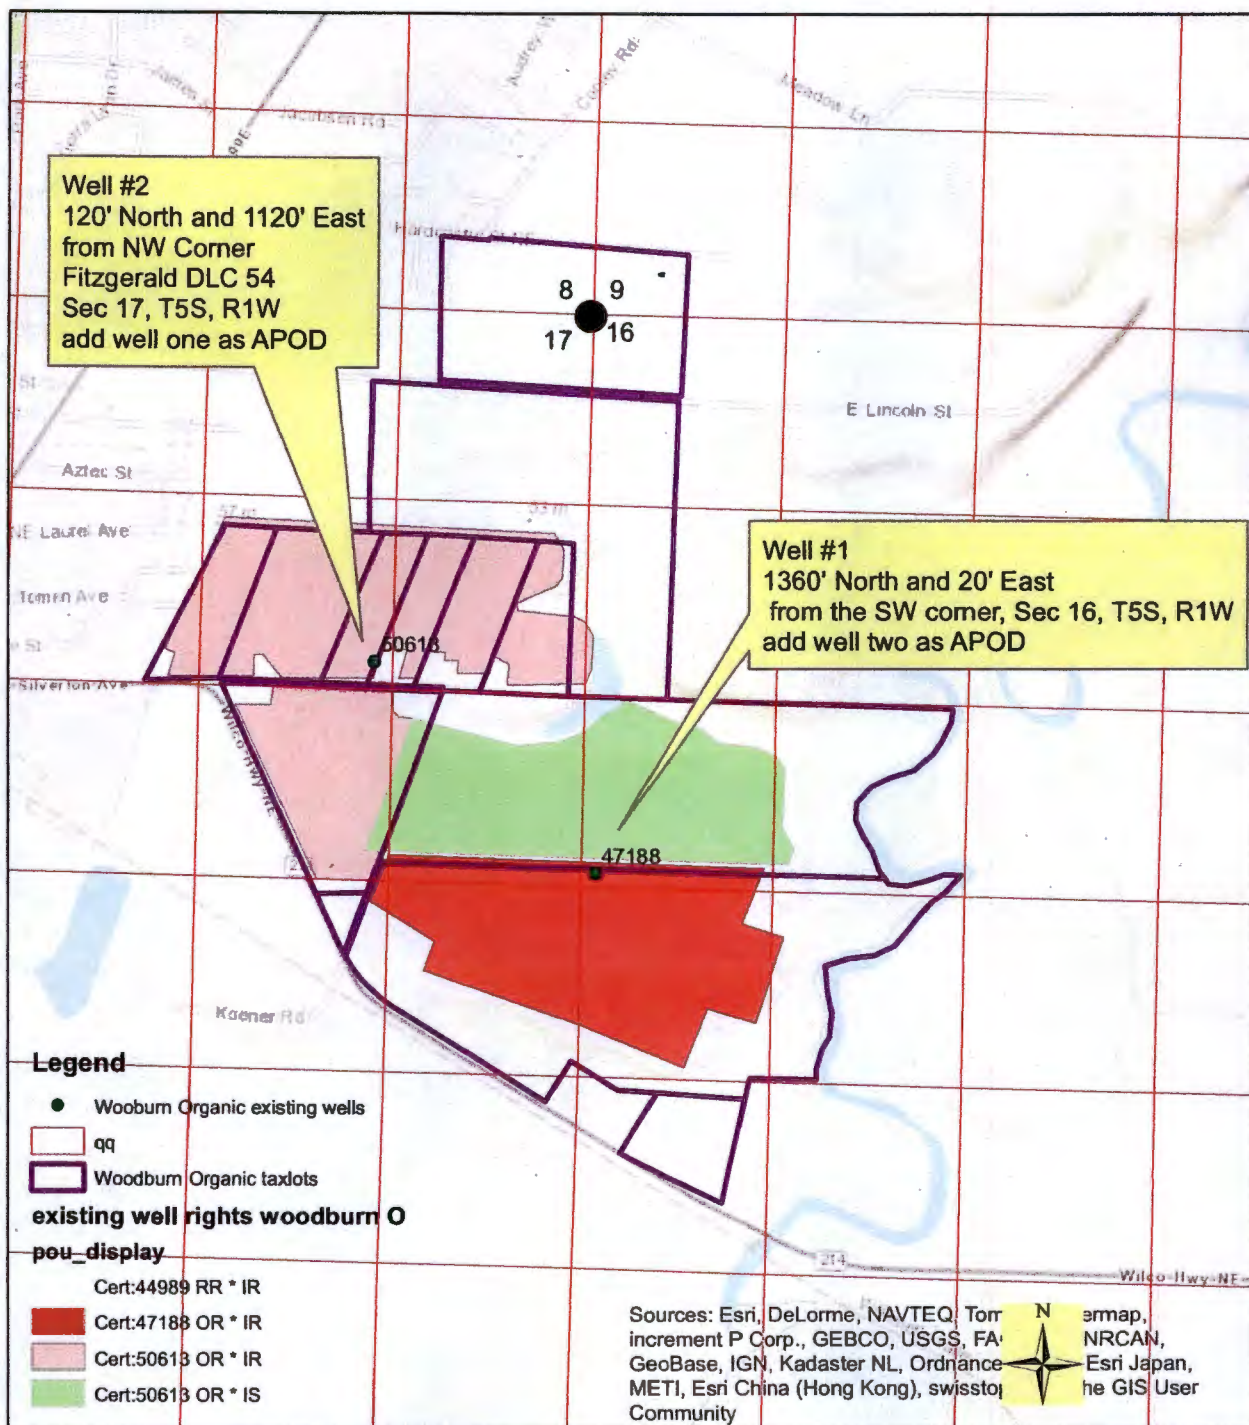

0 330 660 1,320 Feet

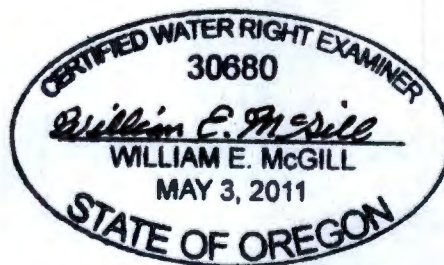

EXPIRES: 12/31/2016

RECEIVED

FEB 20 2015

WATER RESOURCES DEPT
 SALEM, OREGON

T 11984