


Halls Ferry Farms GR 1514 Modification new POA

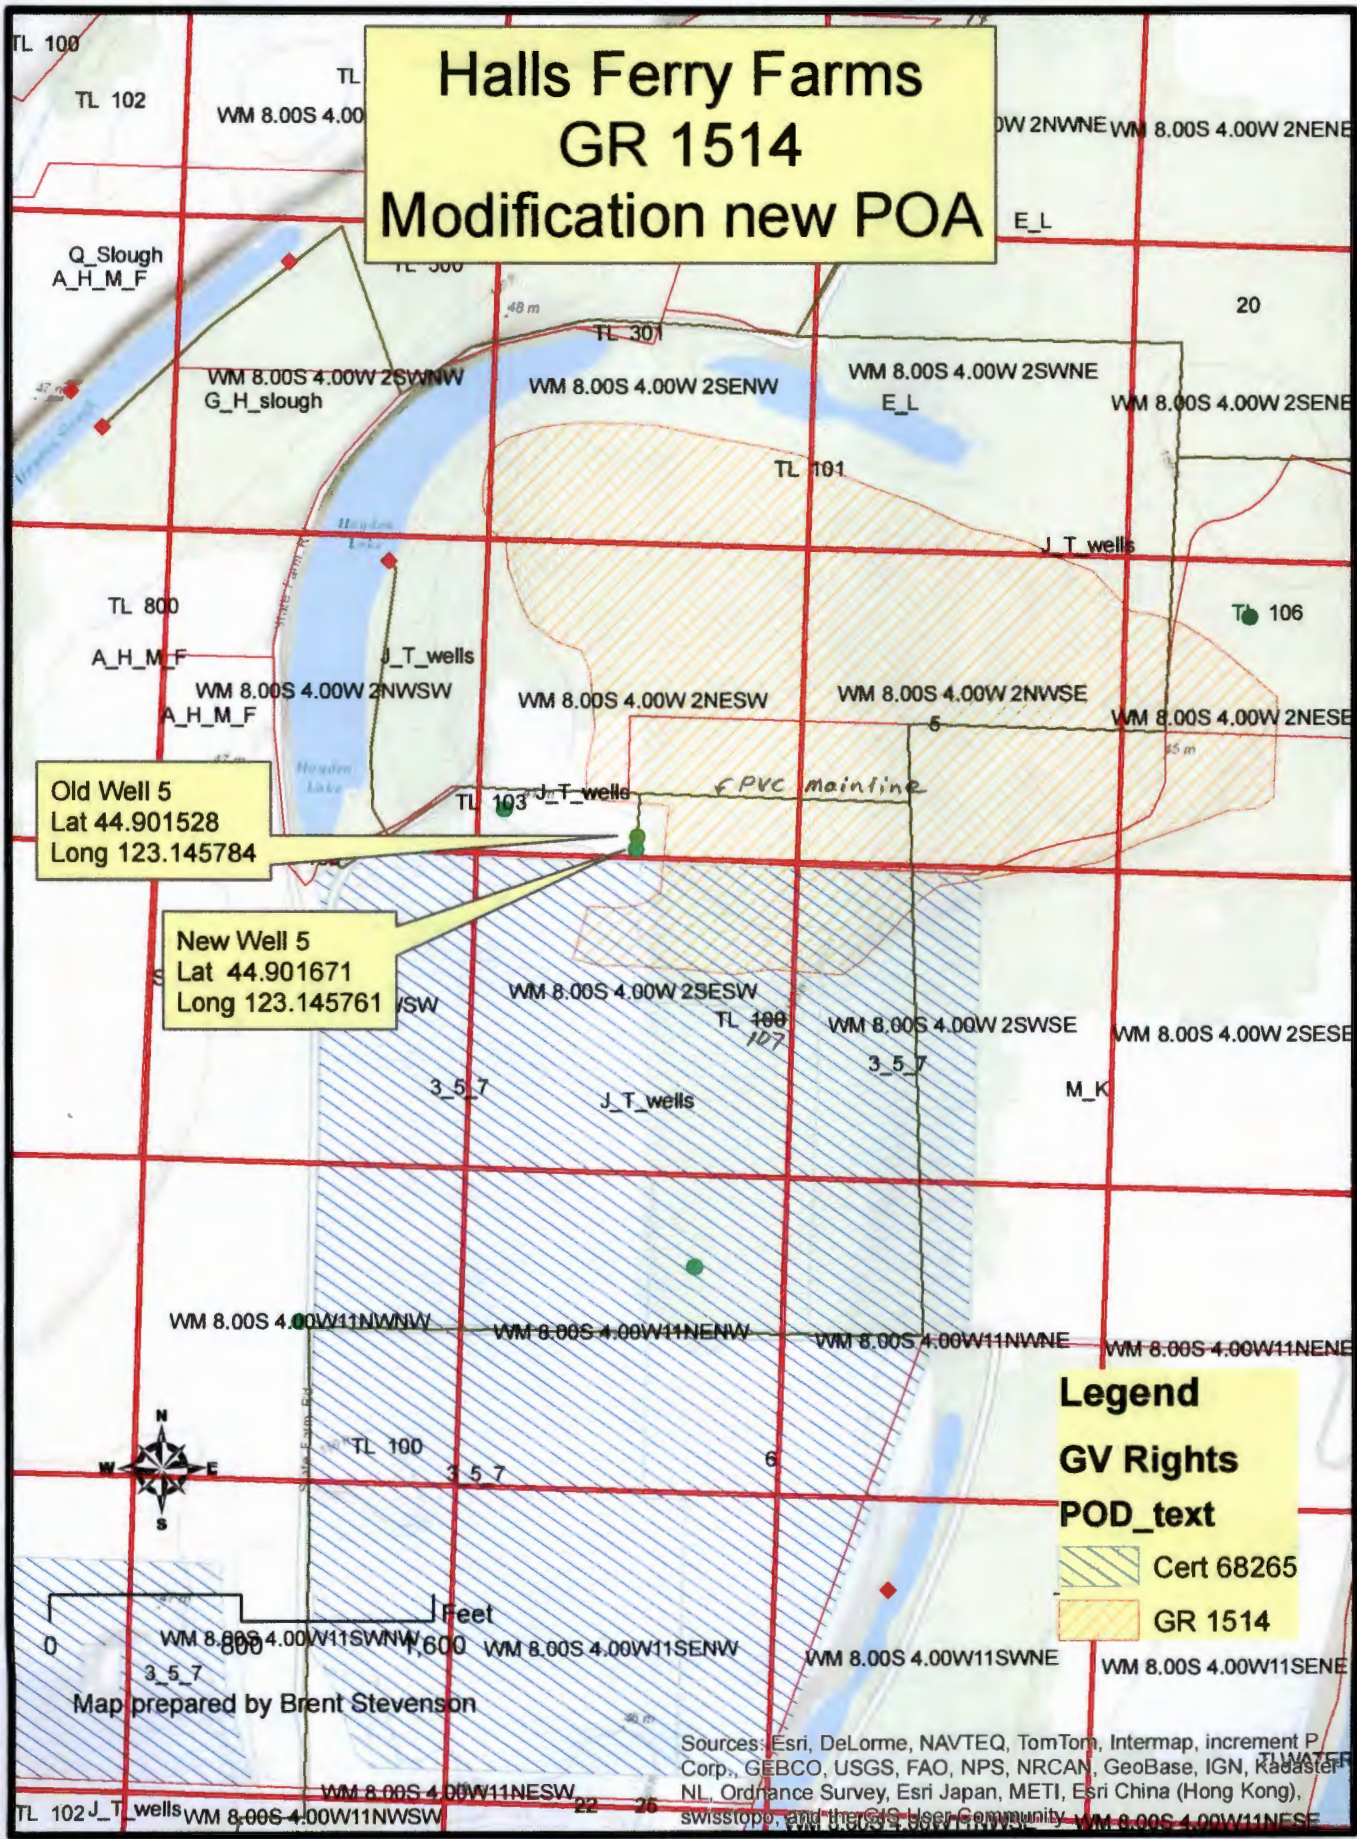


Old Well 5
Lat 44.901528
Long 123.145784

New Well 5
Lat 44.901671
Long 123.145761

Legend
GV Rights
POD_text
Cert 68265
GR 1514

Map prepared by Brent Stevenson

Sources: Esri, DeLorme, NAVTEQ, TomTom, Intermap, increment P Corp., GEBCO, USGS, FAO, NPS, NRCAN, GeoBase, IGN, Kadaster NL, Ordnance Survey, Esri Japan, METI, Esri China (Hong Kong), swisstopo, and the GIS User Community

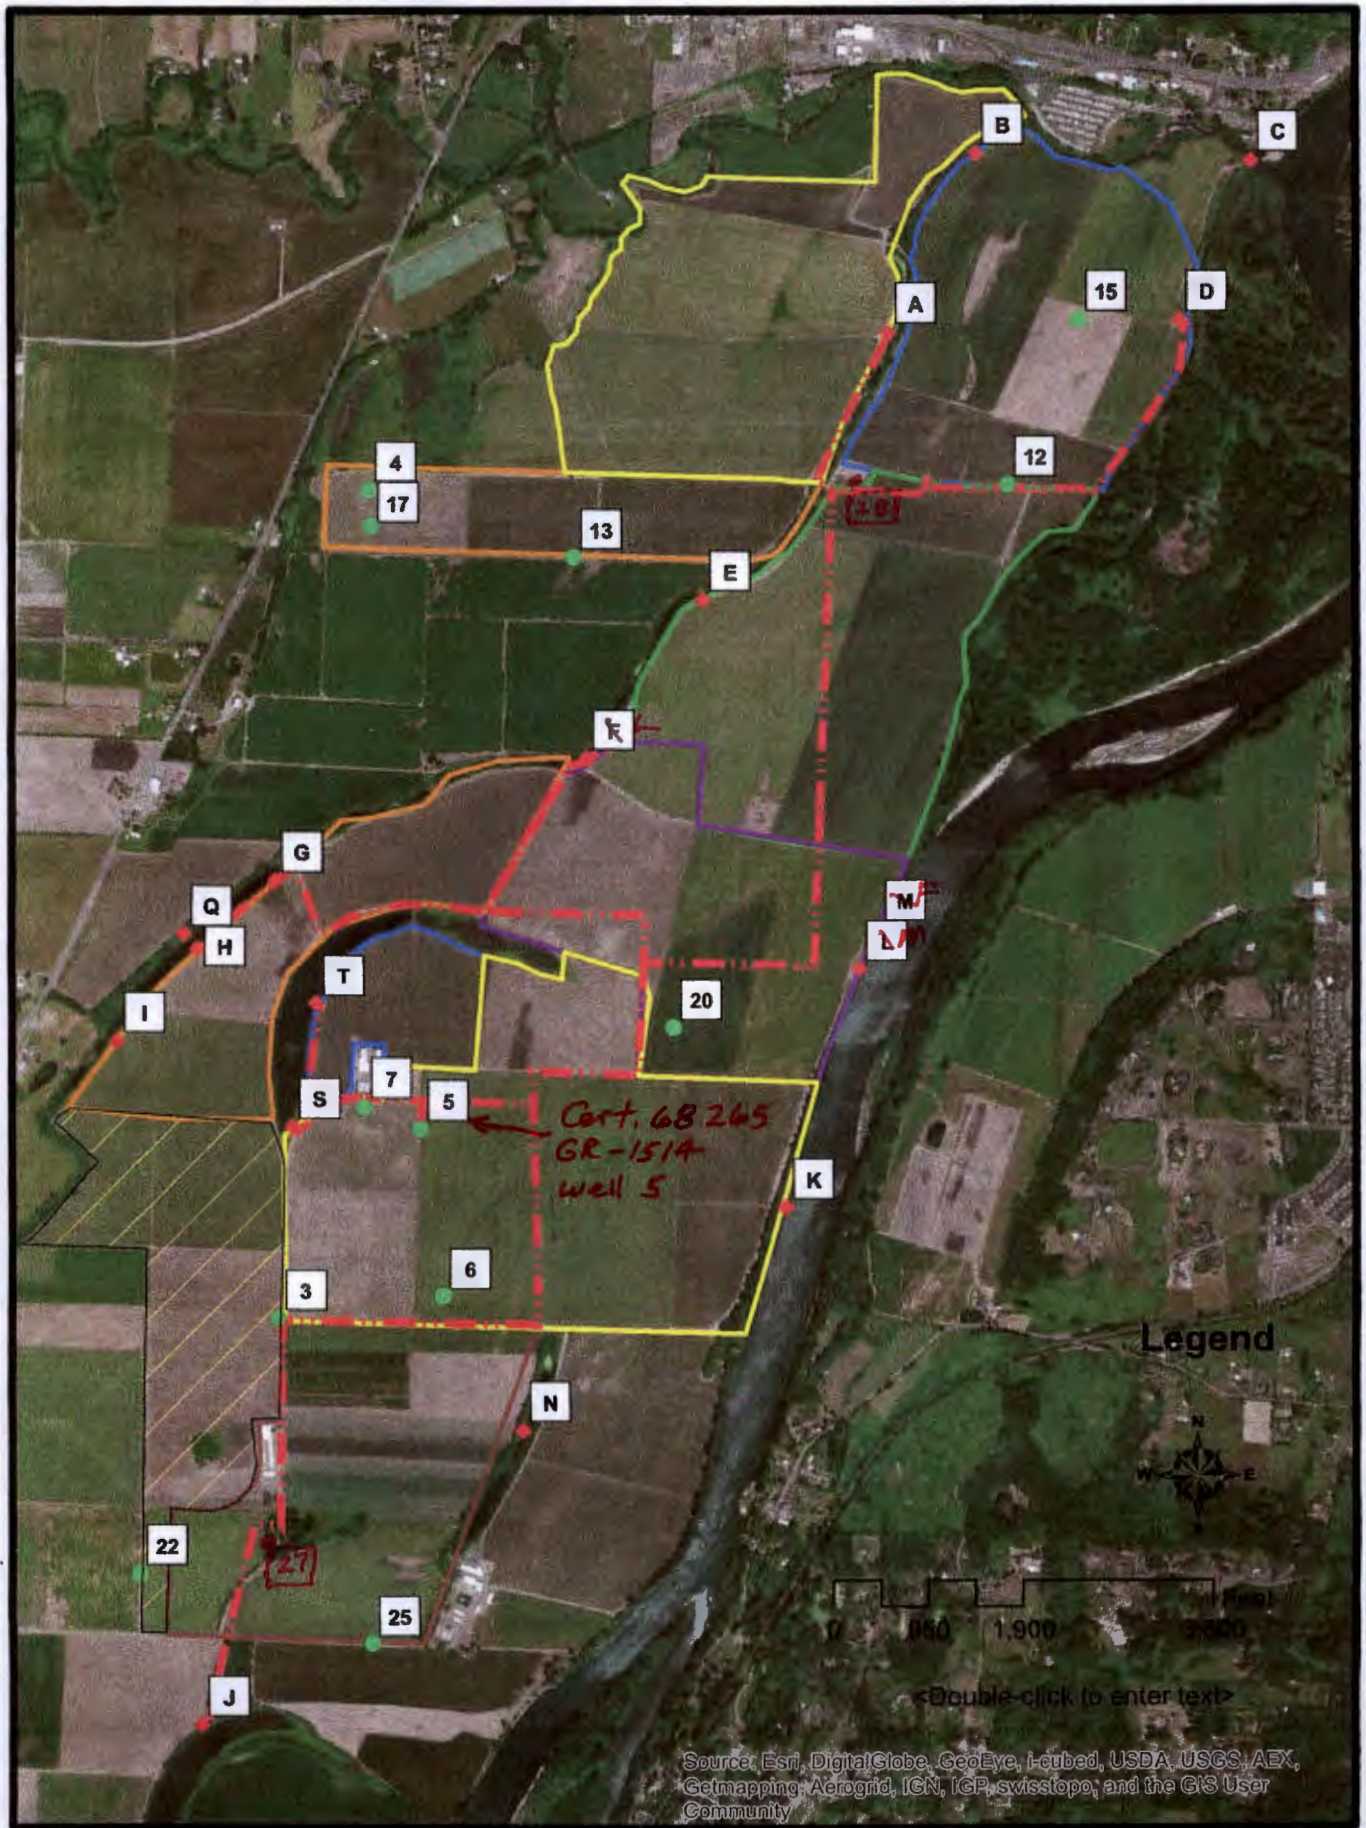

T 12035