
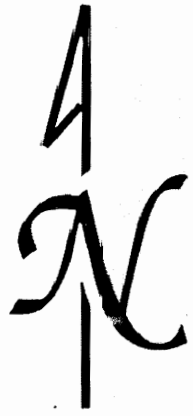



SECTION 36 T4S R4W W.M.
YAMHILL COUNTY

SEE MAP 4 4 25

THIS MAP WAS PREPARED FOR
ASSESSMENT PURPOSE ONLY

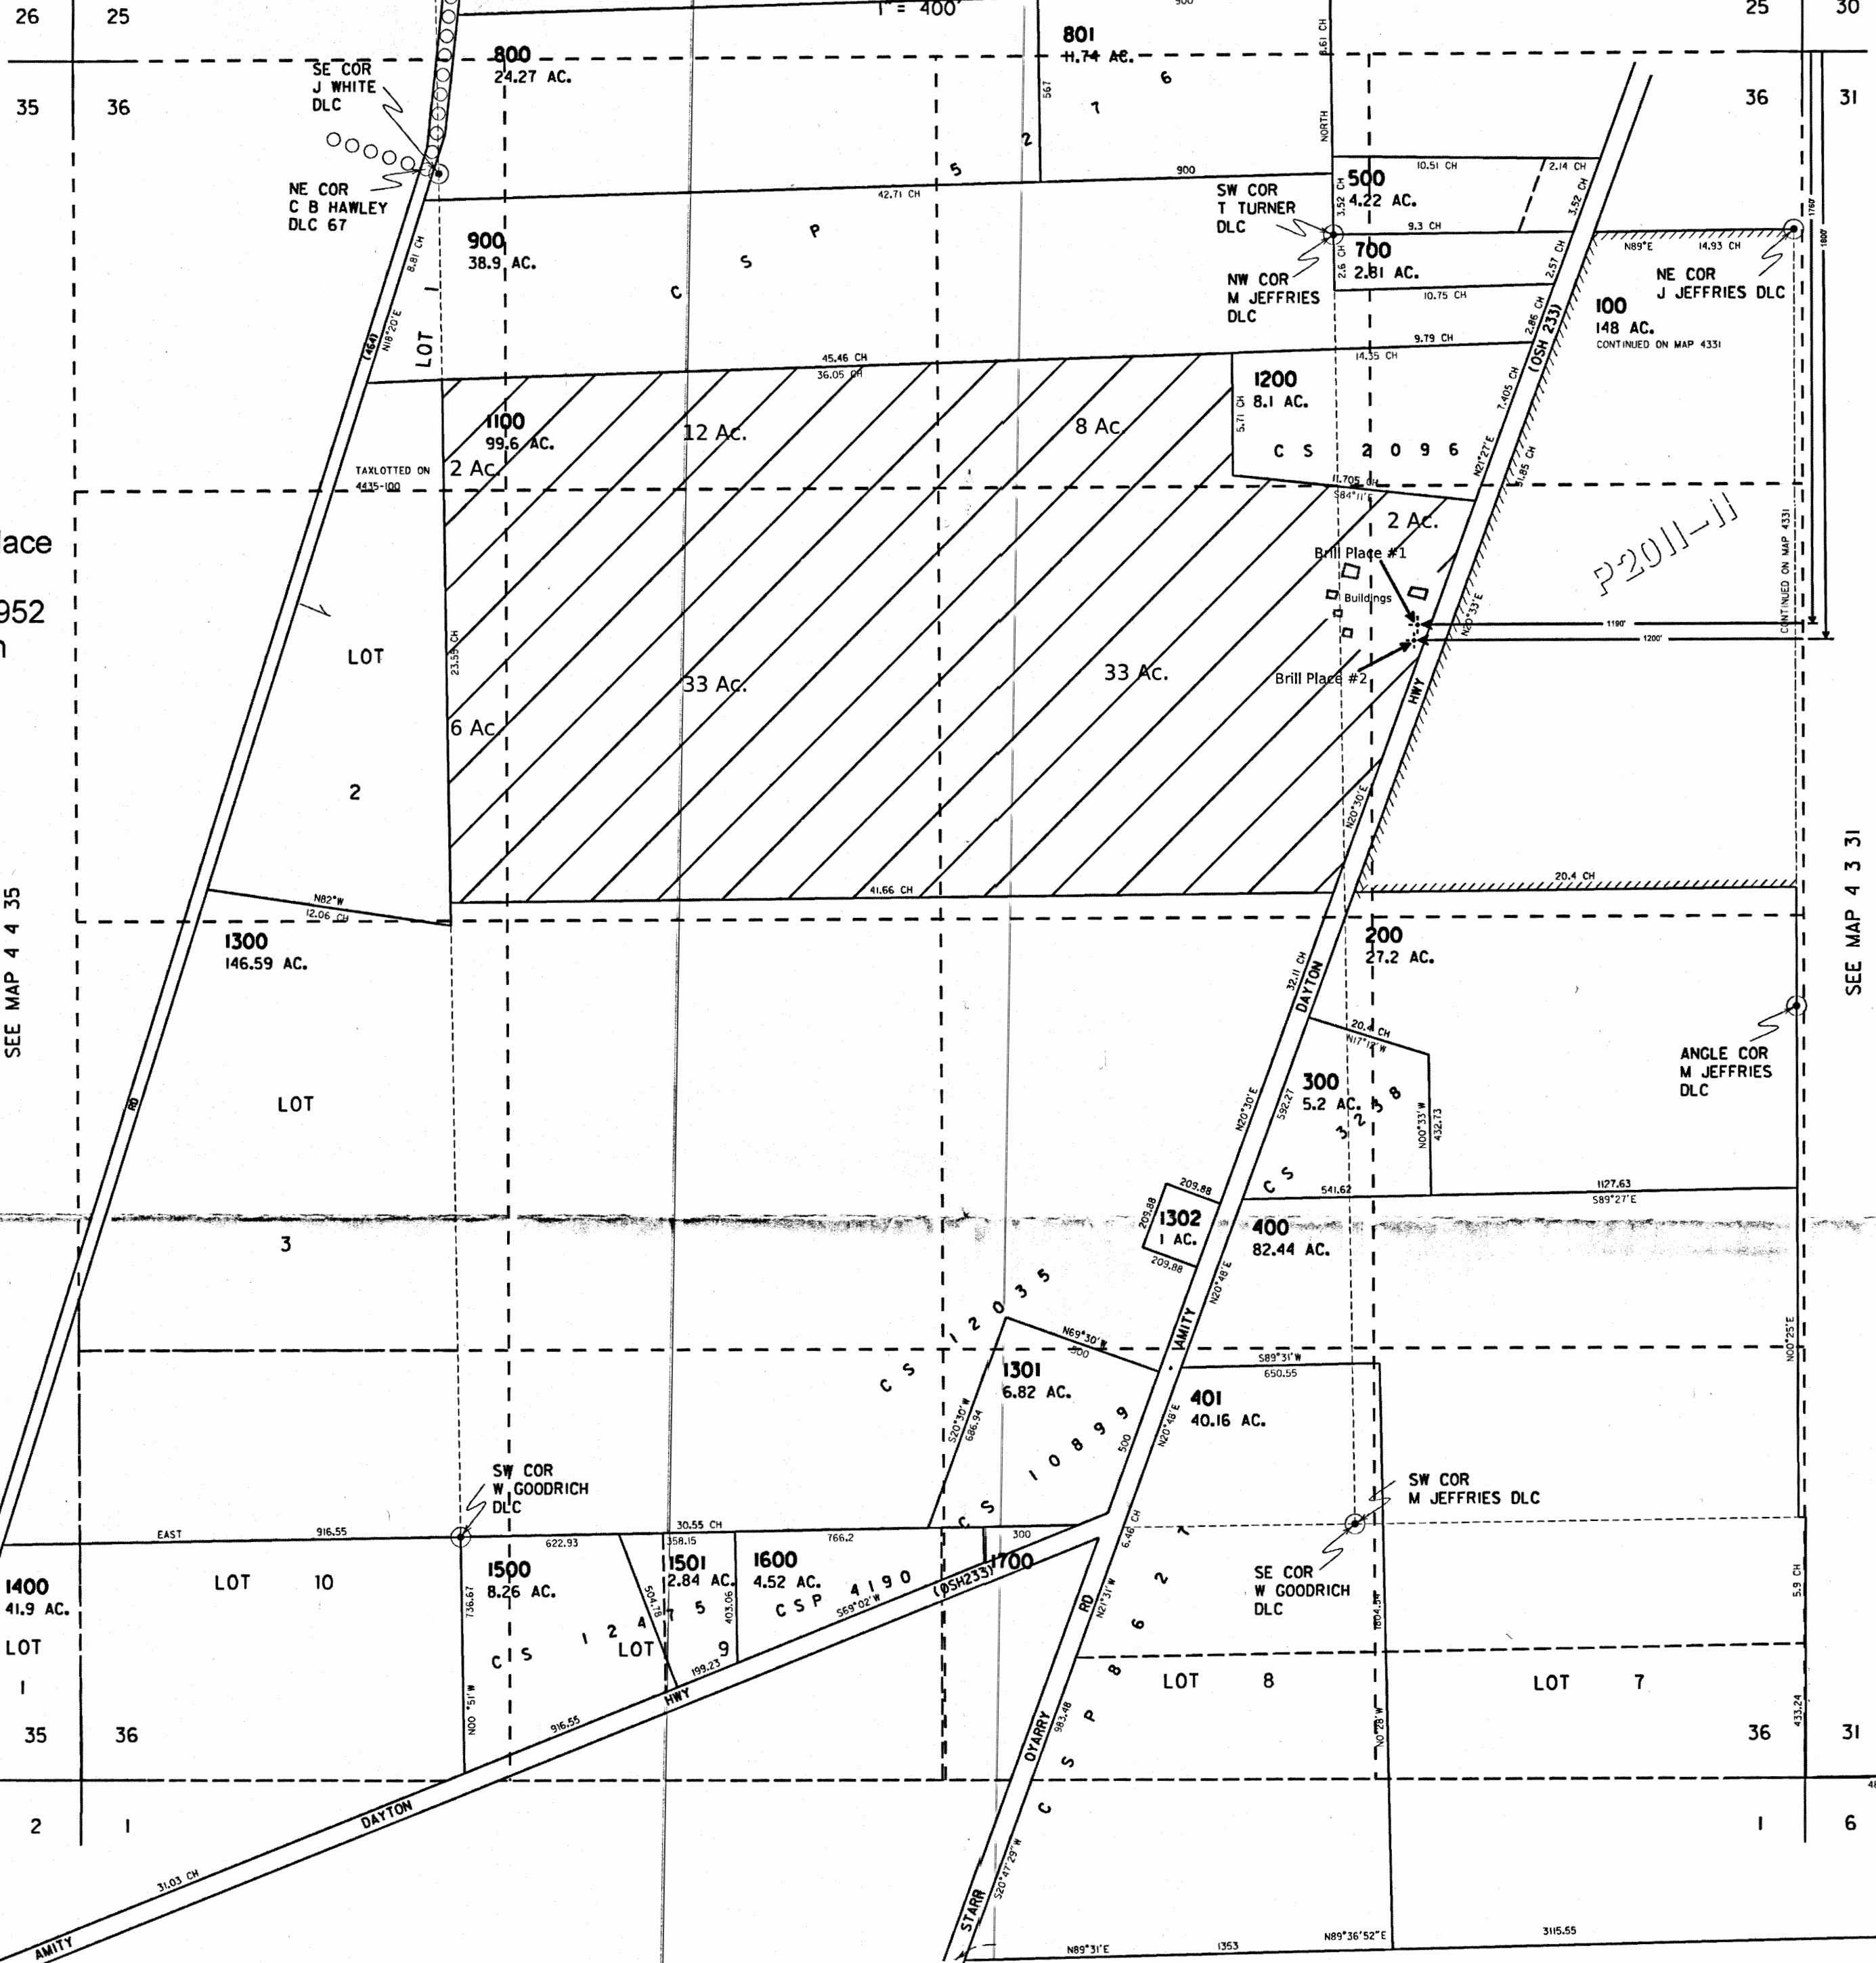

Legend

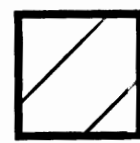

Claim GR-980 Place
of Use
Priority: 10/27/1952
Use: Irrigation

CANCELLED
600
1000 REF

SEE MAP 4 3 31

SEE MAP 4 4 35

T 12045

SEE MAP 5 4 01

RECEIVED

APR 21 2015

WATER RESOURCES DEPT
SALEM, OREGON

REVISED 6-6-11 SB


THIS MAP WAS PREPARED FOR ASSESSMENT PURPOSE ONLY


SECTION 36 T4S R4W W.M. YAMHILL COUNTY

SEE MAP 4 4 25



Legend

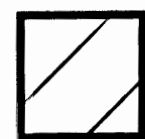 Claim GR-980 Place of Use
Priority: 10/27/1952
Use: Irrigation

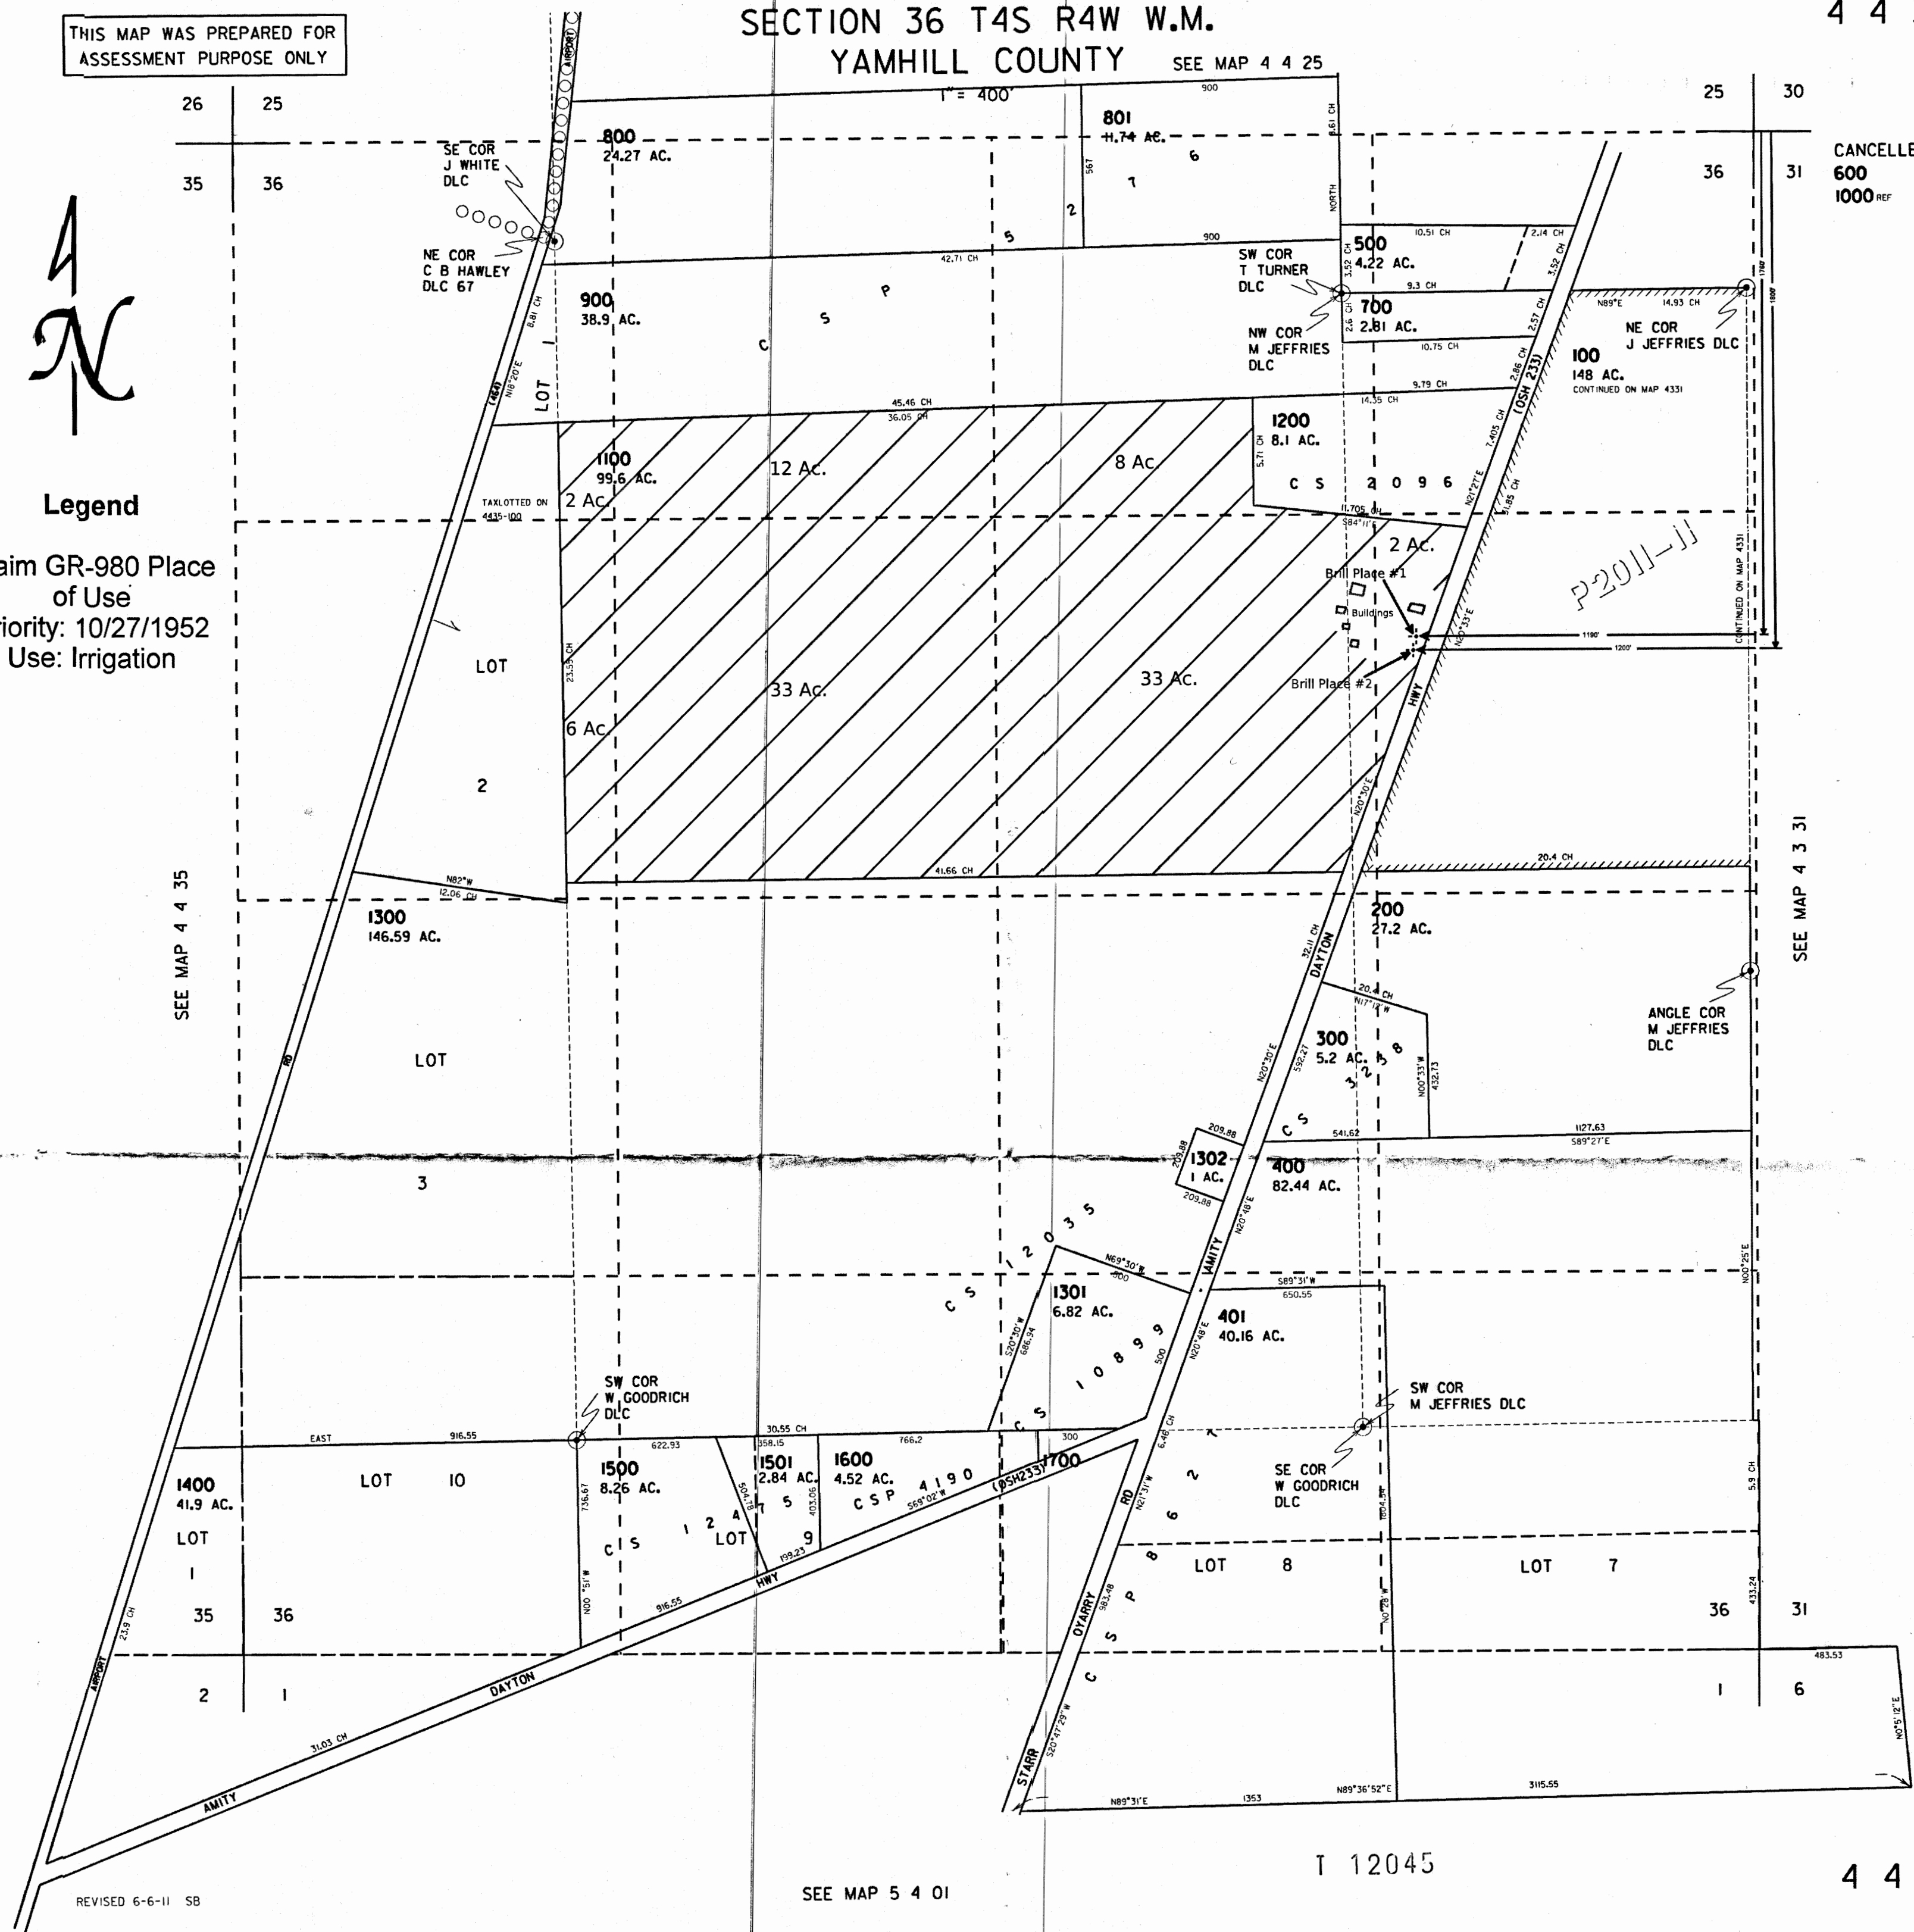

CANCELLED
600
1000 REF

SEE MAP 4 3 31

SEE MAP 4 4 35

RECEIVED
APR 21 2015
WATER RESOURCES DEPT
SALEM, OREGON

SEE MAP 5 4 01

T 12045