


OWNER: Terra Renovatio I, LLC

1 N 42

Certificate
79795

Transfer Application Map

RANGE E
POO 1

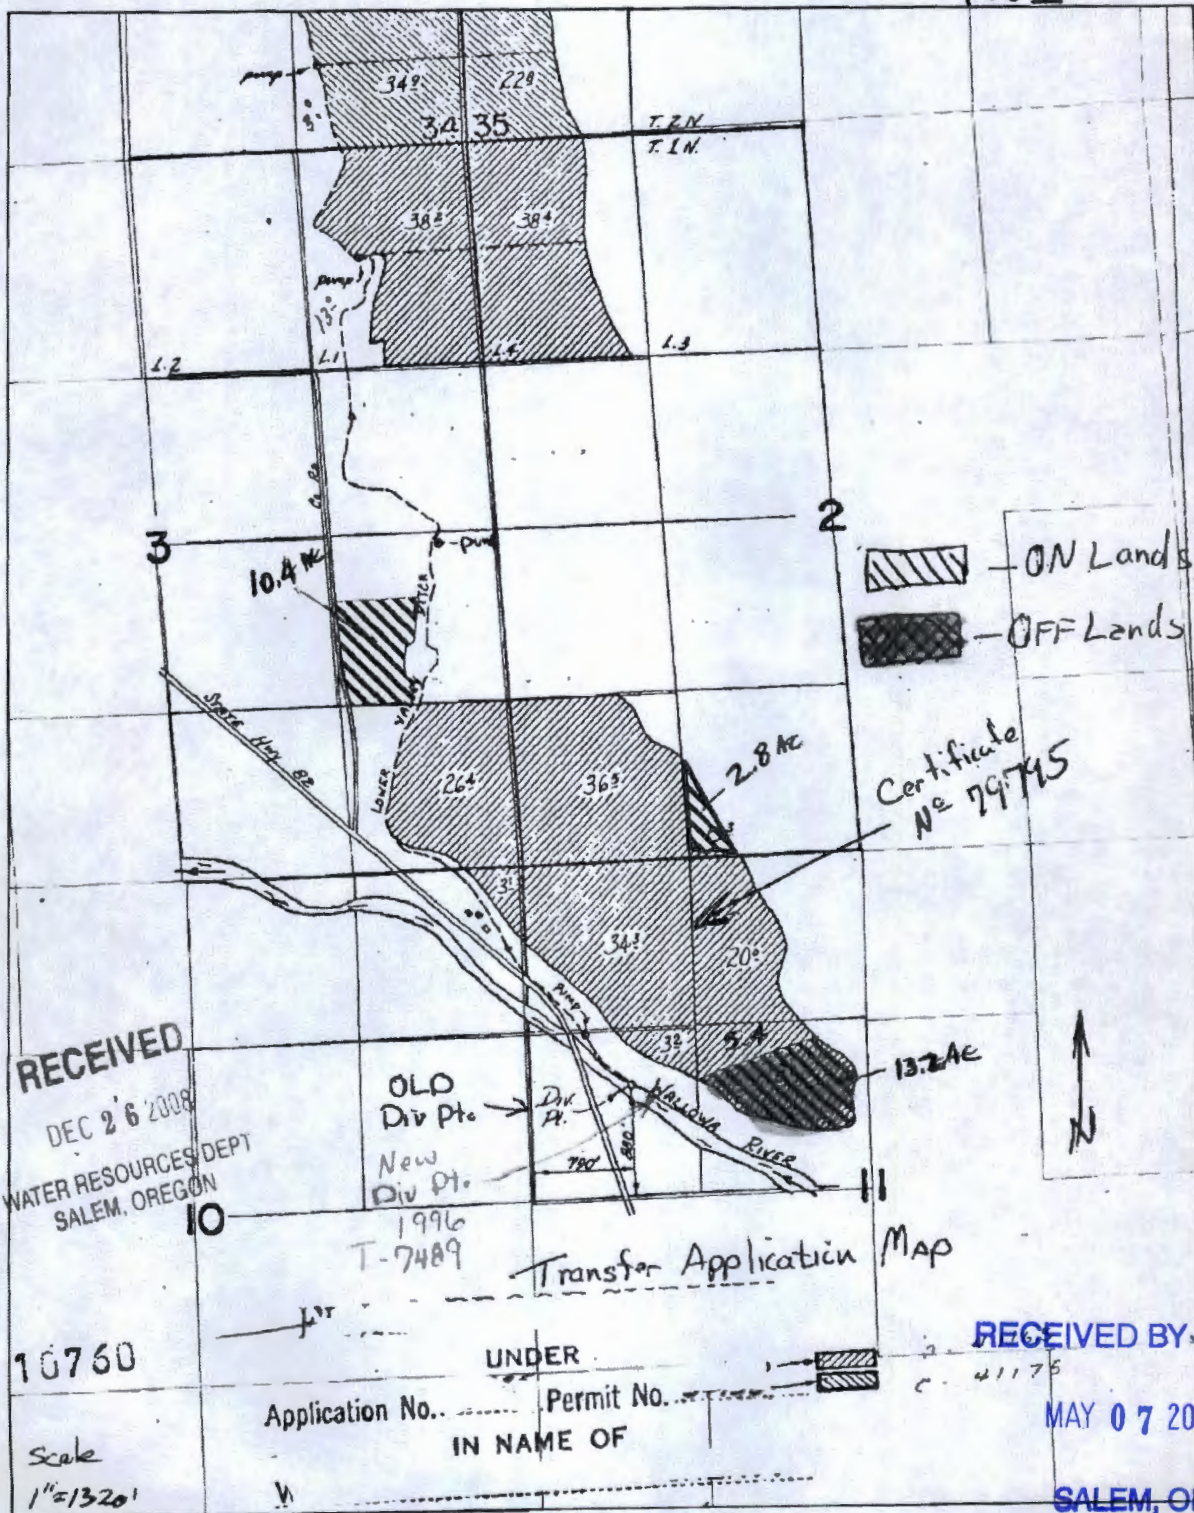

RECEIVED
 DEC 26 2008
 WATER RESOURCES DEPT
 SALEM, OREGON

Certificate
 No 79795

RECEIVED BY OWRD
 MAY 07 2015
 SALEM, OR

T 10760

Scale
1"=1320'


Application No. _____ Permit No. _____
 UNDER _____
 IN NAME OF _____

TRANSFER REQUEST YEARS: 2015-2020
 Tax Lot 803 (see separate map)

T 12054

DIVISION 0126

County Assessor Map

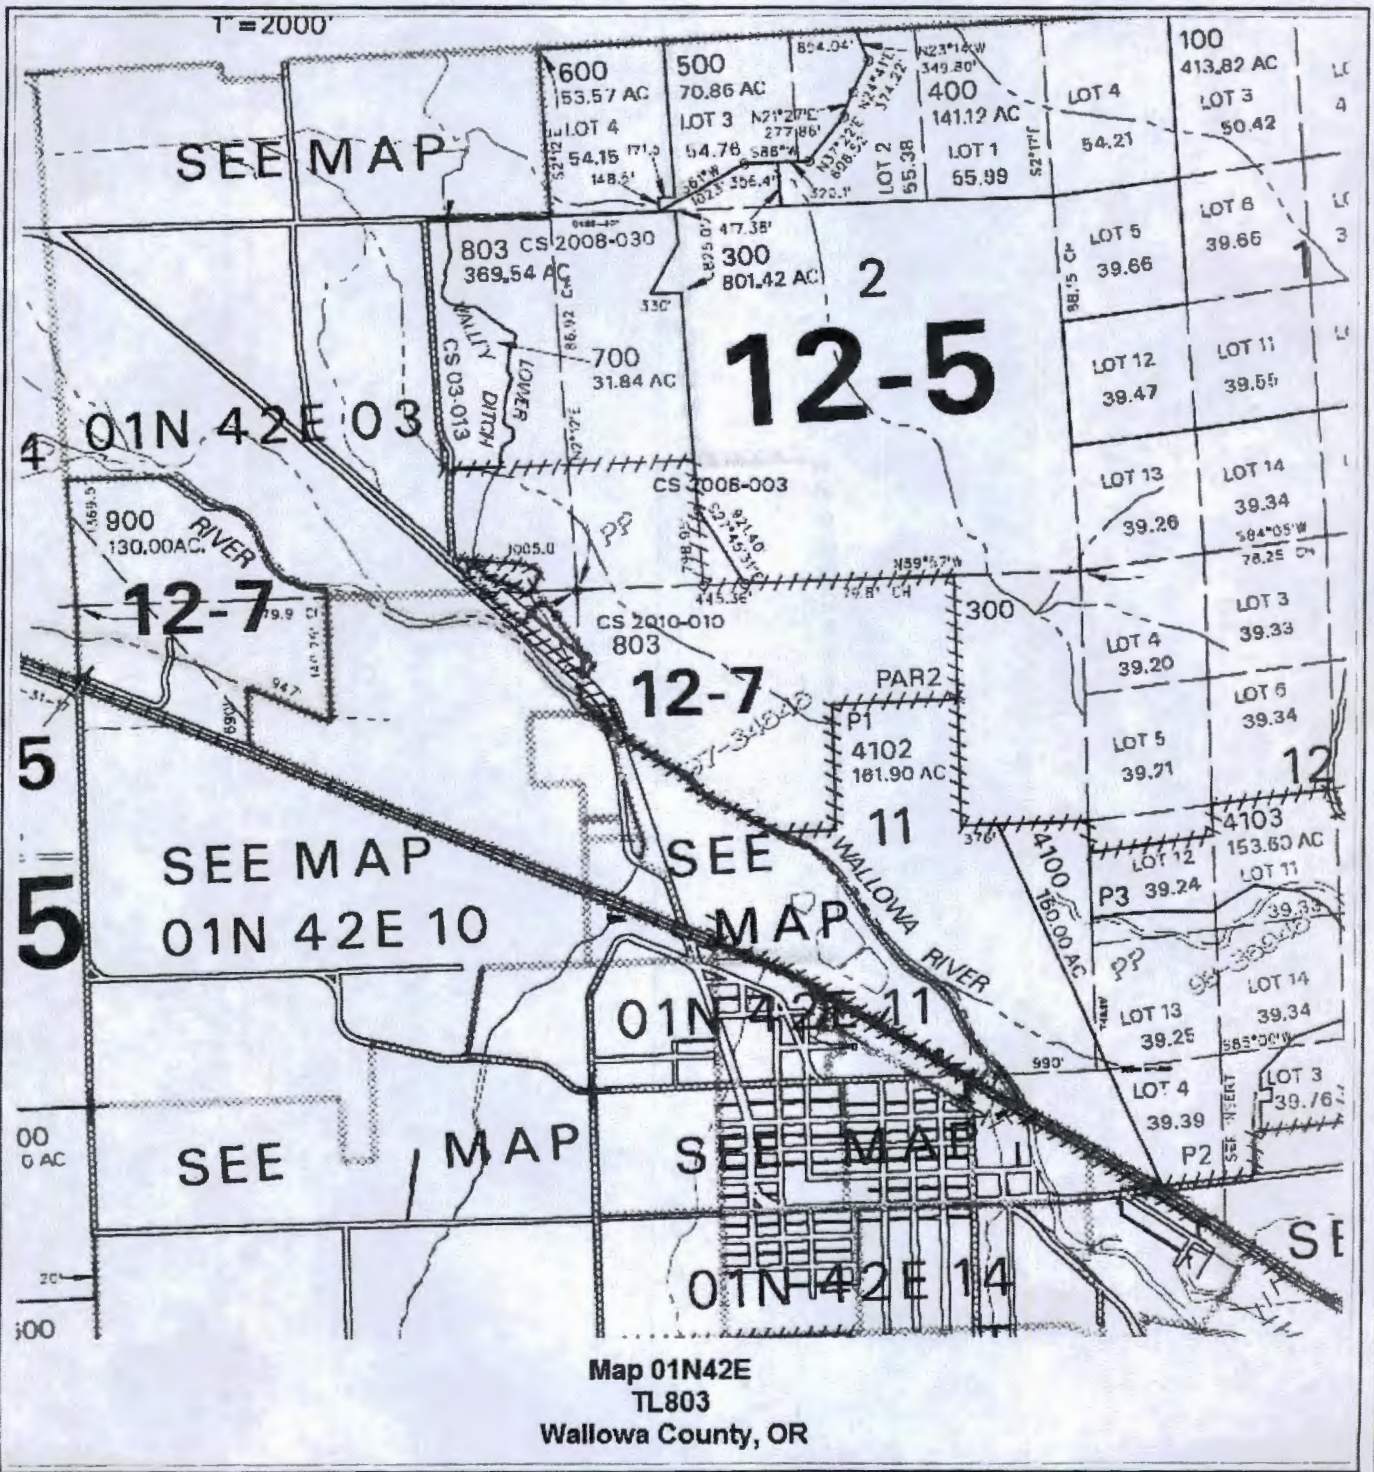

Map 01N42E
TL803
Wallowa County, OR

MAY 07 2015

SALEM, OR

T 12054