


MAP TO ADD POA TO C*90309 T23 S, R 30 E, WM

26

25

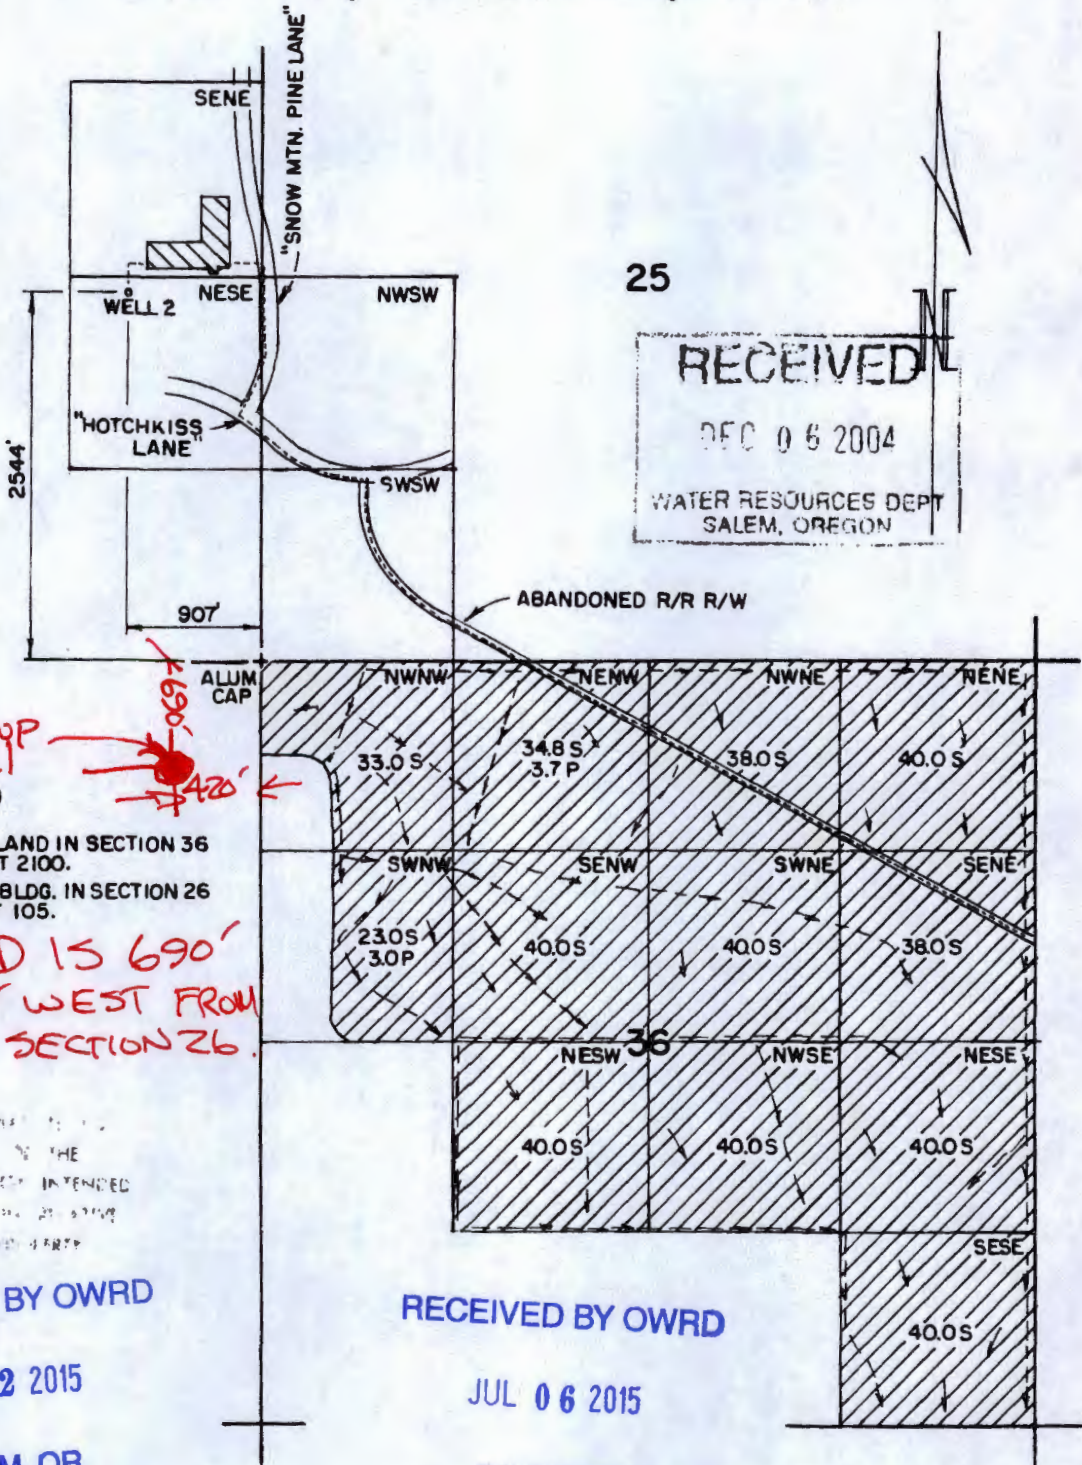

RECEIVED
DEC 06 2004
WATER RESOURCES DEPT
SALEM, OREGON

Glerop well

- LEGEND
- IRRIGATED LAND IN SECTION 36 IS IN TAX LOT 2100.
 - INDUSTRIAL BLDG. IN SECTION 26 IS IN TAX LOT 105.

POA PROPOSED IS 690' SOUTH & 420' WEST FROM THE NE COR SECTION 26.


RECEIVED BY OWRD


JUN 22 2015

SALEM, OR

RECEIVED BY OWRD

JUL 06 2015

SALEM, OR

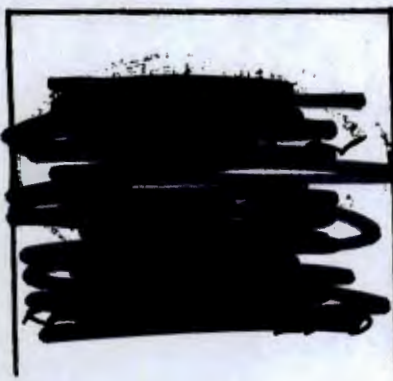

FINAL PROOF SURVEY

UNDER APPLICATION G-14645 PERMIT G-13485

T 12096

IN THE NAME OF MONACO COACH CORPORATION WILLIAM & LORI PEILA

Scale: 4" = 1 MILE	Date: NOV. 2004	Job: 2200
Dsn:	M.A. PALMER & SONS, INC. ENGINEERING & SURVEYING 711 Ponderosa Village • Box 61 Burns, Oregon 97720	Sht. No.
Drn: CHRIS		of 1
Ckd:		