


T.5S. R.4W. Section 7, W.M.

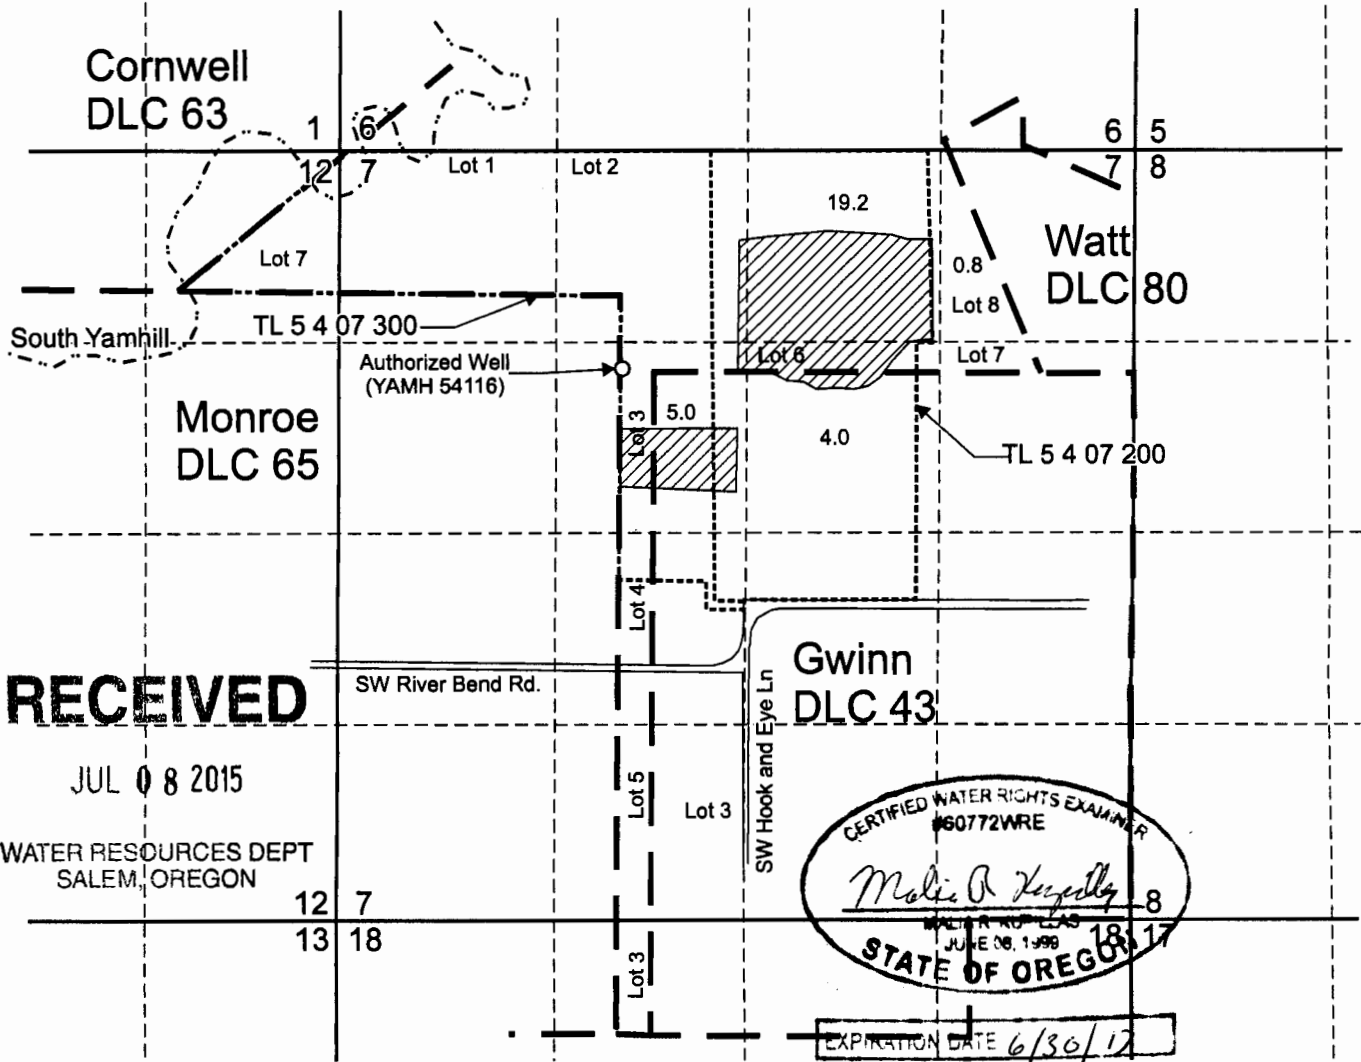

RECEIVED
 JUL 08 2015
 WATER RESOURCES DEPT
 SALEM, OREGON

CERTIFIED WATER RIGHTS EXAMINER
 #60772WRE
 STATE OF OREGON
 EXPIRATION DATE 6/30/12

Authorized Well (YAMH 54116) is located 1,500 feet south and 1,925 feet east from the NW corner, Section 7.

"From" Area (29.0 acres) to be amended, Application G-15846, Permit G-17338, priority 10-3-2002.

Tax lot boundary

Donation Land Claim boundary

NOTE: The distribution of acres by quarter-quarter on the "From" map was generated using the most current and accurate data and corrects erroneously distributed acres on the permit and permit map. The description of acres by quarter-quarter on the "From" map reflects the same description as the permit map but the distribution has been corrected. The footprint of the permit map conforms to the general shapes of the subject tax lot, being 5S 4W TL 200. Additionally, neither Permit G-17338 nor the "From" map describe acres by DLC.

Scale: 1" = 1,320'



This map was prepared for the purpose of identifying the location of a water right only and is not intended to provide legal dimensions or location of property ownership lines.



**Permit Amendment "From" Map
 Application G-15846, Permit G-17338**

Willamette Valley Land LLC
 T.5S. R.4W. Section 7, W.M.

Pacific Hydro-Geology Inc.


06/2015

Page 1 of 2


HandgenPAMap.cdr

T 12099

T.5S. R.4W. Section 7, W.M.

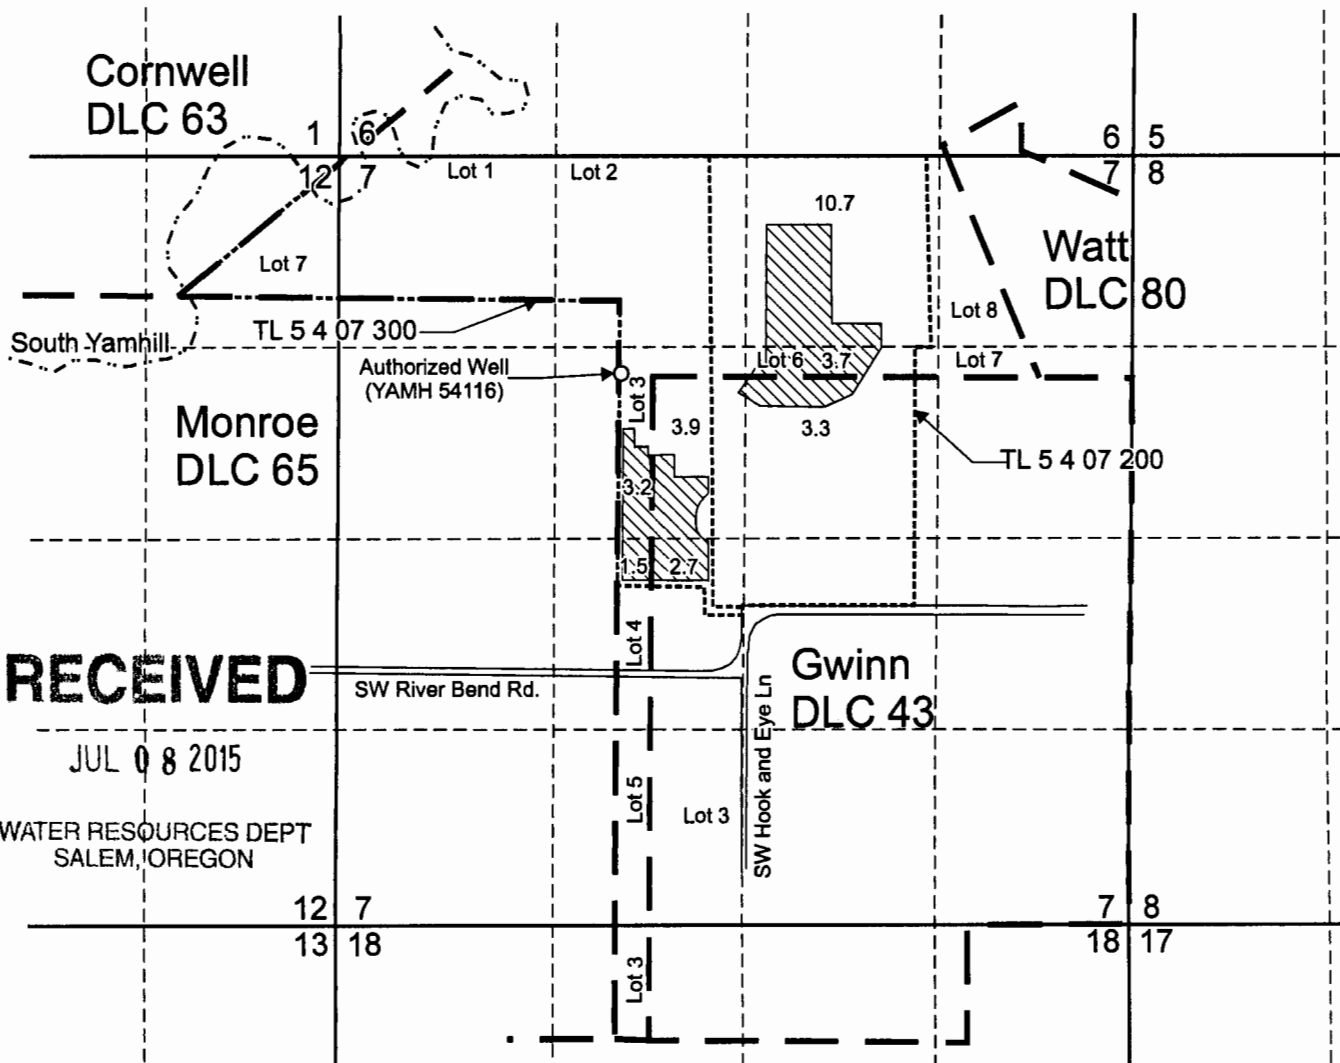

Authorized Well (YAMH 54116) is located 1,500 feet south and 1,925 feet east from the NW corner, Section 7.

 Amended "To" Area (29.0 acres) to be irrigated under Application G-15846, Permit G-17338, priority 10-2-2002.


 Tax lot boundary

 Donation Land Claim boundary




Scale: 1" = 1,320'

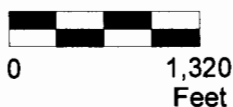

This map was prepared for the purpose of identifying the location of a water right only and is not intended to provide legal dimensions or location of property ownership lines.



Permit Amendment "To" Map

Willamette Valley Land LLC
T.5S. R.4W. Section 7, W.M.

Pacific Hydro-Geology Inc.

06/2015

Page 2 of 2

HandgenPAMap.cdr

T 12099