


1950 Priority "TO"
1969 Priority "FROM"

T. 9 S. R. 5 W. W.M.

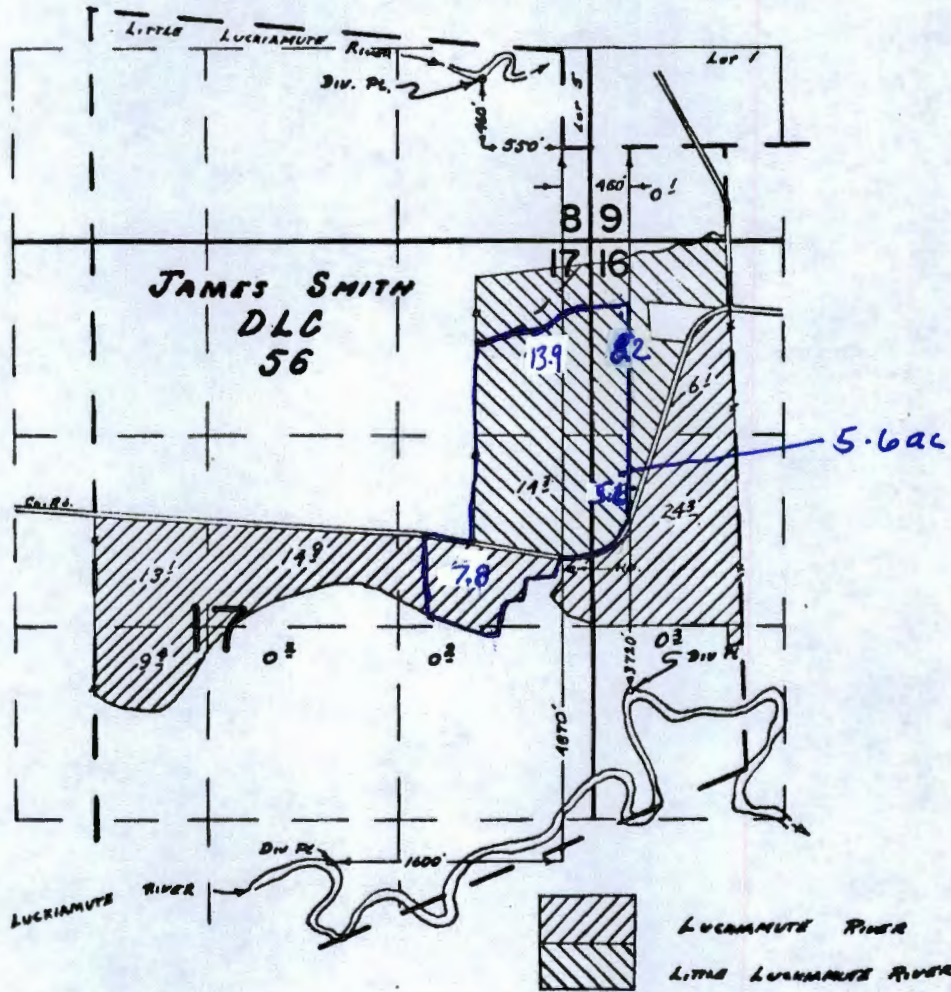

FINAL PROOF SURVEY
UNDER

RECEIVED

AUG 19 2015

Application No. 46036 Permit No. 34380
IN NAME OF
C. A. TWISS


WATER RESOURCES DEPT
SALEM, OREGON

Surveyed MAR. 16 1973, by R. B. MUEHLEN

T 12139

Prevalence of use
Imagery July 2014

Legend

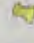 44.7874899369, -123.3205641258

Smith Rd

Elkins Rd

 44.7874899369, -123.3205641258

RECEIVED

AUG 19 2015

WATER RESOURCES DEPT
SALEM, OREGON

T 12130

Google earth

3000 ft. Mason Rd

