


FROM
CERT 14510

RECEIVED

T. 3 S., R. 1 W. W.M.

SEP 01 2015

WATER RESOURCES DEPT
SALEM, OREGON

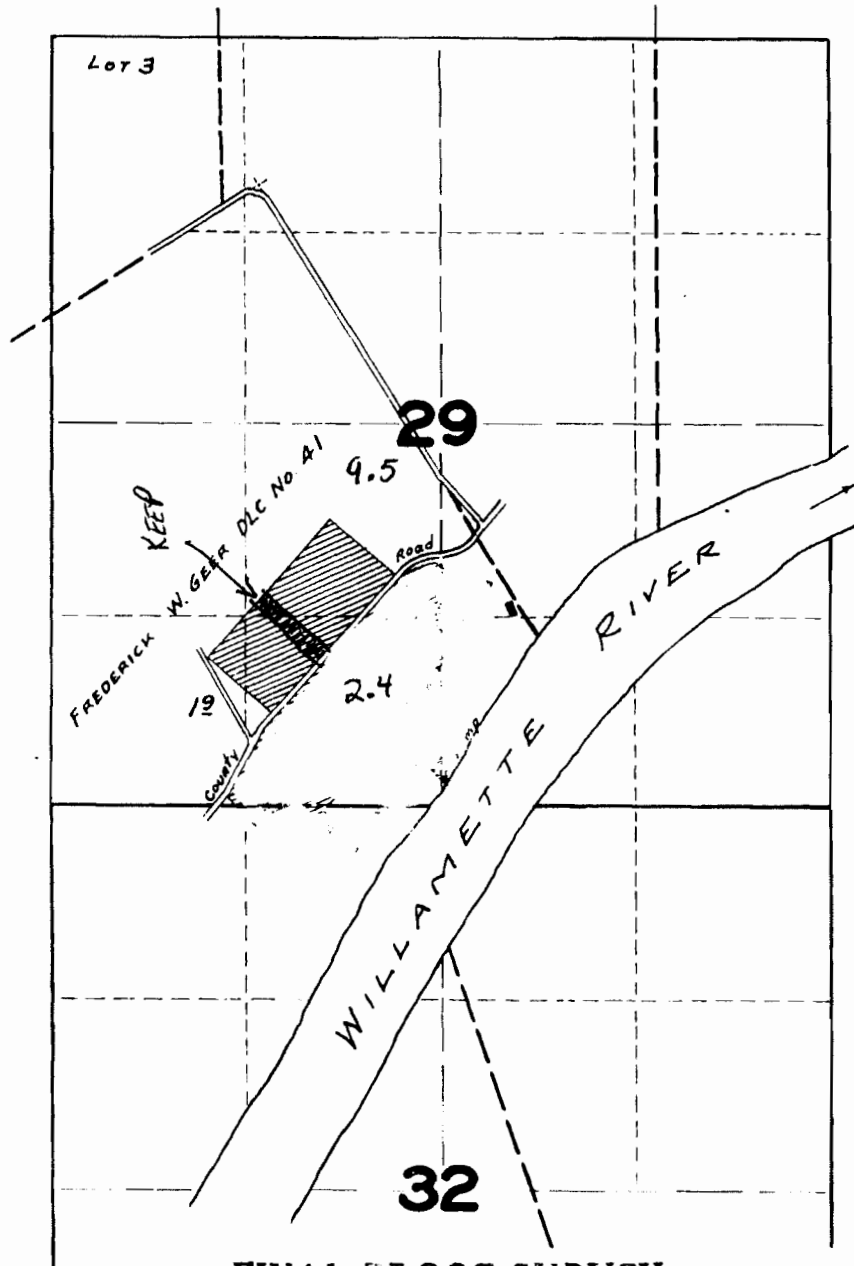

**FINAL PROOF SURVEY
UNDER**

Application No. 19099 Permit No. 14706

IN FAVOR OF

Grace N. Williams

Surveyed Aug 1, 1942, by Geoff Madernan

1" = 1320'

T 12152


FROM
CERT 34116

RECEIVED

T.3S.R.1W.W.M.

SEP 01 2015

WATER RESOURCES DEPT
SALEM, OREGON

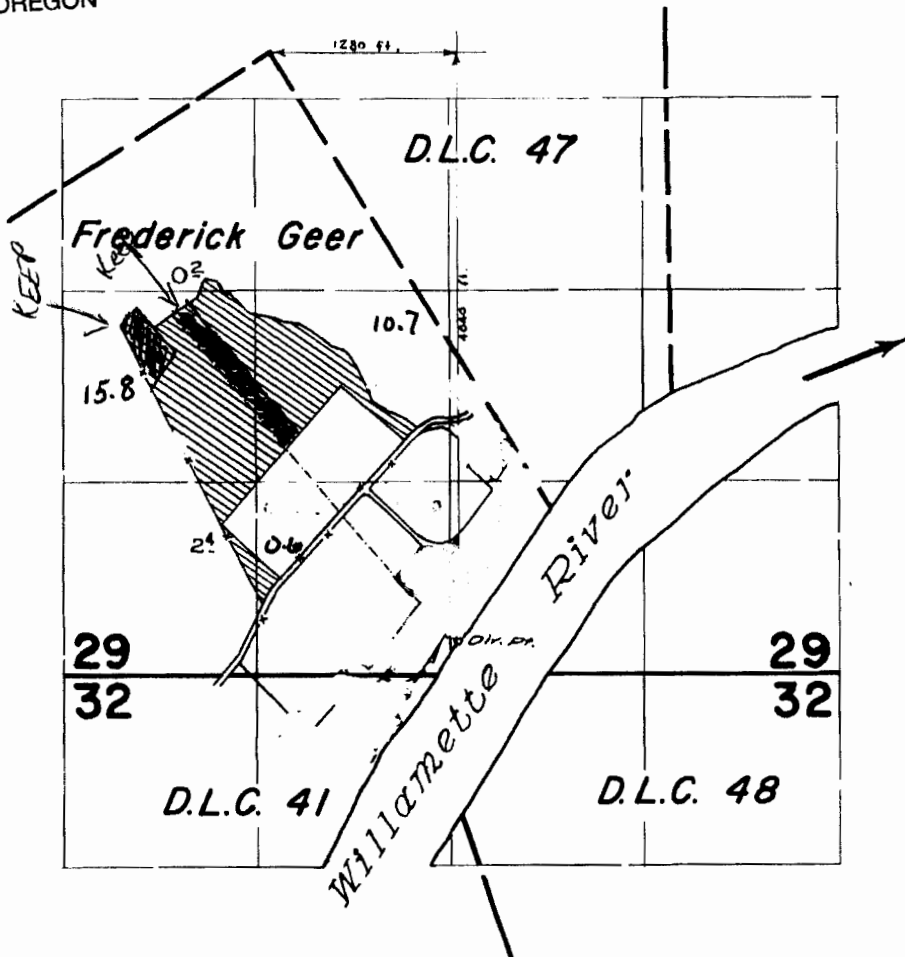

FINAL PROOF SURVEY
UNDER

Application No. 40300 Permit No. 30058
IN NAME OF

JAMES McDONALD

Surveyed August 20 1965, by


A. Jackson

1" = 1320'

T 12152

T 3 S RIW
SEC 29, 30, 31, 32

RECEIVED
SEP 0 1 2015
WATER RESOURCES DEPT
SALEM, OREGON

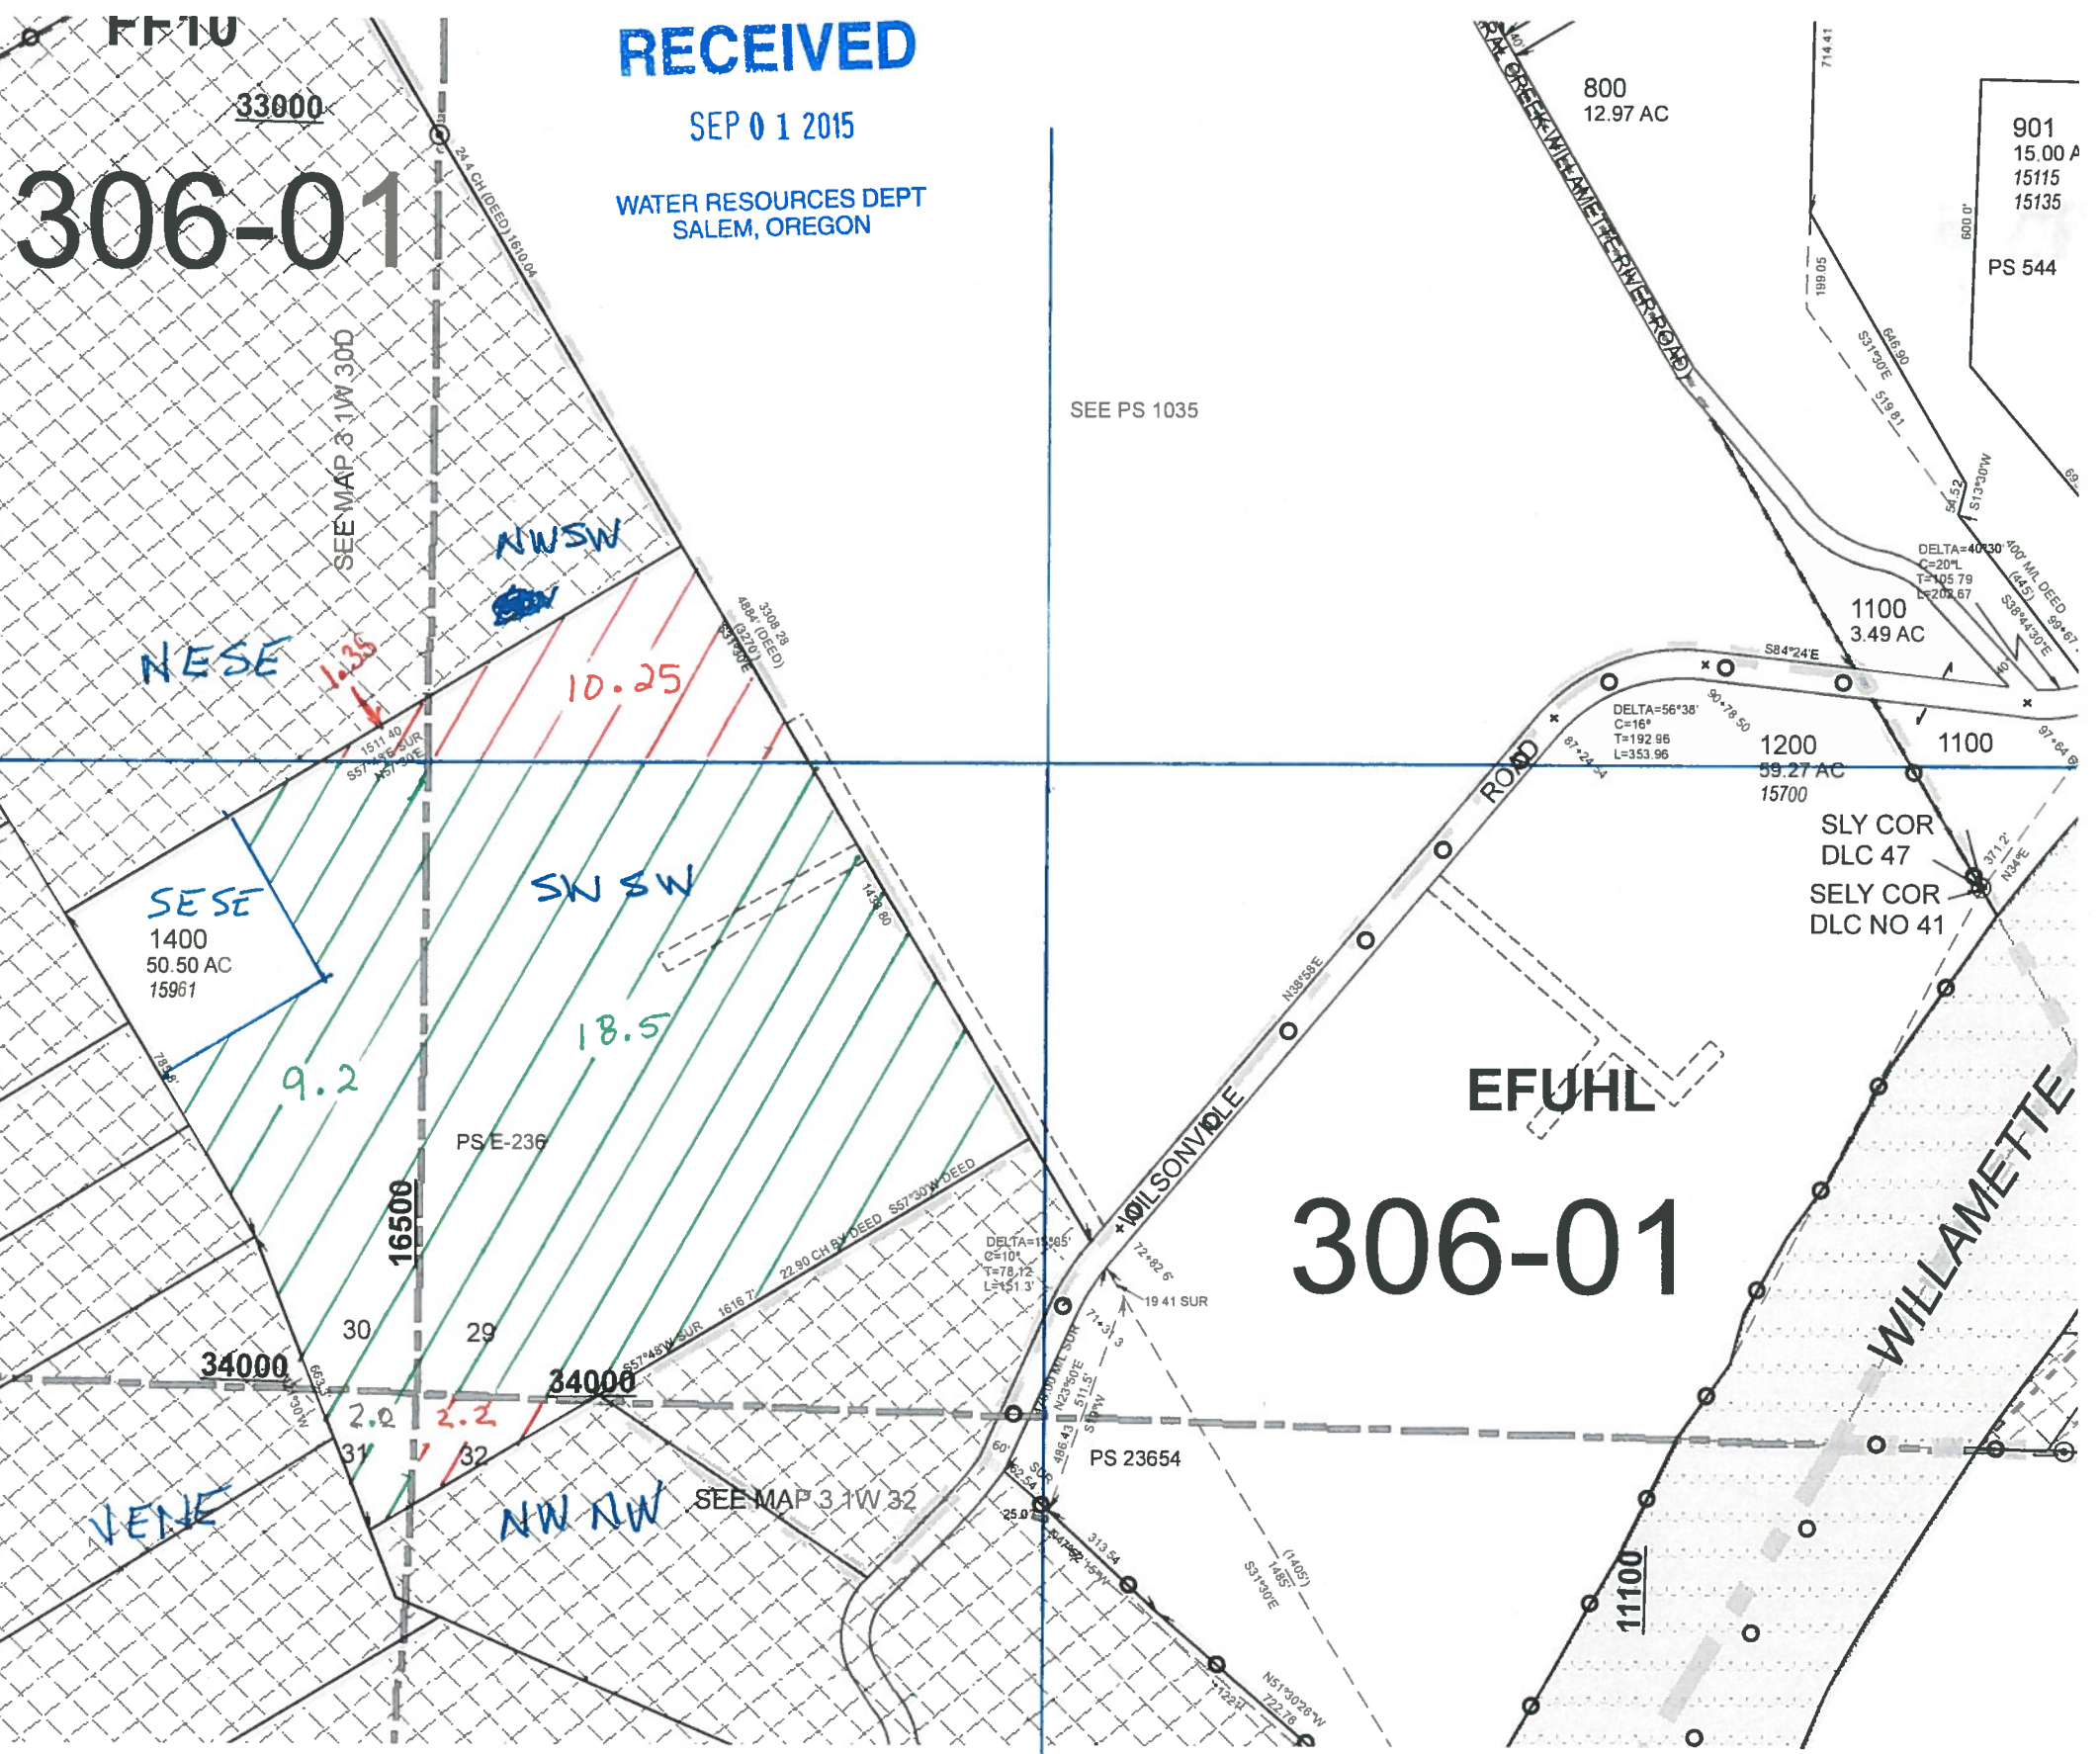

TO
CERT 34116
TO
CERT 14510

4

T 12152
1" = 400'