


**T.38S. R.4W. W.M.**

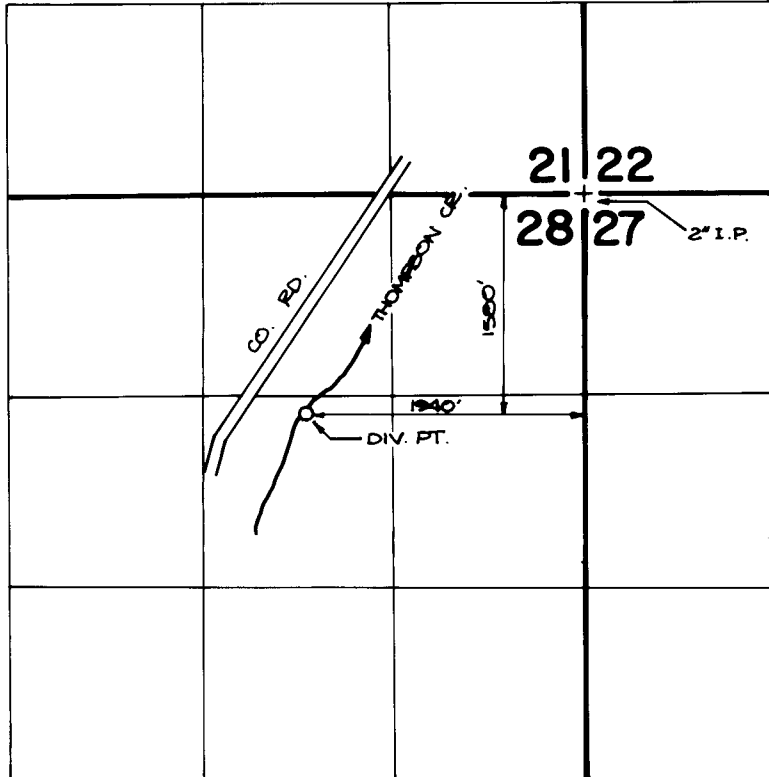

**FINAL PROOF SURVEY**

UNDER

**TRANSFER NO. 5063**

Application No. .... Permit No. ....

IN NAME OF


**VERNON P. & CHARLOTTE FOWLER**

Surveyed **JULY 27, 1983**, by **B. JAMES**.

Vernon P. & Charlotte Fowler  
Change in point of diversion map...

T-5063

T38 S, R 4W, W.M.

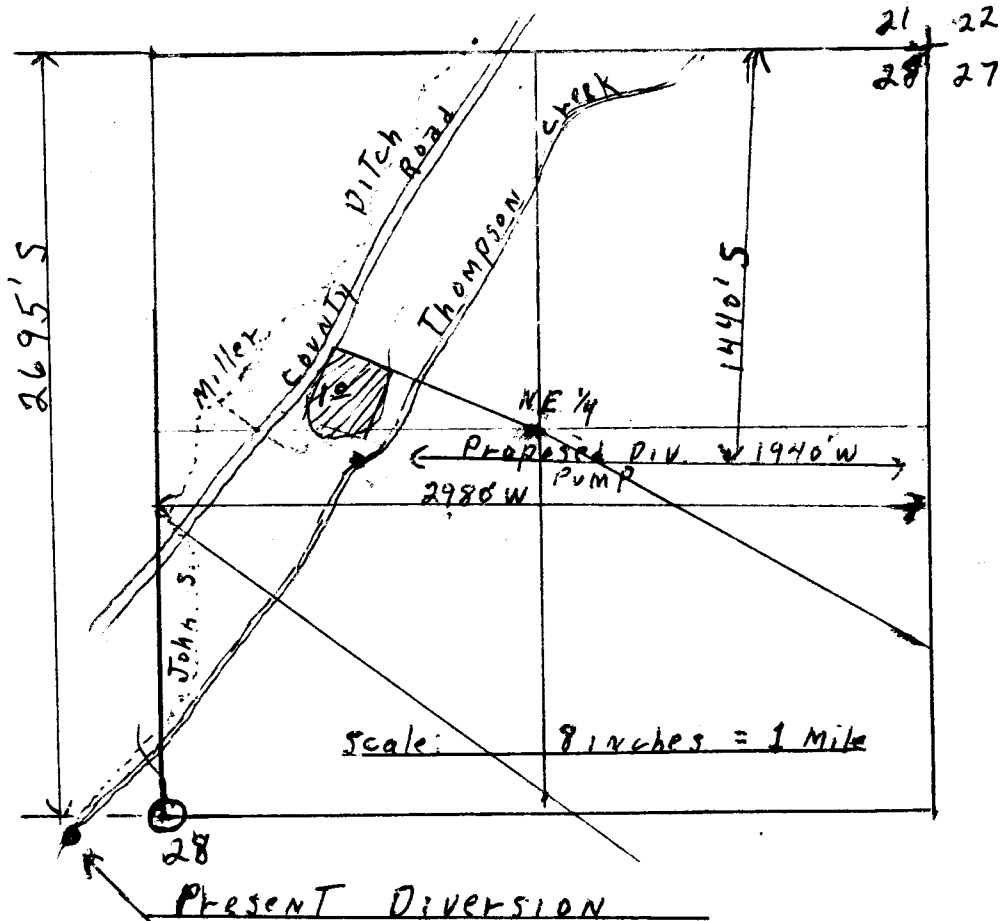

Map to accompany application in the name of Vernon P. & Charlotte Fowler, for a change in point of diversion of water from Thompson Creek.

**RECEIVED**

MAY 27 1952

WATER RESOURCES DEPT  
SALEM, OREGON