


372W34D 201 1.5ac Tran-ON WATSON

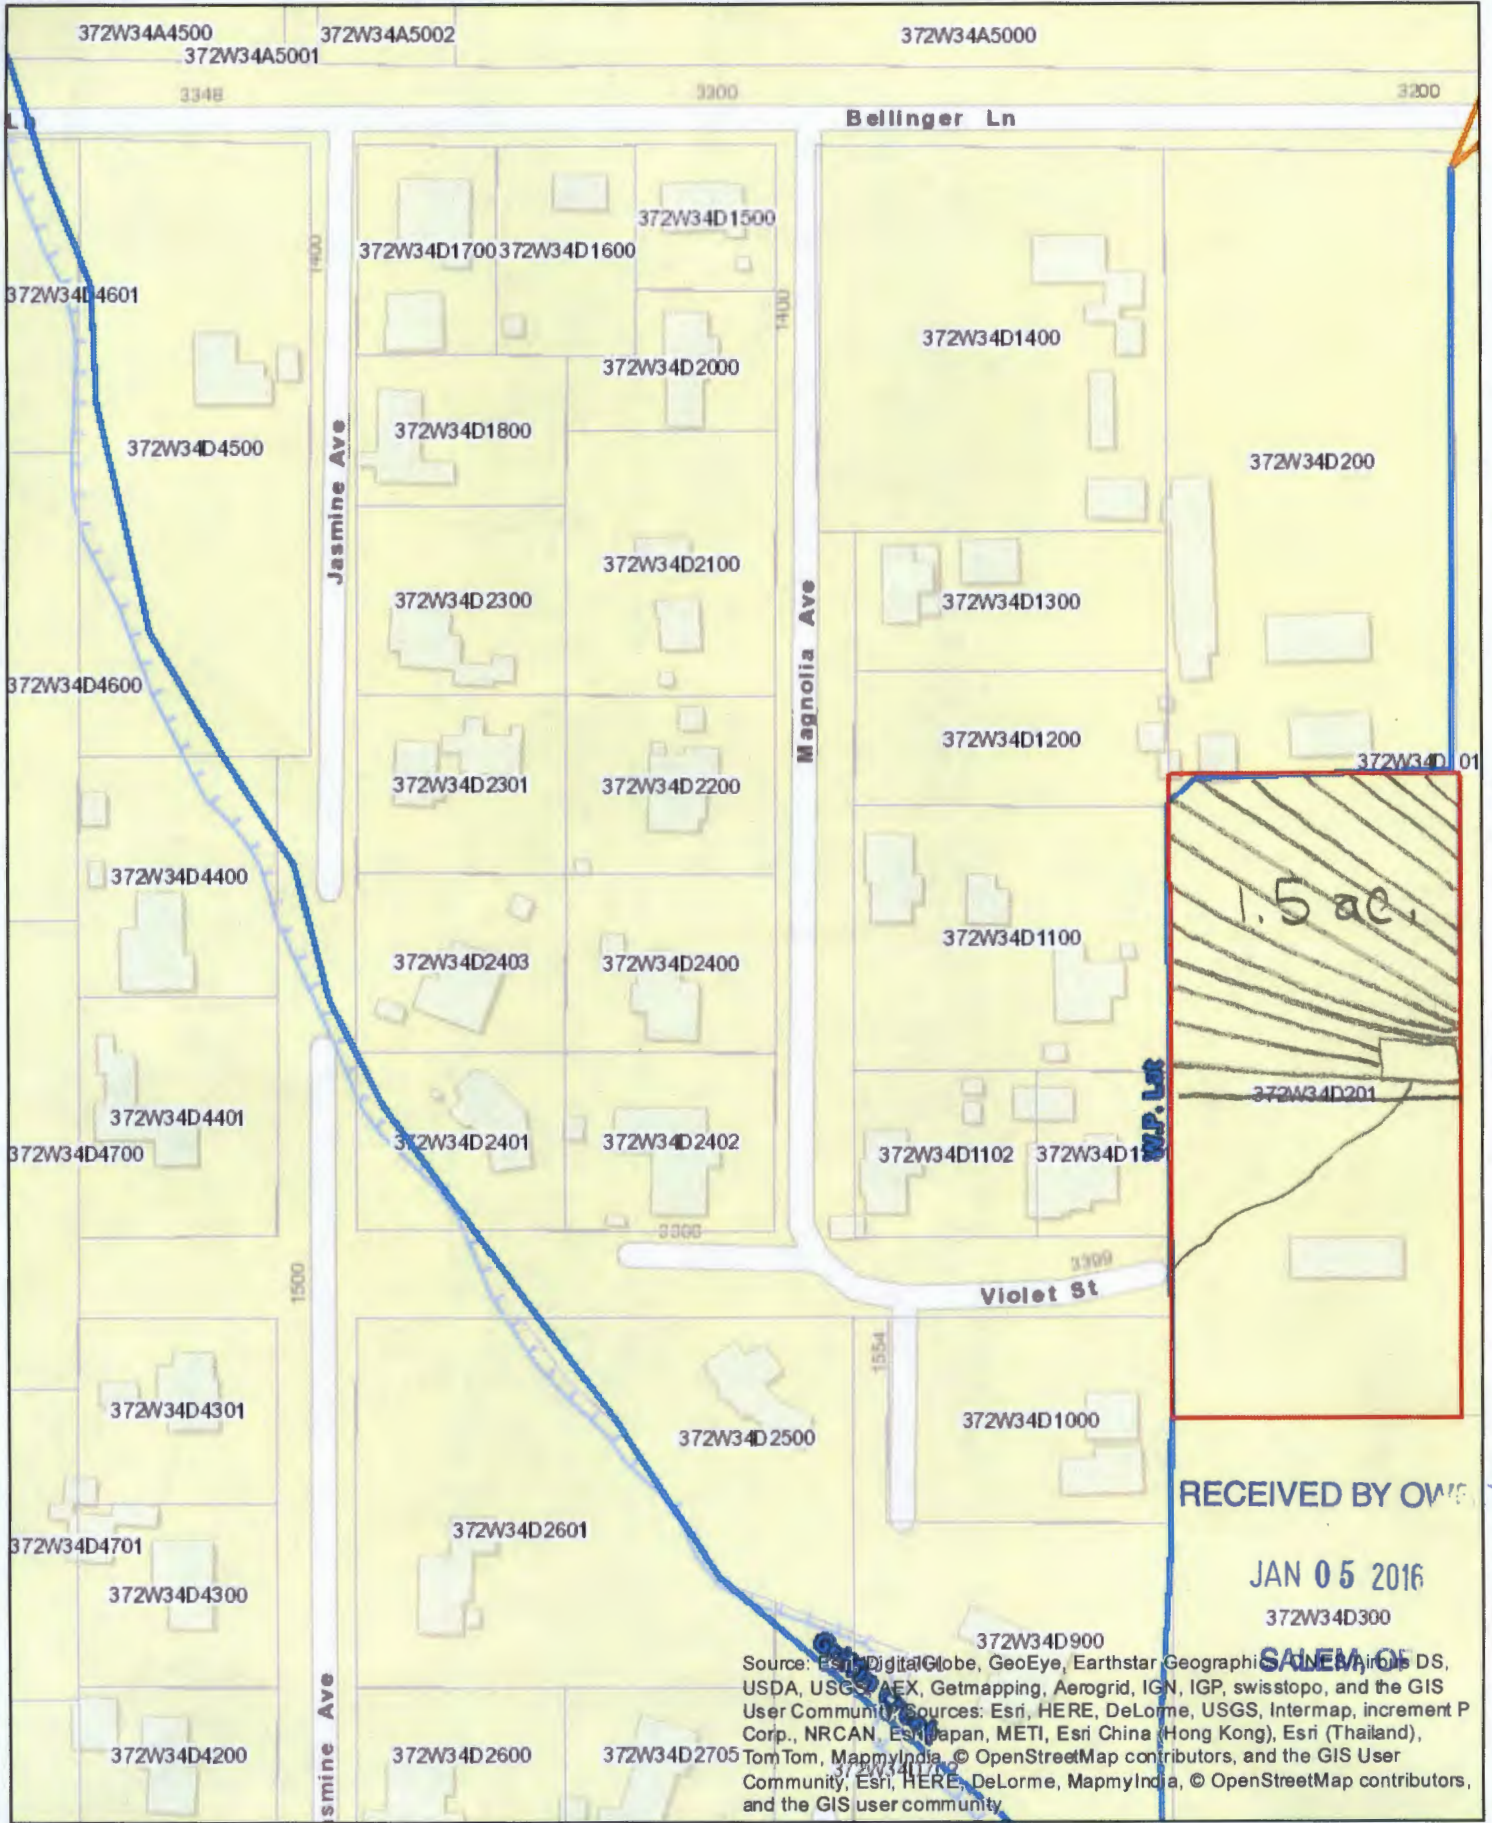

1.5 ac.

 JAN 05 2016
 372W34D300
 SALEM, OR

Source: Esri, DigitalGlobe, GeoEye, Earthstar Geographics, CNES/Airbus DS, USDA, USGS, AeroX, Getmapping, Aerogrid, IGN, IGP, swisstopo, and the GIS User Community. Sources: Esri, HERE, DeLorme, USGS, Intermap, increment P Corp., NRCAN, Esri Japan, METI, Esri China (Hong Kong), Esri (Thailand), TomTom, MapmyIndia, © OpenStreetMap contributors, and the GIS User Community, Esri, HERE, DeLorme, MapmyIndia, © OpenStreetMap contributors, and the GIS user community.




Author: Patty Gray
 Organization: Medford Irrigation District



Date Created: April 20, 2015

361W36D / 2400 1.0 AC T-ON HOLSTIEN

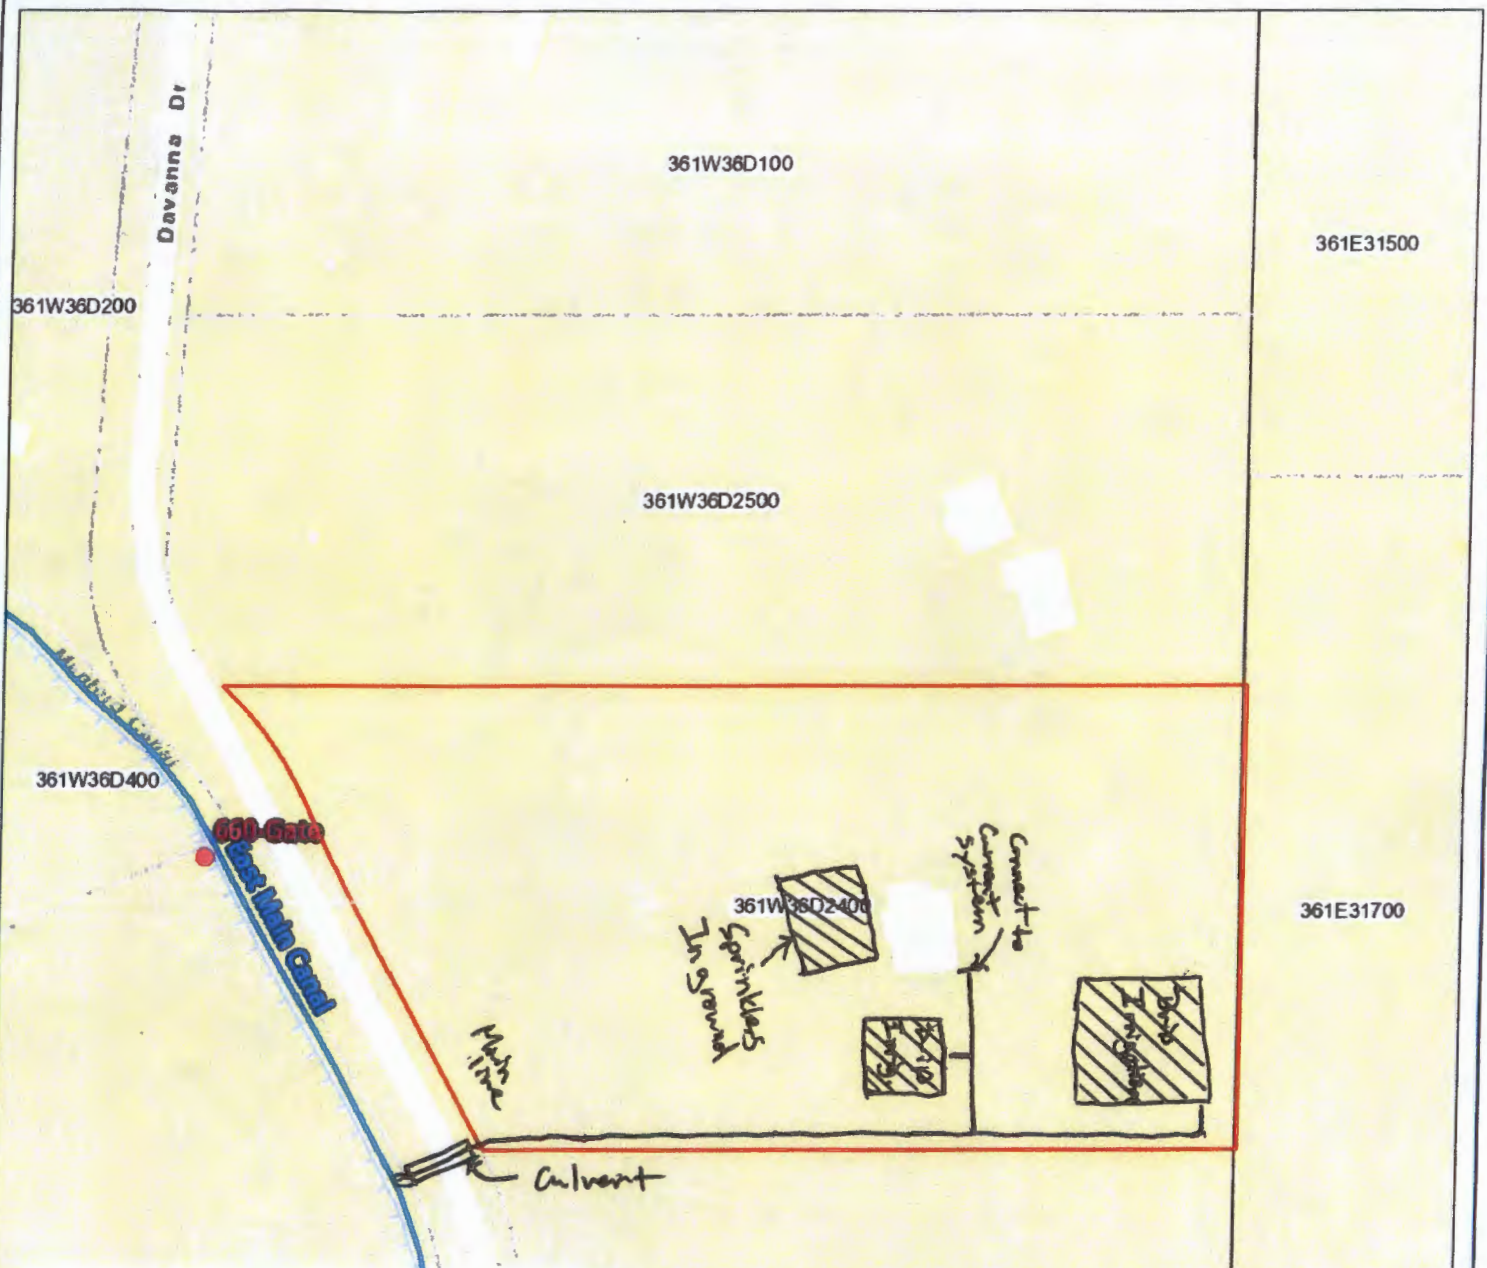

- Crossing
- Diversion
- Delivery Gate
- Headgate
- Siphon
- Canal
- Pipeline
- - Private Line
- Reservoir
- Parcel Labels
- Parcel
- Sections
- Service Area Boundary


RECEIVED BY OWRD

JAN 05 2016

SALEM, OR

Sources: Esri, HERE, DeLorme, TomTom, Intermap, increment P Corp., GEBCO, USGS, FAO, NPS, NRCAN, GeoBase, IGN, Kadaster NL, Ordnance Survey, Esri Japan, METI, Esri China (Hong Kong), swisstopo, MapmyIndia, © OpenStreetMap contributors, and the GIS User Community, Source: Esri, DigitalGlobe, GeoEye, Earthstar Geographics, CNES/Airbus DS, USDA, USGS, AEX, Getmapping, Aerogrid, IGN, IGP, swisstopo, and the GIS User Community, Sources: Esri, HERE, DeLorme, USGS, Intermap, increment P Corp., NRCAN, Esri Japan, METI, Esri China (Hong Kong), Esri (Thailand), TomTom, MapmyIndia, © OpenStreetMap contributors, and the GIS User Community, Esri, HERE, DeLorme, MapmyIndia, © OpenStreetMap contributors, and the GIS user community

Author: Patty Gray
 Organization: Medford Irrigation District

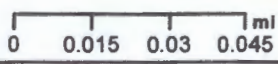

Date: April 15, 2015



361W36D / 2400 1.0 AC T-ON HOLSTIEN



- Crossing
 - Diversion
 - Delivery Gate
 - Headgate
 - Siphon
 - Canal
 - Pipeline
 - - Private Line
 - Reservoir
 - Parcel Labels
 - Parcel
 - Sections
 - Service Area Boundary
- RECEIVED BY OWRD**
JAN 05 2016
SALEM, OR

Source: Esri, DigitalGlobe, GeoEye, Earth Star Geographics, CNES/Airbus DS, USDA, USGS, AEX, Getmapping, Aerogrid, IGN, IGP, Swisstopo, and the GIS User Community, Esri, HERE, DeLorme, Mapbox, OpenStreetMap contributors, and the GIS user community.