



# T.5S. R.3W. Sec. 8, 9, 16, & 17 W.M.

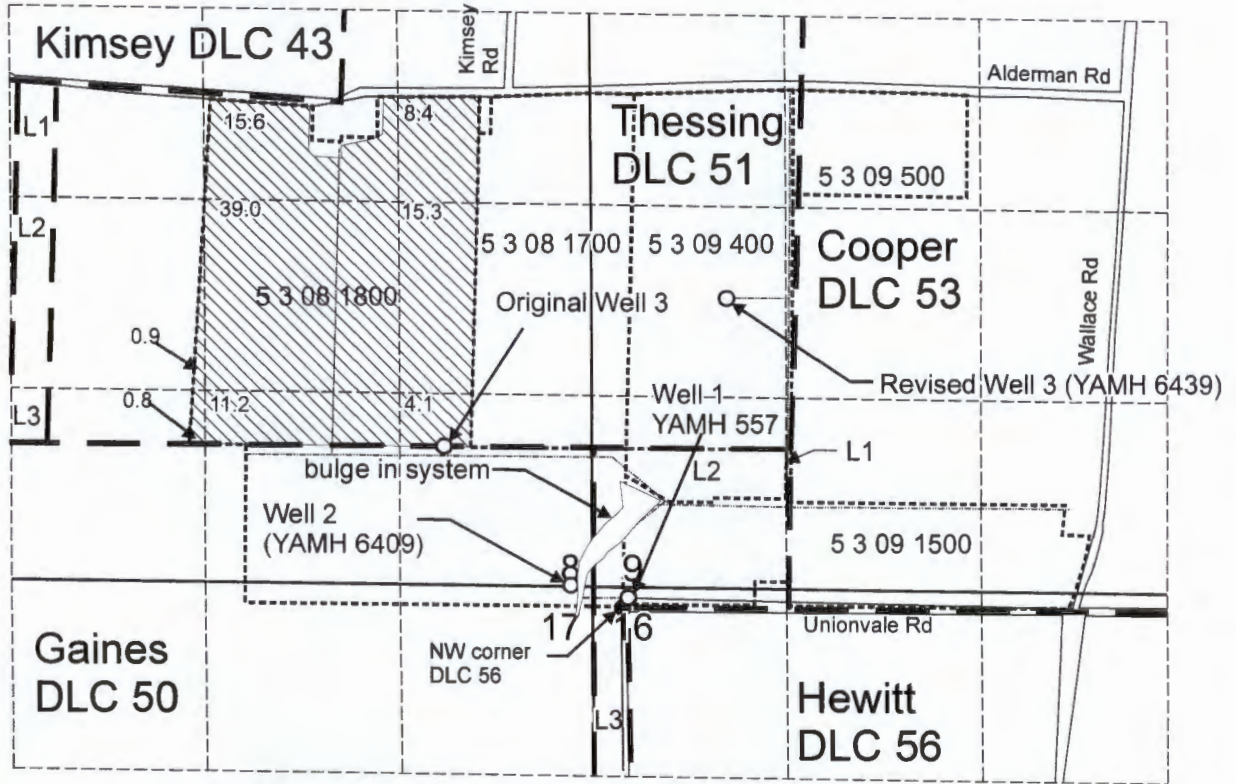

Well 1 (YAMH 557) is located 70 feet north and 5 feet east of the NW corner of DLC 56.  
 Well 2 (YAMH 6409) is located 150 feet north and 390 feet west of the NW corner of DLC 56.  
 Original Well 3 is located 10 feet north and 2,380 feet west of the SE corner of DLC 51.  
 Revised Well 3 (YAMH 6439), is located 2,120 feet north and 700 feet east of the NW corner of DLC 56.

- — — — — DLC boundary
- Tax lot boundary
- Area (95.3 Acres) to be irrigated.
- Mainline

Note: The quarter quarter lines have been projected using a tax map, government land survey maps, an aerial photograph, and best professional judgement.

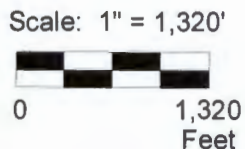

EXPIRATION DATE: 6/30/2017

This map was prepared for the purpose of identifying the location of a water right only and is not intended to provide legal dimensions or location of property ownership lines.



**RECEIVED**

JAN 19 2016

WATER RESOURCES DEPT  
SALEM, OREGON

Union\_Finn\_Good.cdr

Pacific Hydro-Geology Inc.

12249

Permit Amendment Application Map  
Application G-17294, Permit G-16888

Carlton Nursery Company, LLC  
Newhouse/Finnicum Farm

2015