

Transfer Application Map
for
Metalius Meadows
RECEIVED BY CWRD

MAR 02 2016

SALEM, OR



ESTES SURVEYS, LLC
 PO Box 17640 60382 Arnold Rd
 Salem, OR 97305-7640 Bend, OR 97702
 (503) 585-7593 (541) 382-7391

lots identified by X or Y

Section 16, T.13S., R. 9E., W.M.

This map is for the purpose of locating a water right only and has no intent to provide legal dimensions or the location of property lines.

Scale 1" = 400'

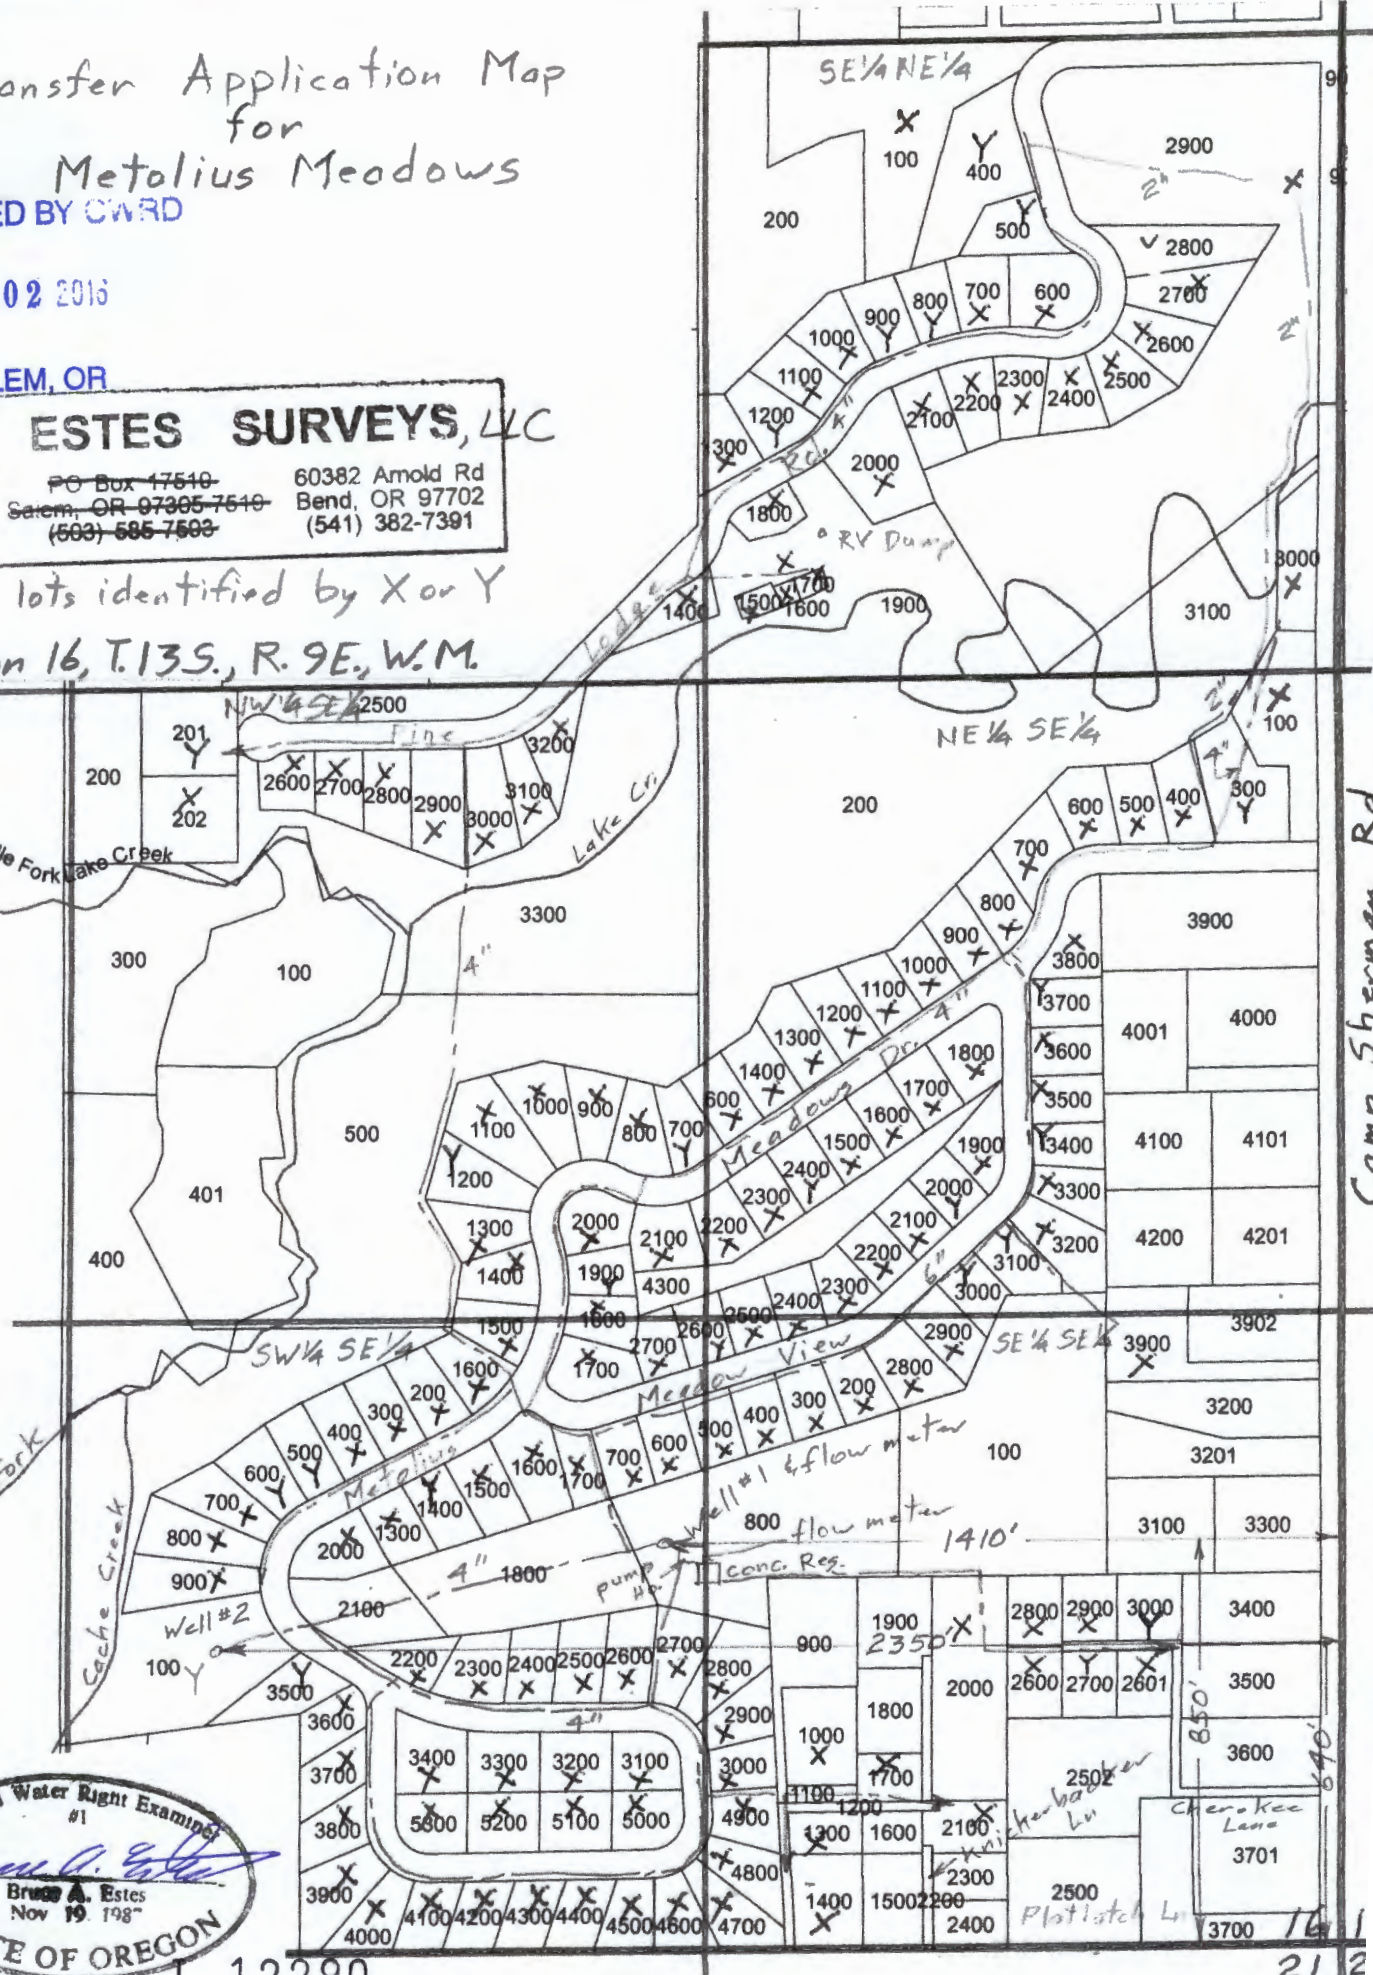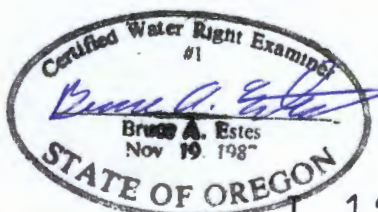

1 12290

21 2

Transfer Application Map for Metolius Meadows

RECEIVED BY OWRD

MAR 02 2016

SALEM, OR

ESTES SURVEYS, LLC



PO Box 17540 60382 Arnold Rd
Salem, OR 97305-7540 Bend, OR 97702
(503) 585-7593 (541) 382-7391

lots identified by X or Y

Section 16, T.13S., R. 9E., W.M.

This map is for the purpose of locating a water right only and has no intent to provide legal dimensions or the location of property lines.

Scale 1" = 400'

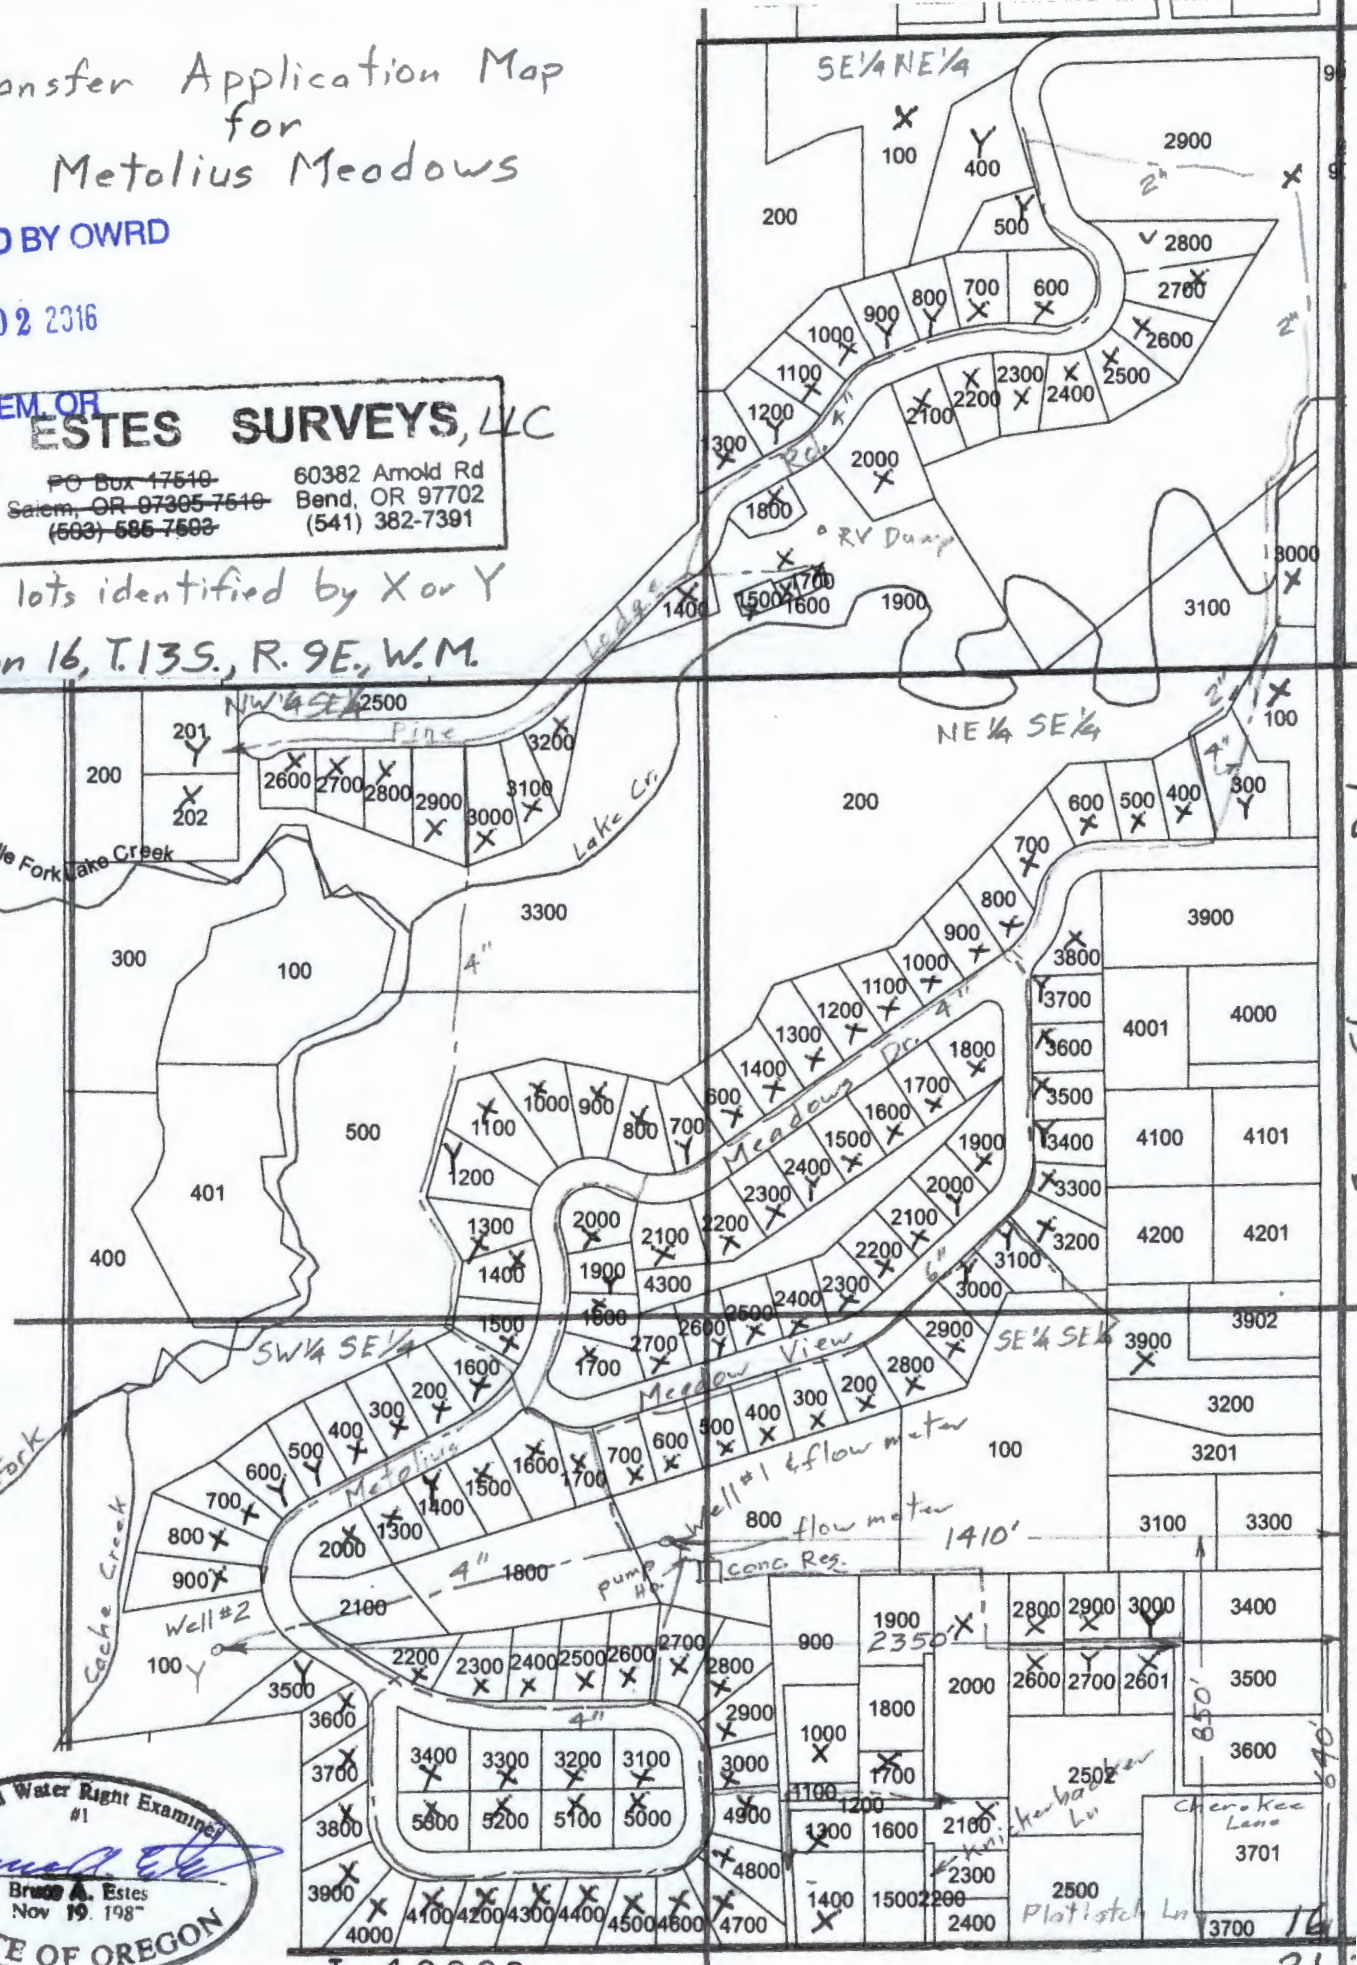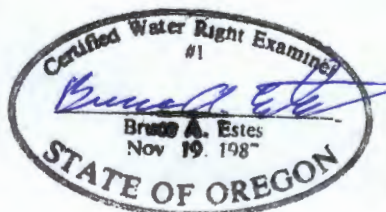

T 12290

21

Camp Sherman Rd