


Permit Amendment Map  
 Application G-15800, Permit G-16853  
 Diamond Ridge Water Association  
 PO BOX 8411 COBURG, OR 97408-1306

Township 16 South, Range 3 West  
 Sections 34 and 35

Legend

RECEIVED  
 MAR 07  
 SALEM,

Subdivision Boundary  
 Quarter Section Lines  
 Quarter-Quarter Section Lines  
 Tax Lot Boundaries and Numbers  
 Water Lines  
 Well Location and Designation  
 Corrected Area of Use  
 Area of Use from Permit  
 DLC Lines

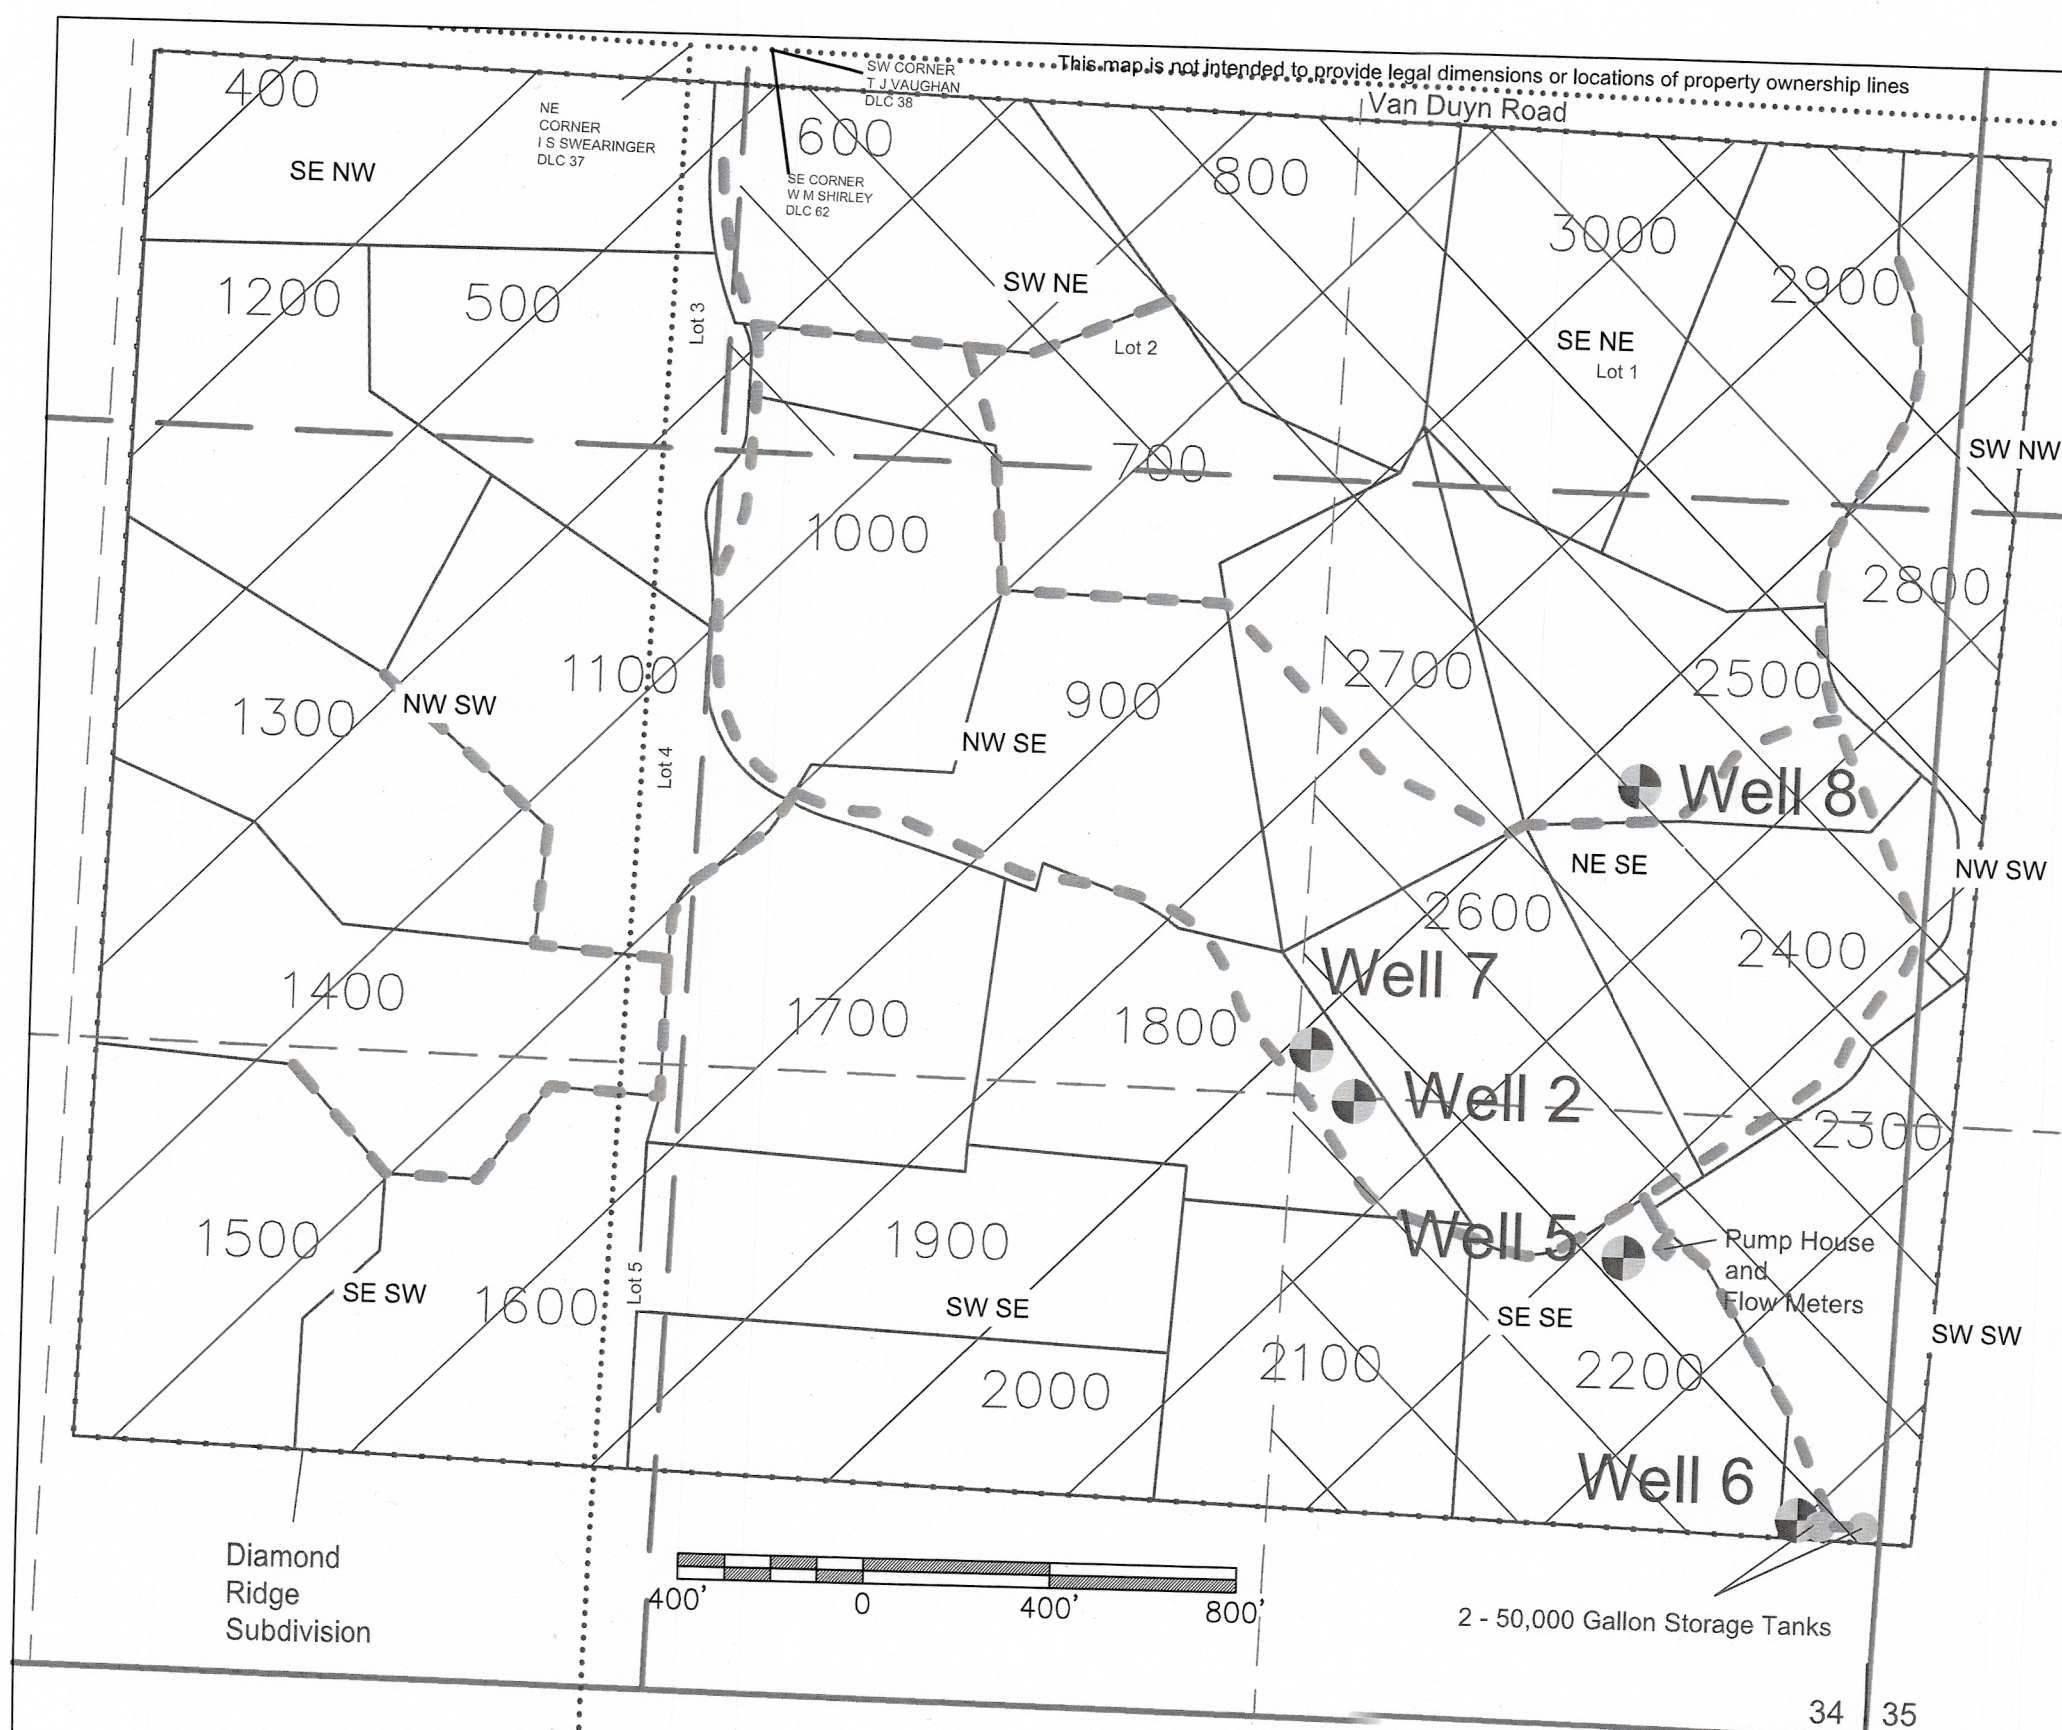

WELL #2 (TAG #44872): SE 1/4 SE 1/4 SECTION 34, T16S, R3W, W.M.; N 43°01'28" W 1814 FEET FROM SE CORNER, SECTION 34

WELL #5 (TAG #71194): SE 1/4 SE 1/4 SECTION 34, T16S, R3W, W.M.; N 28°23'35" W 1155 FEET FROM SE CORNER, SECTION 34

WELL #6 (TAG #71191): SE 1/4 SE 1/4 SECTION 34, T16S, R3W, N.M.; N 18°49'37" W 492 FEET FROM SE CORNER, SECTION 34