


ACMPC Oregon 3, LLC Neck Rd. farm

Revised 4-21-16 WEM

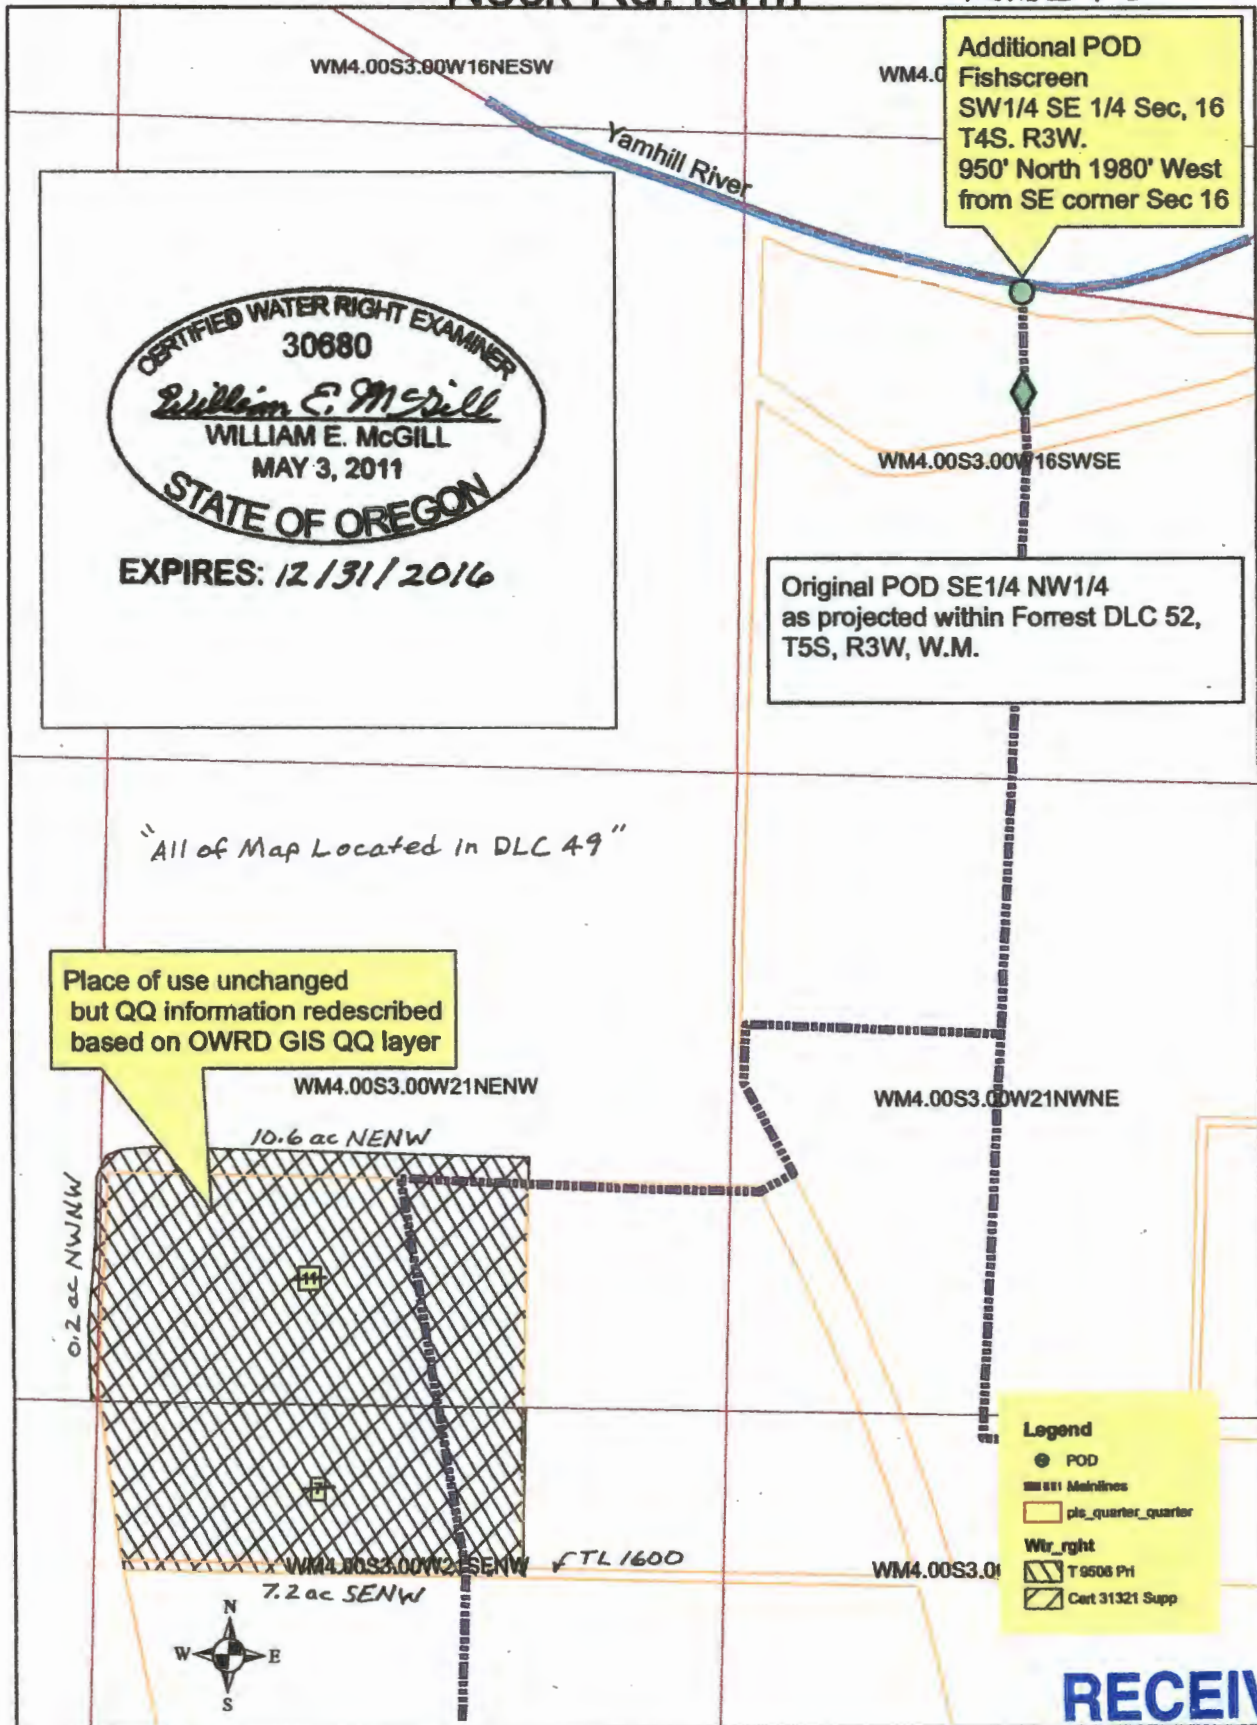

"All of Map Located in DLC 49"

Place of use unchanged
but QQ information redescribed
based on OWRD GIS QQ layer

Legend

- POD
- Mainlines
- qtr_quarter
- Wir_right
- ▨ T 9506 Pri
- ▨ Cert 31321 Supp

RECEIVED

0 200 400 800 Feet


Cert 31321 Additional POD map
Prepared by Stevenson/McGill

APR 21 2016

WATER RESOURCES DEPT
SALEM, OREGON

T-12306

ACMPC Oregon 3, LLC Neck Rd. farm

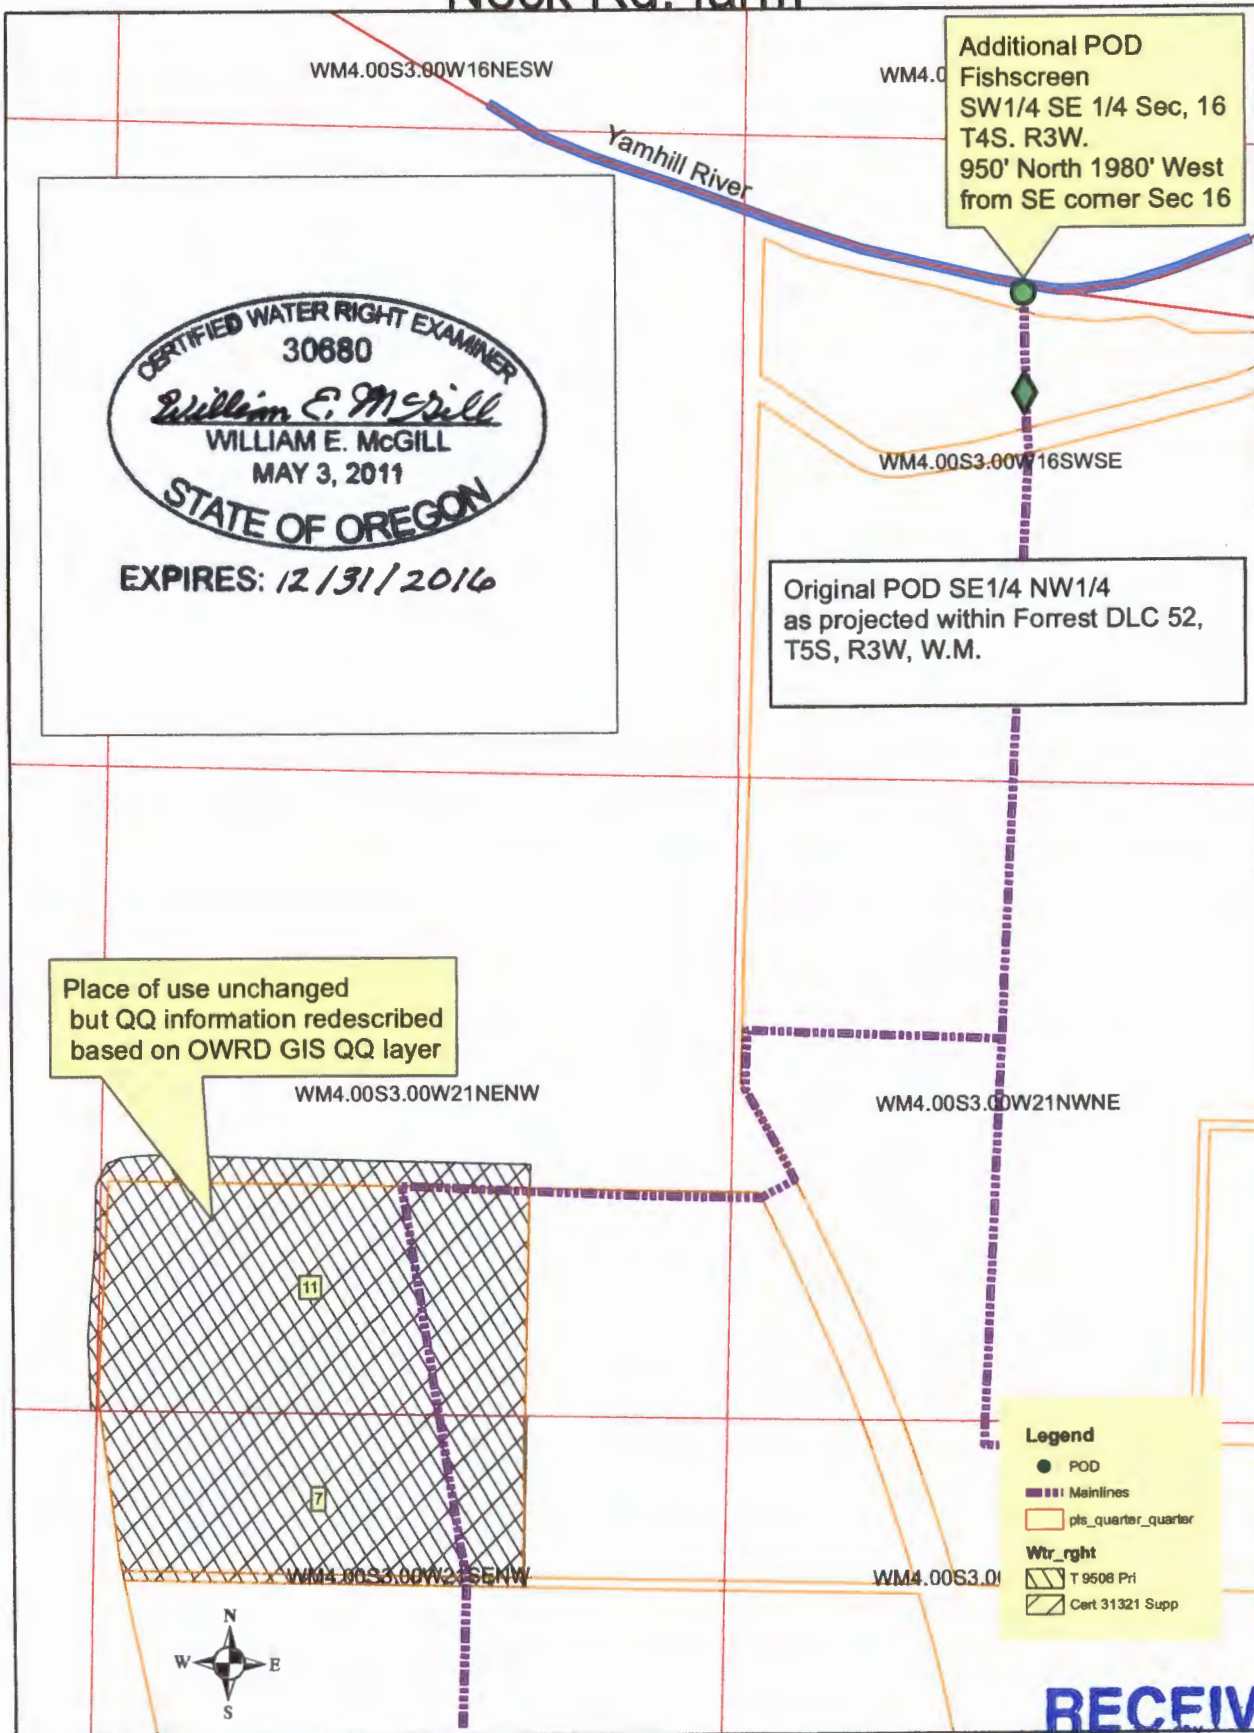

CERTIFIED WATER RIGHT EXAMINER
30680
William E. McGill
WILLIAM E. MCGILL
MAY 3, 2011
STATE OF OREGON
EXPIRES: 12/31/2016

0 200 400 800
Feet



Cert 31321 Additional POD map
Prepared by Stevenson/McGill

RECEIVED

MAR 11 2016

T 12306

WATER RESOURCES DEPT
SALEM, OREGON