

MAR 25 2016

SALEM, OR


T5N, R35E, WM Sections 3, 4, 5, 8, 9, 10
T6N, R35E, WM Sections 31 and 32
UMATILLA COUNTY

Points of Appropriation

Conveyance
Conveyance system is buried pressure pipeline ranging in size from 6 to 15 inches in diameter. Water applied for irrigation of various crops with variety of sprinkler and drip irrigation systems.



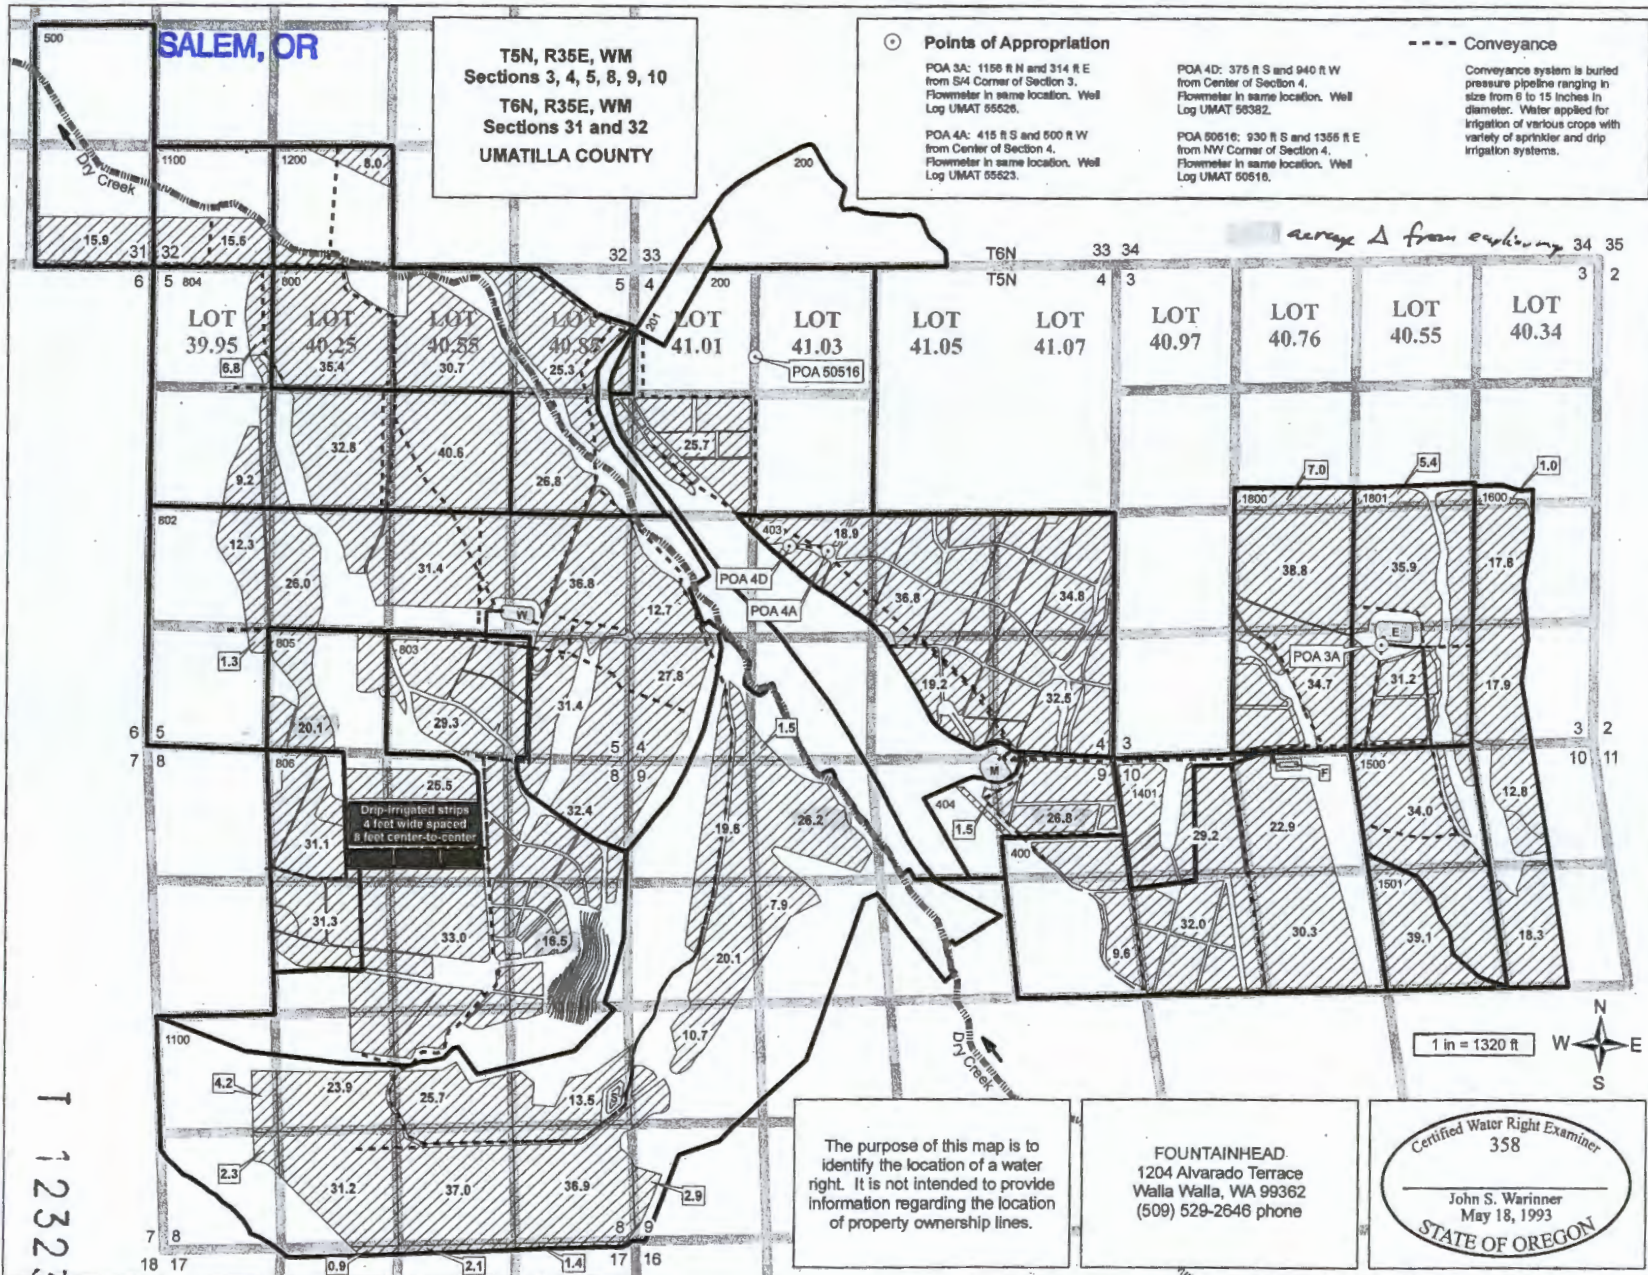

Drip-irrigated strips
4 feet wide spaced
8 feet center-to-center

The purpose of this map is to identify the location of a water right. It is not intended to provide information regarding the location of property ownership lines.

FOUNTAINHEAD
1204 Alvarado Terrace
Walla Walla, WA 99362
(509) 529-2646 phone

Certified Water Right Examiner
358
John S. Warinner
May 18, 1993
STATE OF OREGON




CLAIM OF BENEFICIAL USE MAP
Application G-16322
Permit G-15683
Permit Amendment T-10777
in the name of
SEVEN HILLS PROPERTIES, LLC
Revised: 24 MAY 2010

T 12323







**Application for a
Temporary Water Right Transfer
Certificate 86441 (Permit G-15883)**
Seven Hills Properties Water Association
Umatilla County

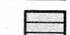LEGEND

Place of Use (POU)

-  From Lands
-  To Lands
-  Remaining Lands

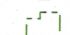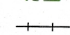All Other Features

-  Authorized Point of Appropriation (POA)
-  Tax Lot
-  Government Lot (GL)
-  Railroads
-  Watercourse
-  Waterbody

RECEIVED BY OWRD

MAR 25 2016

SALEM, OR



POA LOCATION DESCRIPTIONS

Well 3A (UMAT 55526) Located 1156 feet North and 314 feet East from the S1/4 corner of Section 3, Township 5 North, Range 35 East (W.M.)

Well 4A (UMAT55523) Located 415 feet South and 500 feet West from the C1/4 corner of Section 4, Township 5 North, Range 35 East (W.M.)

Well 4D (UMAT 56382) Located 375 feet South and 940 feet West from the C1/4 corner of Section 4, Township 5 North, Range 35 East (W.M.)

Well UMAT 50516 Located 930 feet South and 1355 feet East from the NW corner of Section 4, Township 5 North, Range 35 East (W.M.)

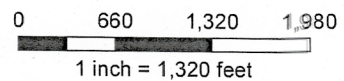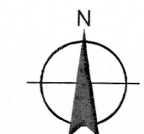

DISCLAIMER

This map was prepared for the purpose of identifying the location of a water right only and it is not intended to provide legal dimensions or location of property ownership lines.

MAP NOTES:

Date: February 26, 2016

