


Marion Church of God (Seventh Day)


GR-117 GR Modification

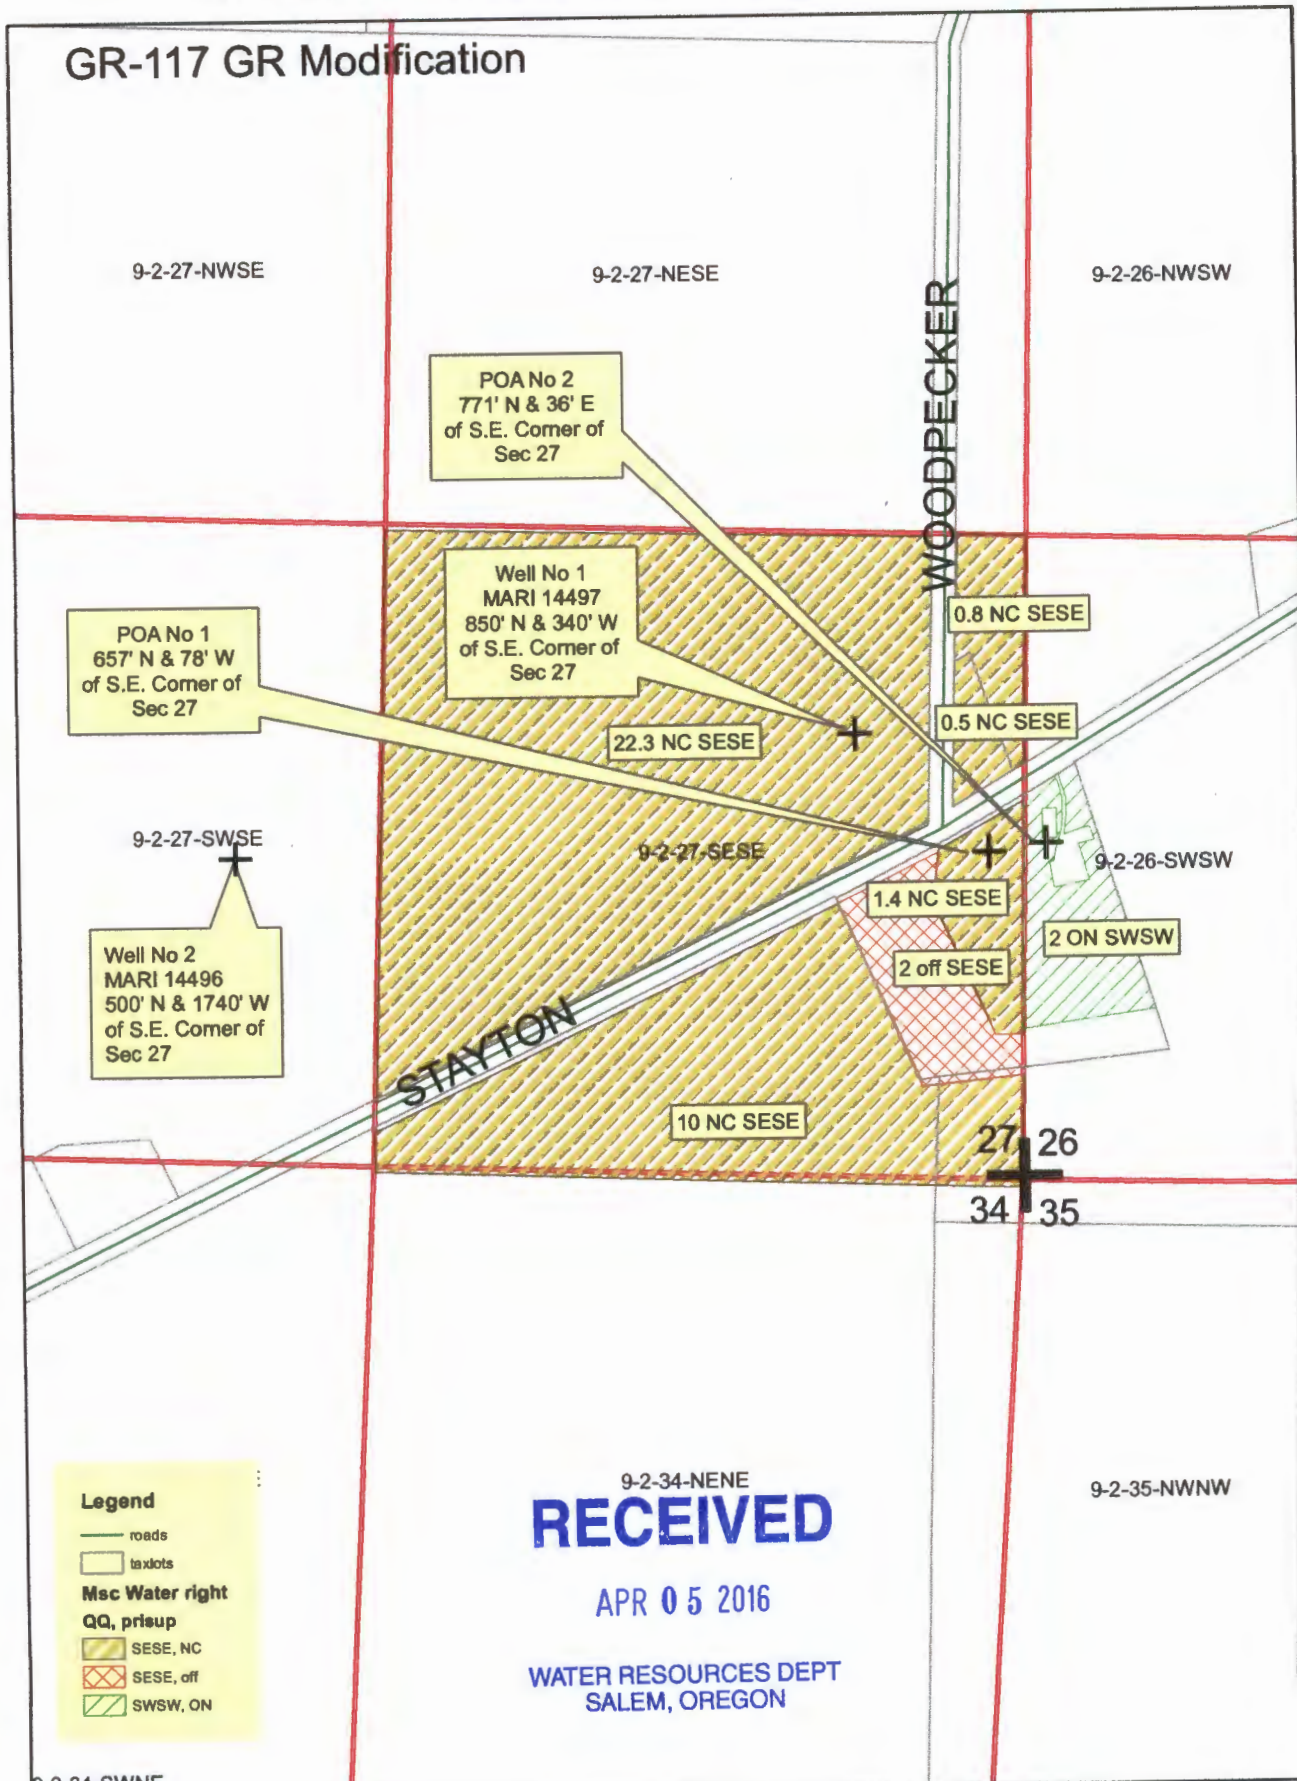

Legend

- roads
- taxlots
- Misc Water right**
- QQ, prioup**
- SESE, NC
- SESE, off
- SWSW, ON

9-2-34-NENE
RECEIVED
 APR 05 2016
 WATER RESOURCES DEPT
 SALEM, OREGON

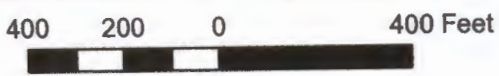

Map prepared by Stevenson/McGill



T 12328