



GROUNDWATER REGISTRATION MODIFICATION MAP

FOR
BRUCEPAC

LOCATED IN
B.S. BONNEY D.L.C. No. 47
SW 1/4 SEC. 17, T. 5 S., R. 1 W., W.M.
MARION COUNTY, OREGON

DECEMBER 3, 2015

GR-2218

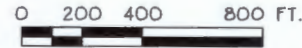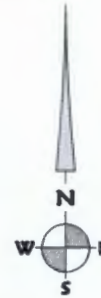

SCALE: 1" = 400'

LEGEND:

⊙ POINT OF APPROPRIATION (P.O.A.)

AUTHORIZED P.O.A.

1,830' NORTH + 490' EAST OF SW COR. SEC. 17
NOTE: THE AUTHORIZED LOCATION IS 1,700' NORTH + 300' EAST OF THE SW COR. SEC. 17

ADDITIONAL P.O.A.

1,840' NORTH + 450' EAST OF SW COR. SEC. 17

PROPOSED USE

INDUSTRIAL

NOTE:

THIS MAP IS NOT INTENDED TO PROVIDE LEGAL DIMENSIONS OR LOCATION OF PROPERTY OWNERSHIP. INFORMATION ON THIS MAP IS COMPILED FROM 2015 MARION COUNTY GIS DATA AND AERIAL PHOTOGRAPHY.

RECEIVED BY OWRD

Date: 12/3/2015 Time: 11:01
Scale: 1=400(P5)
File: dwg\2015\15-105-a\15-105a-grmod.dwg (lan)

K & D ENGINEERING, Inc.
276 N.W. Hickory Street P.O. Box 725
Albany, Oregon 97321
(541) 928-2683

T 12334

APR 11 2016

SALEM, OR

05 1W 17C

05 1W 17C WOODBURN



MARION COUNTY, OREGON
SW1/4 SEC17 T5S R1W W.M.
SCALE 1" = 200'

- LEGEND**
- | | |
|--------------------------|-----------------------|
| LINE TYPES | |
| Taxlot Boundary | Historical Boundary |
| Road Right-of-Way | Easement |
| Railroad Right-of-Way | Railroad Centerline |
| Private Road ROW | Taxcode Line |
| Subdivision Plat Bndry | Map Boundary |
| Waterline - Taxlot Bndry | Waterline - Non Bndry |

- SYMBOL TYPES**
- | | |
|-------------------|----------------------|
| • Survey Monument | † 1/16TH Section Cor |
| ⊕ Road Station | ⊕ 1/4 Section Cor |
| ⊙ DLC Corner | 16 35 Section Corner |
| | 21 22 |

NUMBERS
Tax Code Number
000 00 00 0

Acres 9.25 AC All acres listed are Net Acres, excluding any portions of the taxlot within public RTW's

NOTES
Tick Marks: If a tick mark is indicated on the end of a line, then the dimension goes to the tick mark. This is used when dimensions extend into public right-of-ways.



CANCELLED NUMBERS

300	
400A1	
500A1	
700A1	
700A2	
700A3	
701A2	

DISCLAIMER: THIS MAP WAS PREPARED FOR ASSESSMENT PURPOSES ONLY



FOR ADDITIONAL MAPS VISIT OUR WEBSITE AT www.co.marion.or.us

PLOT DATE: 10/7/2015

WOODBURN 05 1W 17C



RECEIVED BY OWRD

APR 11 2016

SALEM, OR Exhibit A

Exhibit A

05 1W 17C

T 12334