


TOWNSHIP 17 SOUTH, RANGE 22 EAST, W.M.

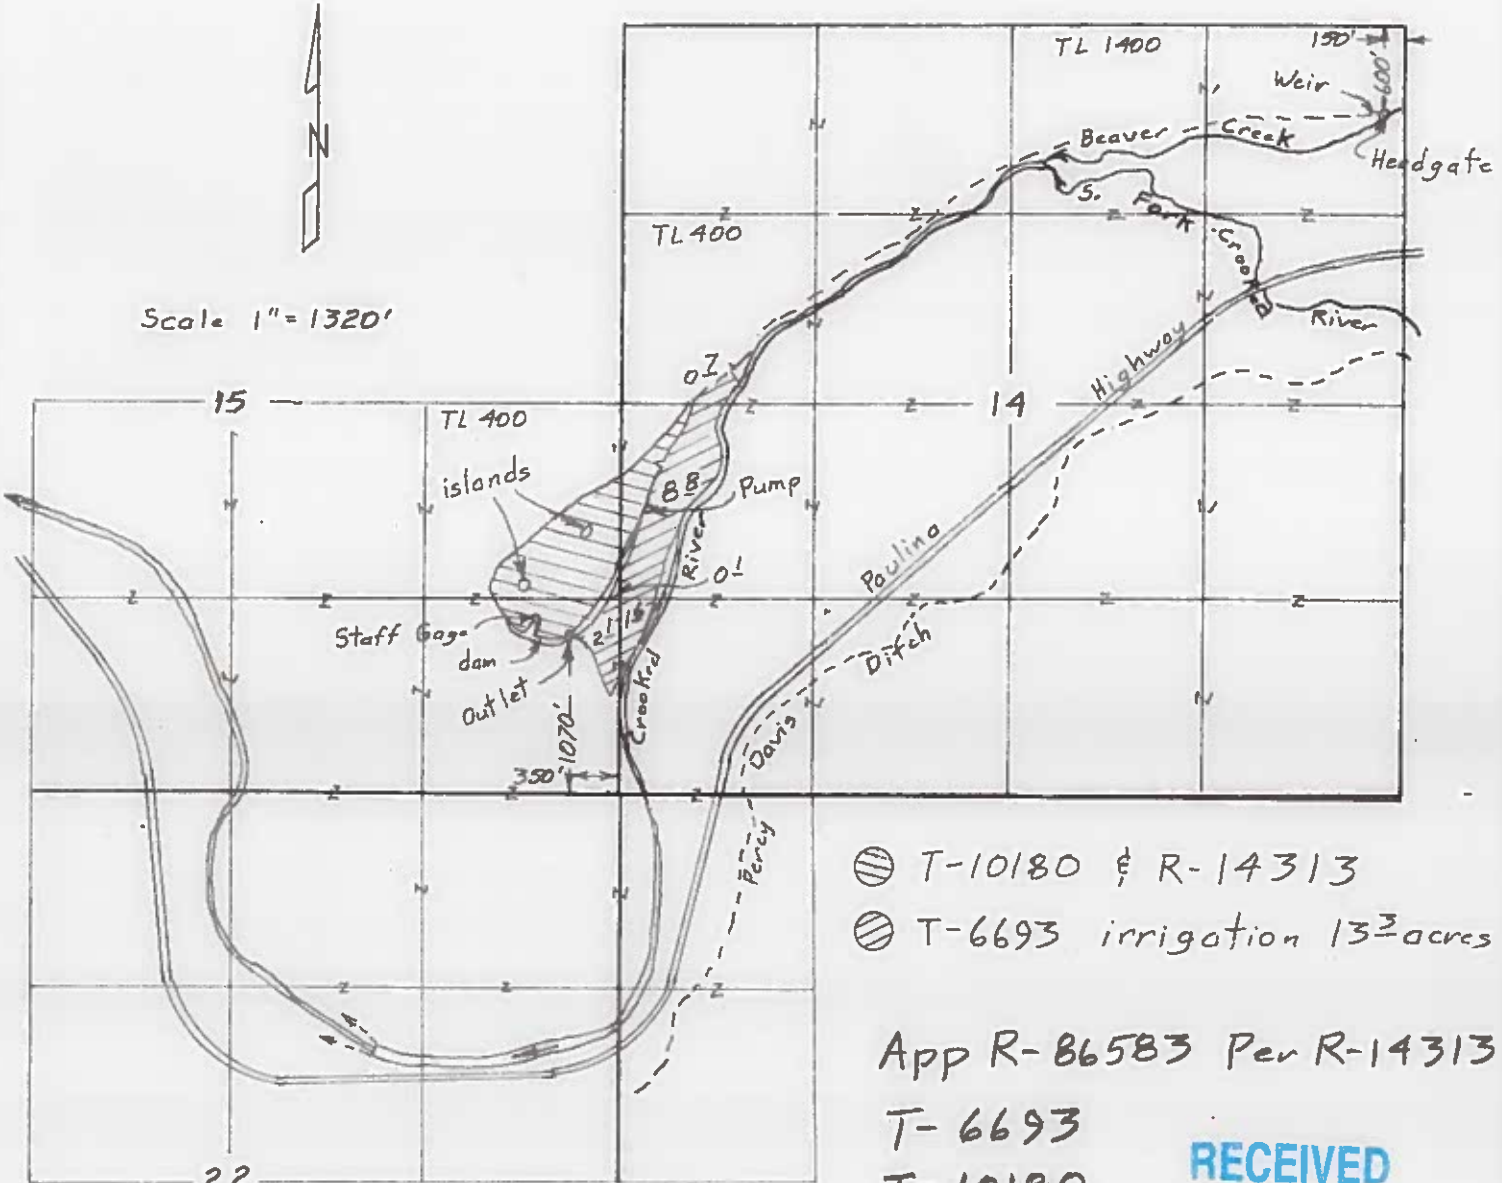

Surveyed July 1, 2009  
& March 31, 2011

- ⊗ T-10180 & R-14313
- ⊗ T-6693 irrigation 13<sup>3</sup> acres

App R-86583 Per R-14313  
T-6693  
T-10180

**RECEIVED**

AUG 30 2011

WATER RESOURCES DEPT  
SALEM OREGON

Claim of Beneficial Use Map  
for  
OREGON RANCHING CO.  
(Twin Buttes Ranch)

**RECEIVED**

JUL 20 2011

WATER RESOURCES DEPT  
SALEM, OREGON



Renewal Dec 31, 2011

This map is for the purpose of locating a water right only and has no intent to provide legal dimensions or the location of property lines.

**ESTES SURVEYS, LLC**  
 PO Box 17815  
 Salem, OR 97305-7815  
 (503) 582-7503  
 60882 Arnold Rd  
 Seaside, OR 97138  
 (541) 382-7301