
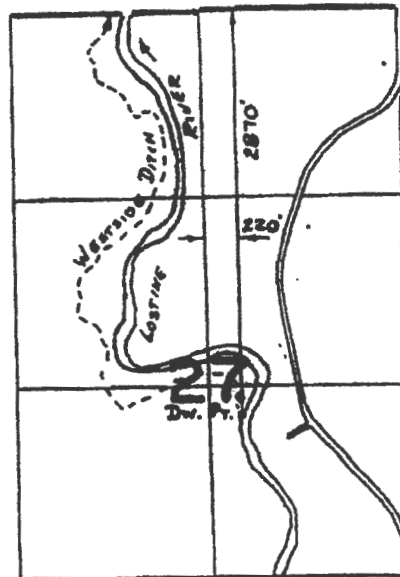


*copy* Map

FROM

T. 15., R. 43E., W. M.

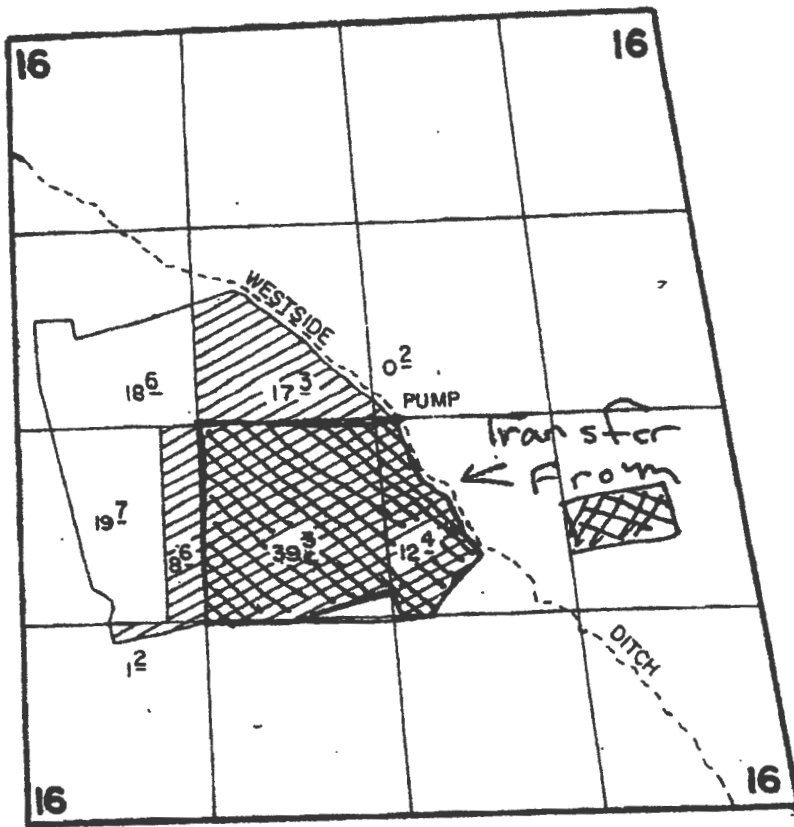

Tran #  
T 9186



SCALE: 1" = 1320'

**FINAL PROOF SURVEY**  
UNDER

51.7

Application No. **58547** Permit No. **44274**

IN NAME OF

*Kirby Fiegel*  
**ARNILDO J. LUPPIANO**

Surveyed ..8..13..... 19.85., by ..V.L. CHURCH.....

RECEIVED BY OWRD


APR 25 2016

SALEM, OR

T 12353

Township 1 North Range 43 East

Note  
This water will be divided through the West side as it has been for 100 years  
5 year term transfer  
Same Division Point as d. v. v.

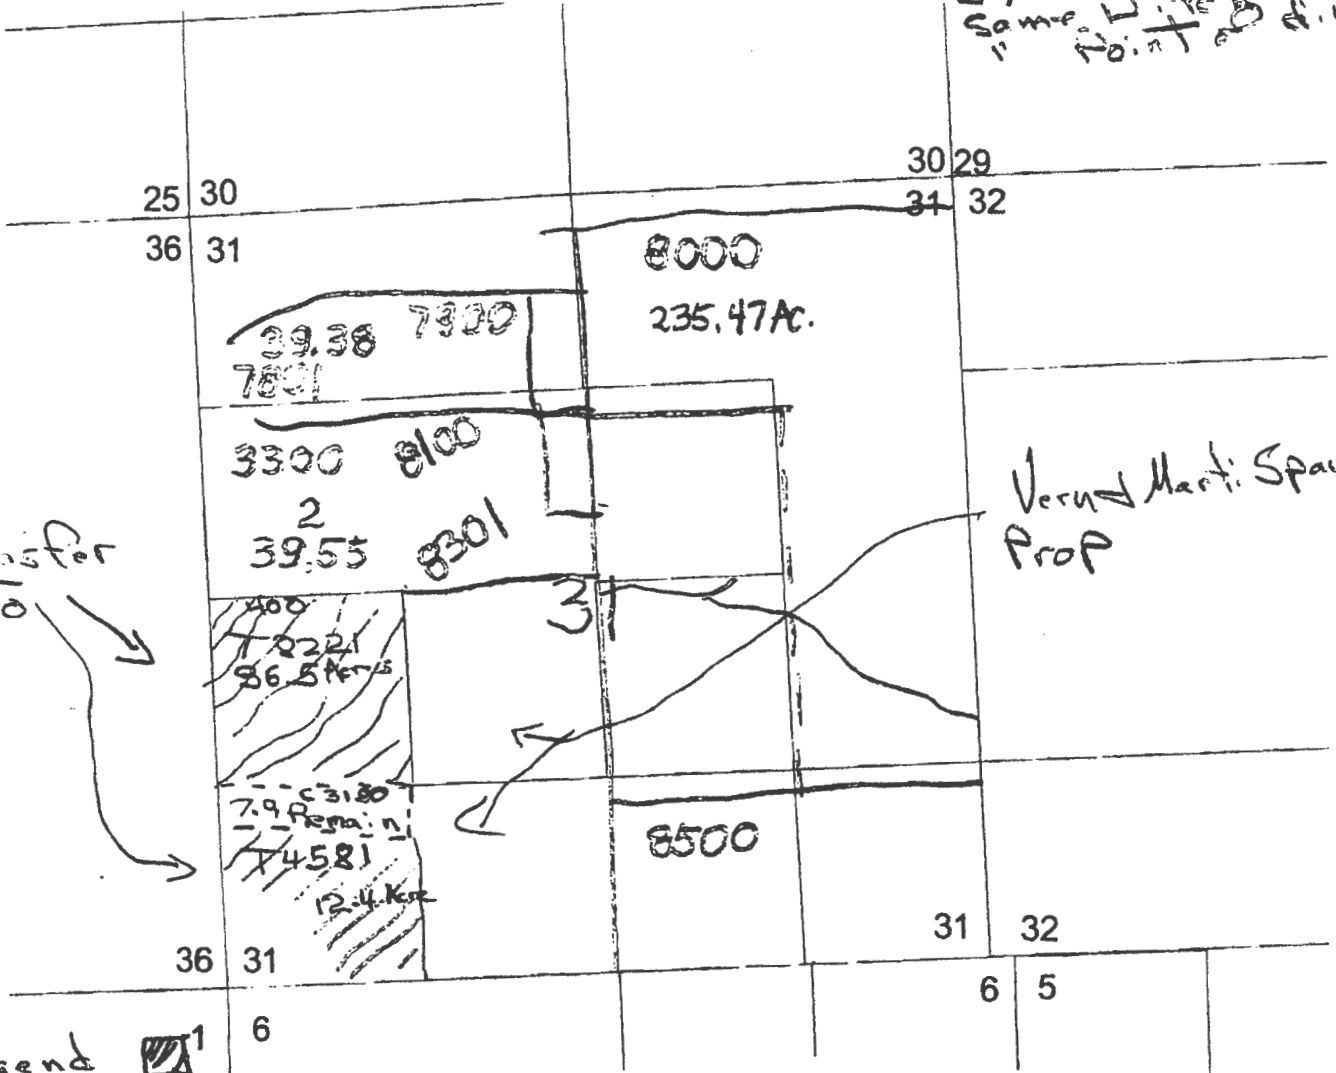

Transfer to

Verne Mart. Spaur Prop

Legend  
Transfer to

This is the exact transfer as last year only now a 5 year term  
Last year T 49126

148.9

RECEIVED BY OWRD

APR 25 2016

SALEM, OR

T 112353

