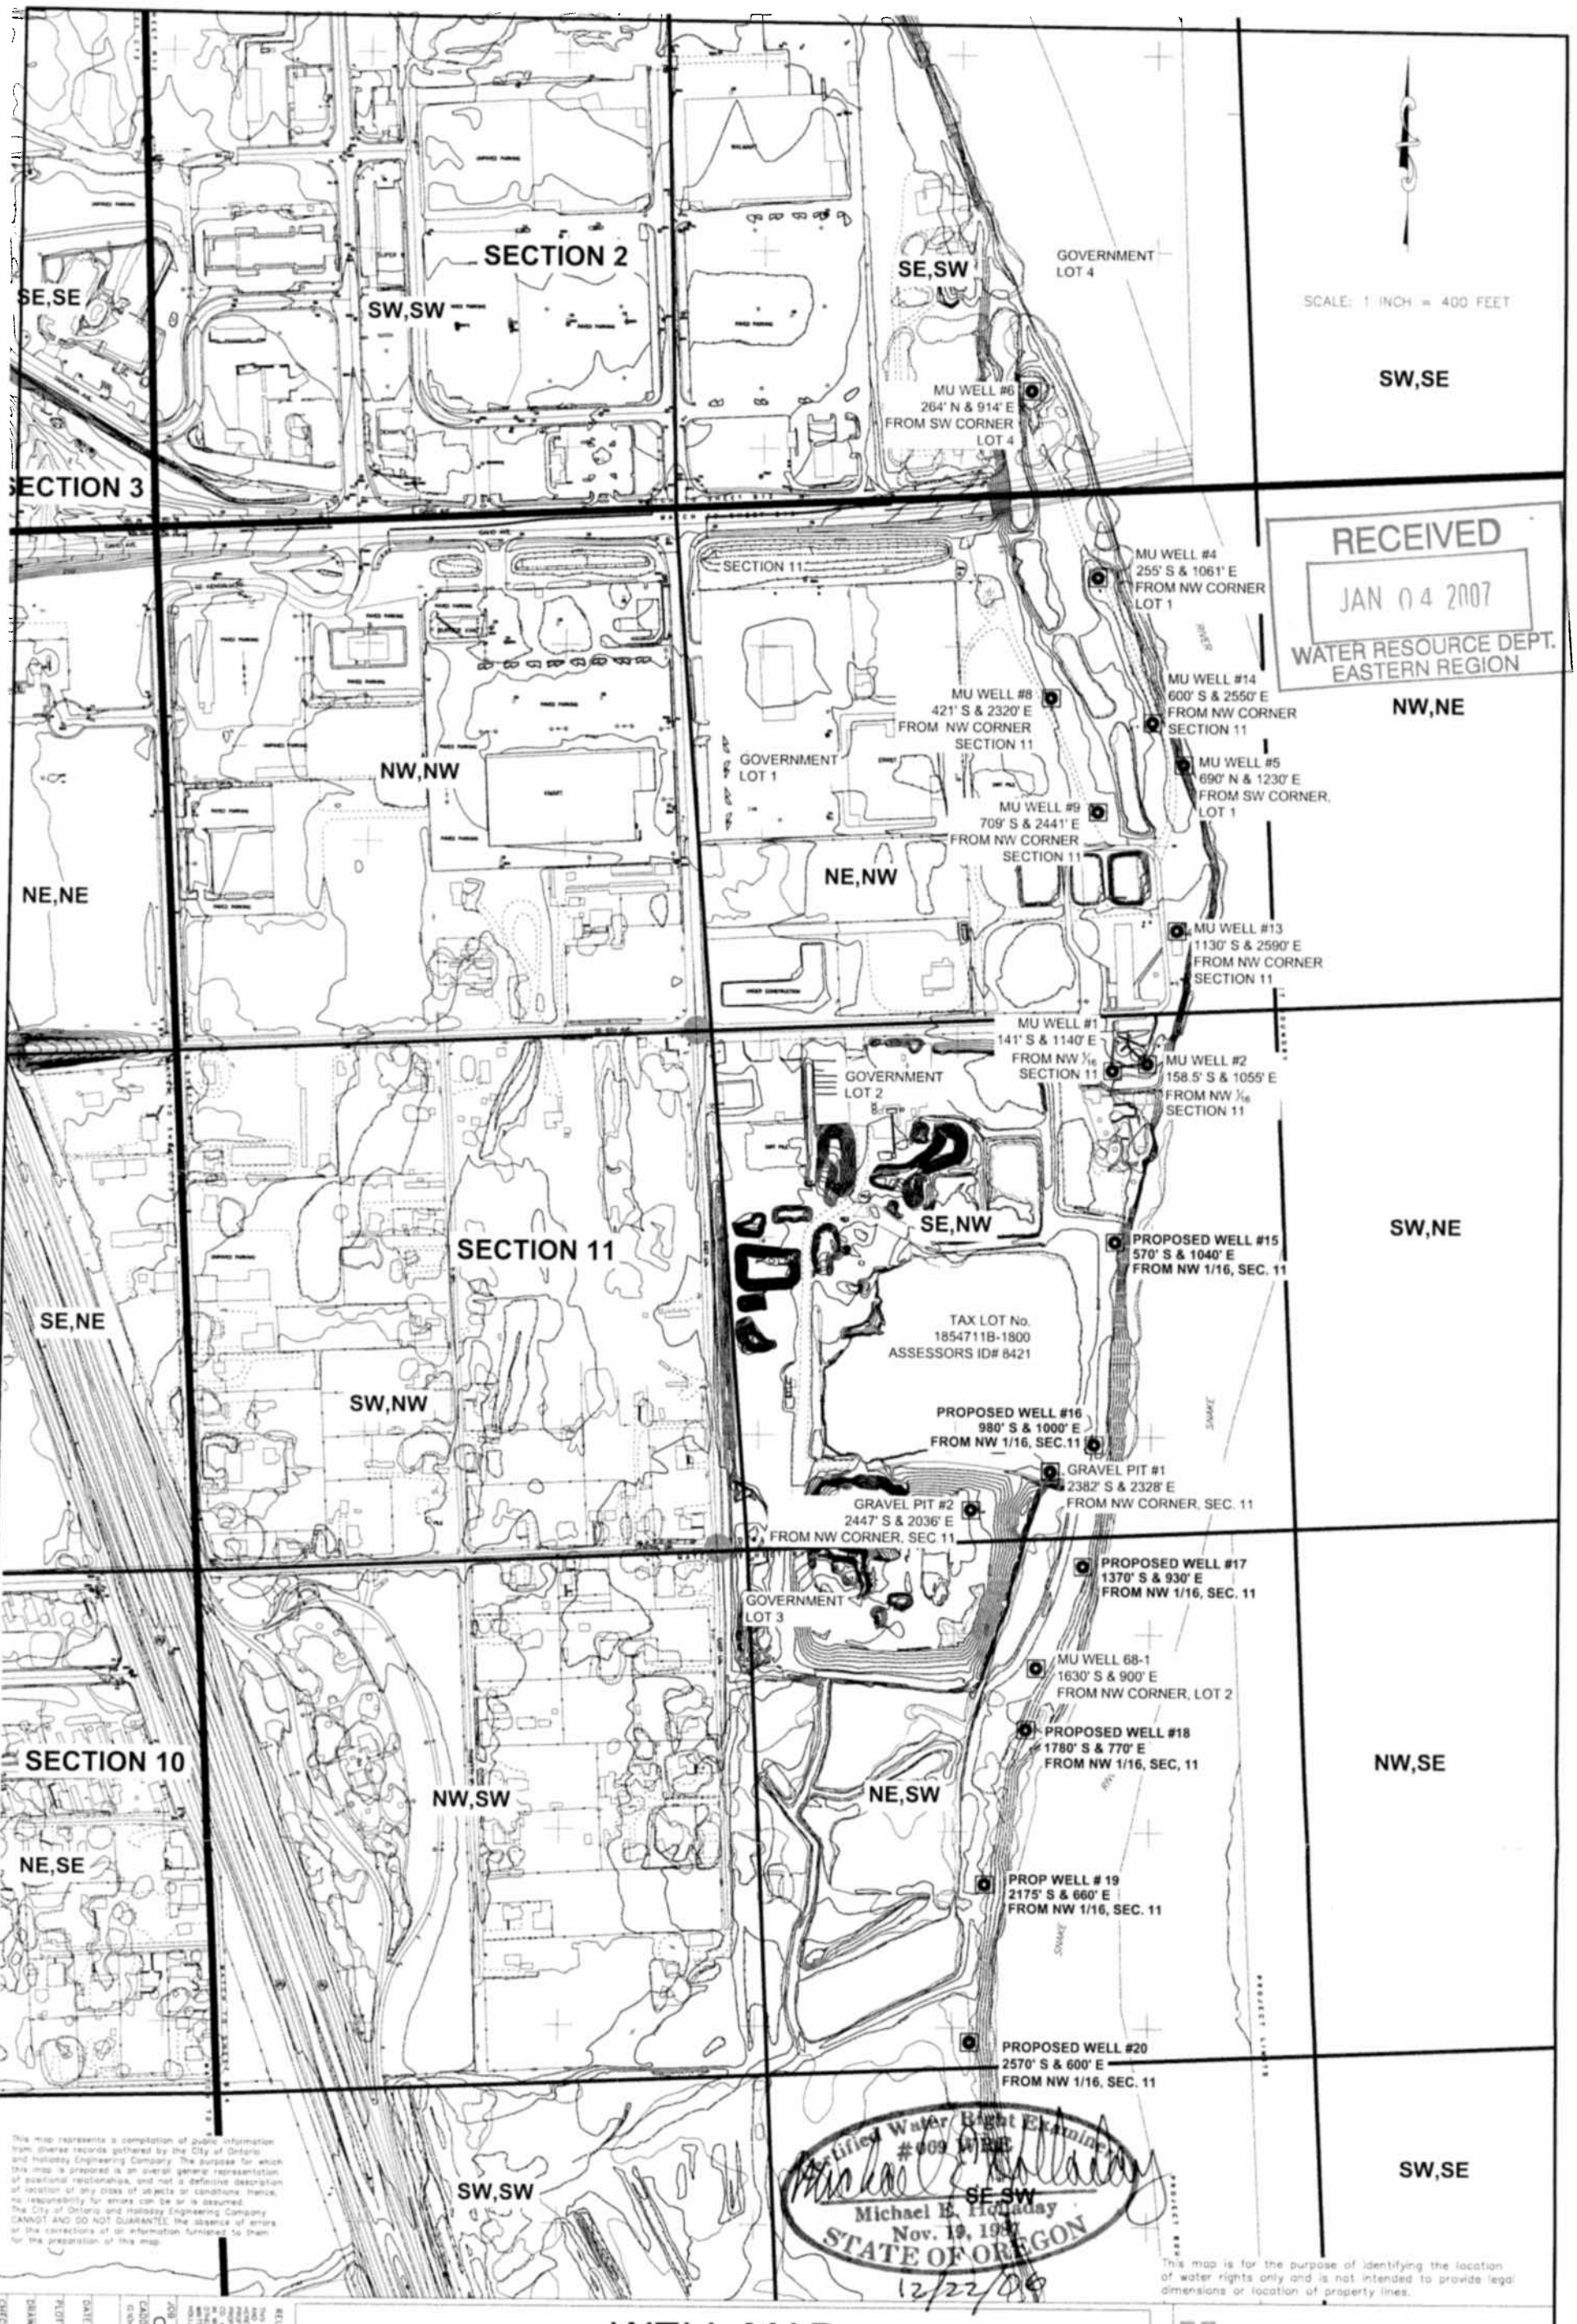
SECTION 2
SE,SE
SW,SW
SE,SW
GOVERNMENT LOT 4
SCALE: 1 INCH = 400 FEET
SW,SE
MU WELL #6
264' N & 914' E
FROM SW CORNER
LOT 4
SECTION 3
SECTION 11
MU WELL #4
255' S & 1061' E
FROM NW CORNER
LOT 1
RECEIVED
JAN 04 2007
WATER RESOURCE DEPT.
EASTERN REGION
NW,NE
MU WELL #14
600' S & 2550' E
FROM NW CORNER
SECTION 11
MU WELL #8
421' S & 2320' E
FROM NW CORNER
SECTION 11
GOVERNMENT LOT 1
NW,NW
MU WELL #5
690' N & 1230' E
FROM SW CORNER,
LOT 1
MU WELL #9
709' S & 2441' E
FROM NW CORNER
SECTION 11
NE,NE
NE,NW
MU WELL #13
1130' S & 2590' E
FROM NW CORNER
SECTION 11
MU WELL #1
141' S & 1140' E
FROM NW 1/16
SECTION 11
MU WELL #2
158.5' S & 1055' E
FROM NW 1/16
SECTION 11
GOVERNMENT LOT 2
SE,NW
SW,NE
PROPOSED WELL #15
570' S & 1040' E
FROM NW 1/16, SEC. 11
SECTION 11
SE,NE
TAX LOT No.
1854711B-1800
ASSESSORS ID# 8421
SW,NW
PROPOSED WELL #16
980' S & 1000' E
FROM NW 1/16, SEC.11
GRAVEL PIT #1
2382' S & 2328' E
FROM NW CORNER, SEC. 11
GRAVEL PIT #2
2447' S & 2036' E
FROM NW CORNER, SEC. 11
PROPOSED WELL #17
1370' S & 930' E
FROM NW 1/16, SEC. 11
GOVERNMENT LOT 3
MU WELL 68-1
1630' S & 900' E
FROM NW CORNER, LOT 2
PROPOSED WELL #18
1780' S & 770' E
FROM NW 1/16, SEC, 11
SECTION 10
NW,SW
NE,SW
NW,SE
NE,SE
PROP WELL # 19
2175' S & 660' E
FROM NW 1/16, SEC. 11
PROPOSED WELL #20
2570' S & 600' E
FROM NW 1/16, SEC. 11
SW,SW
SE,SW
SW,SE
Certified Water Right Examiner
#009 WRE
Michael E. Holladay
Nov. 19, 1997
STATE OF OREGON
12/22/06
This map represents a compilation of public information from diverse records gathered by the City of Ontario and Holladay Engineering Company. The purpose for which this map is prepared is an overall general representation of positional relationships, and not a definitive description of location of any class of objects or conditions. Hence, no responsibility for errors can be or is assumed. The City of Ontario and Holladay Engineering Company CANNOT AND DO NOT GUARANTEE the absence of errors or the correctness of all information furnished to them for the preparation of this map.
This map is for the purpose of identifying the location of water rights only and is not intended to provide legal dimensions or location of property lines.
WELL MAP
CITY OF ONTARIO, OR
HOLLADAY ENGINEERING CO.
ENGINEERS · CONSULTANTS
32 N. MAIN P.O. BOX 235 PAYETTE, ID 83661
(208) 642-3304 - FAX# (208) 642-2159
EMAIL: hec@holladayengineering.com
JOB NO. ON 031903.A
CADD FILE:
DATE 09/19/03
PLOTTED 11/15/06
DRAWN BY: MGM
CHECKED BY: MEH
SHEET
REUSE OF DOCUMENTS