


T.6S., R.3W., W.M.

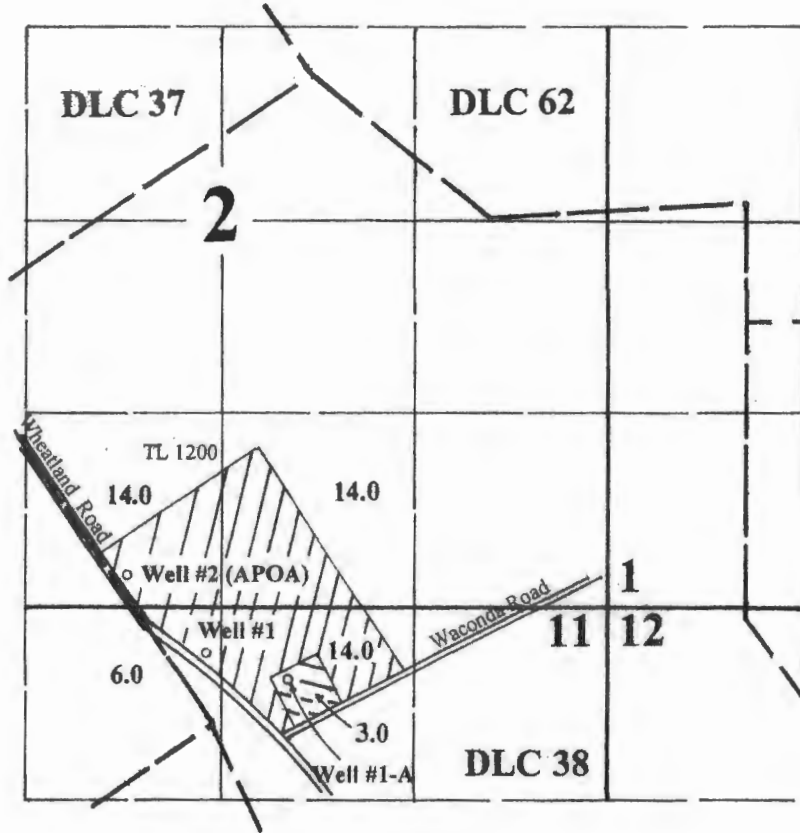

Well #1 is located 462' S & 2,574' E from the NW corner of Section 11.
 Well #1-A is located 520' S & 450' E from the N-1/4 corner of Section 11.
 Well #2 (APOA) is located 230' N and 650' W from the N-1/4 corner of Section 11.

Application Map

RECEIVED


SEP 29 2016

Westwood Farms

WATER RESOURCES DEPT
 SALEM, OREGON

Transfer #:

This Map was Prepared for the Purpose of Identifying the Location of a Water Right Only and is Not Intended to Provide Legal Dimensions or Location of Property Ownership Lines

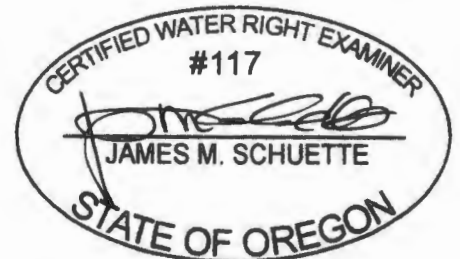

T 12494

EXPIRES: _____