



Application Map A POA transfer

Tax Lots 100, 101, 102
Map 14-10-28

RECEIVED BY OWRD

OCT 20 2016

SALEM, OR

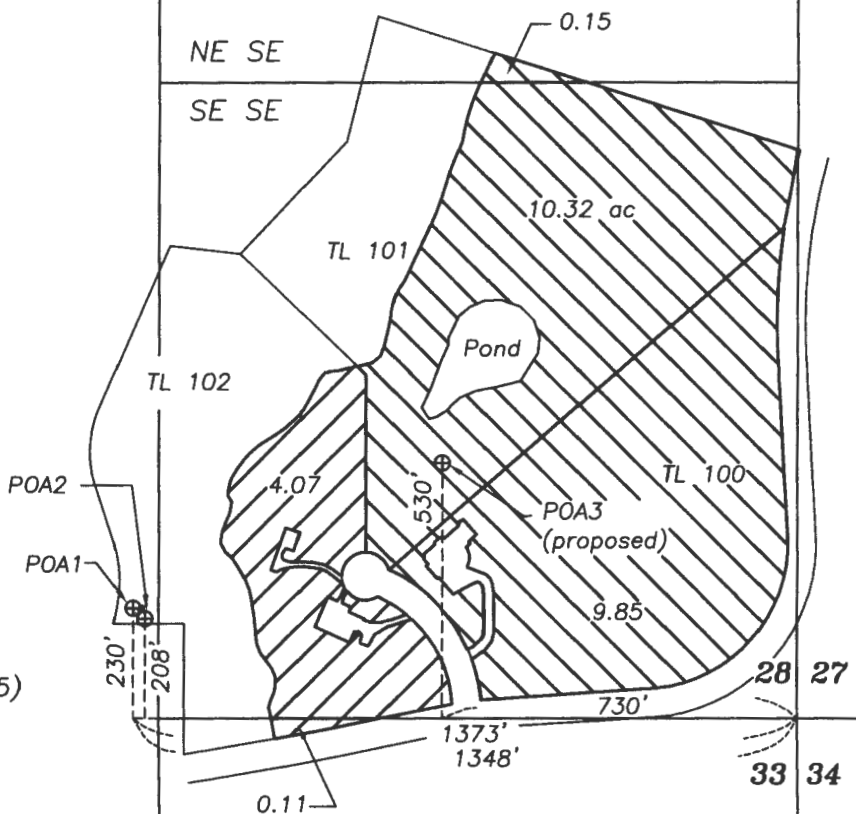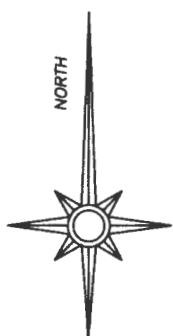


Changes to make to Certificate
89686 (priority date 2/14/1995)



Transfer to POA 2



Transfer to POA 3

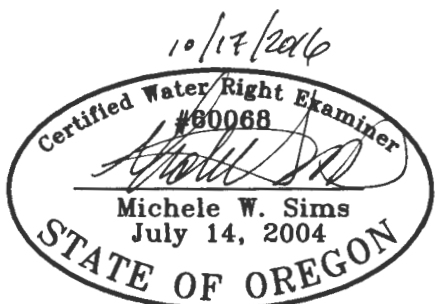

Renewal date: 6/30/2018

This map is for the purpose of identifying the location of the water right. It is not intended to provide legal dimensions or locations of property ownership lines.

