


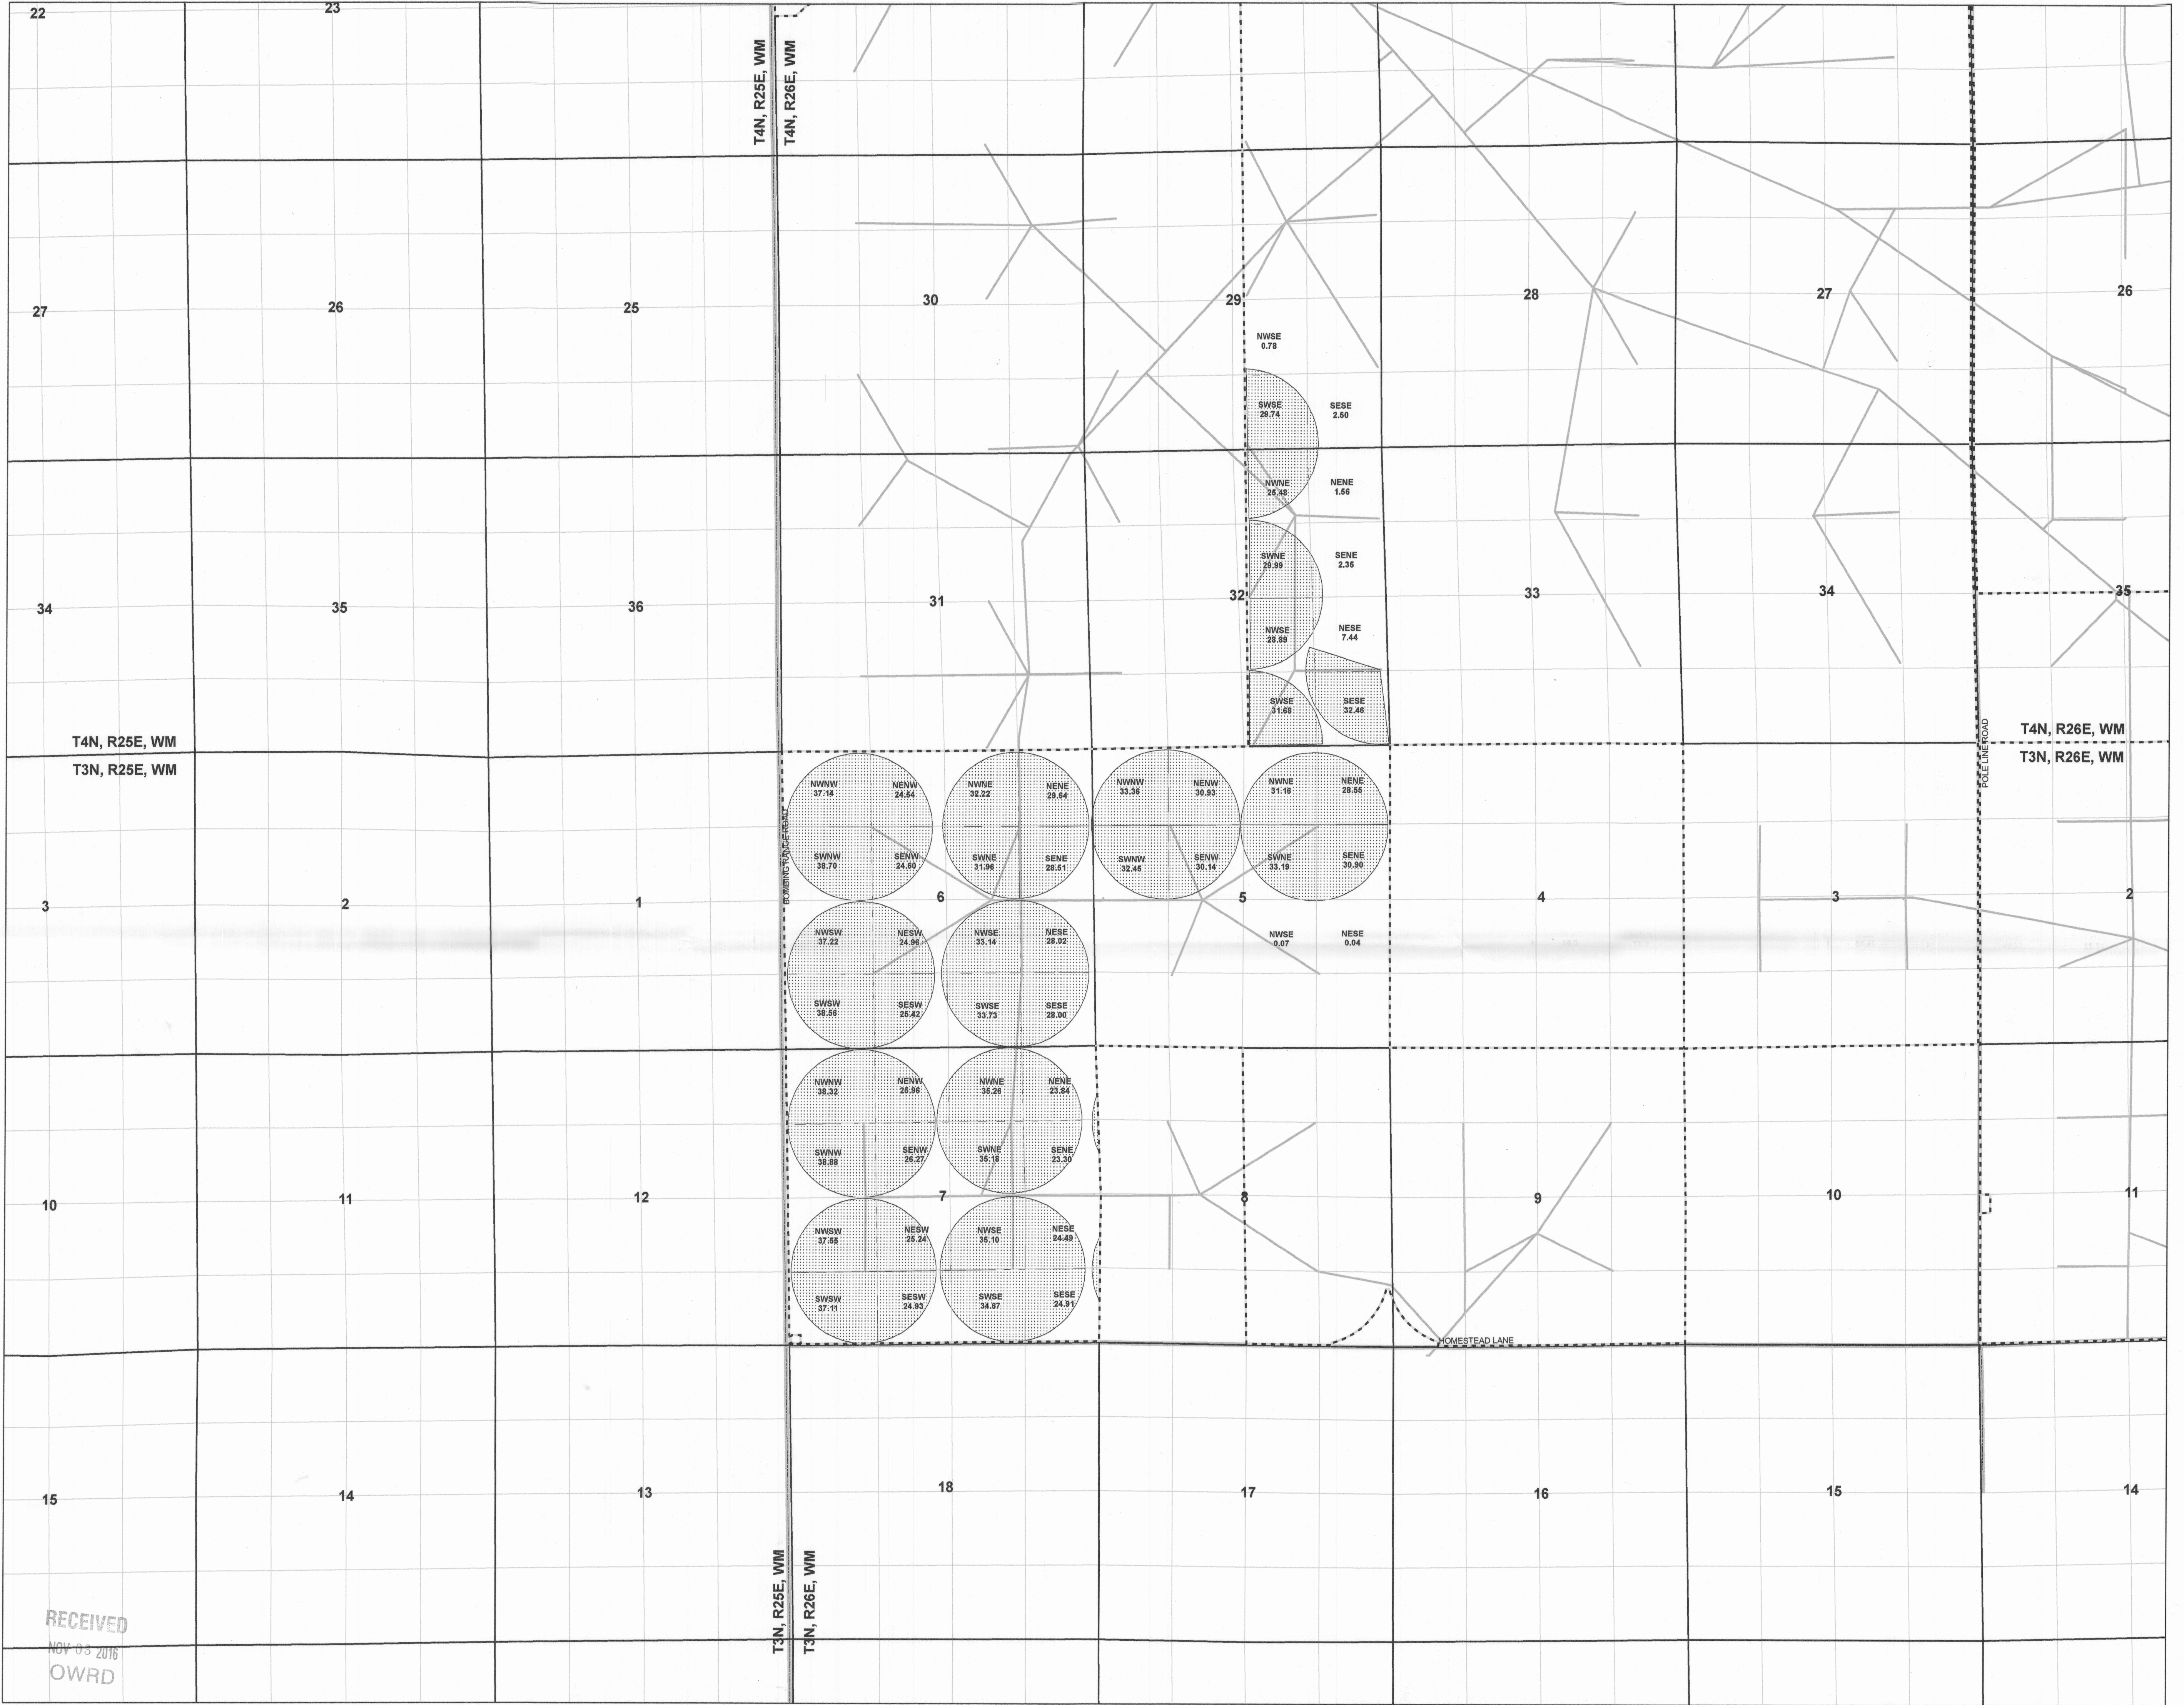

LEGEND

- FRI Property Boundary
- To Lands (Revised POU after this Transfer)
- PLSS Sections
- Water Bodies
- Railroads
- Pipelines
- Paved Roads

SESE 30.52 Quarter Quarter Section Location and Water Right POU Acres

This drawing is an exhibit for a Water Right Permanent Transfer. This map is not intended to provide legal dimensions or locations of property ownership lines. Property lines and/or other lines of occupation shown hereon are not represented by the undersigned to meet accuracy standards of Land Surveys.


CWRE: Jason Smead
Drawn By: Edward Douglas
Date: October 2016
Projection: NAD83 Oregon Statewide Lambert, International Feet

STATE OF OREGON
Certified Water Rights Examiner
Jason K. Smead
July 12, 2005
#61438WRE

EXPIRATION DATE: 6/30/2018

Proposed Place of Use (POU) Map
Permanent Water Rights Transfer
Certificate 83592
Farmland Reserve Inc.
Boardman, Oregon Farm

T3N, R26E, WM and T4N, R26E, WM
Morrow County, Oregon

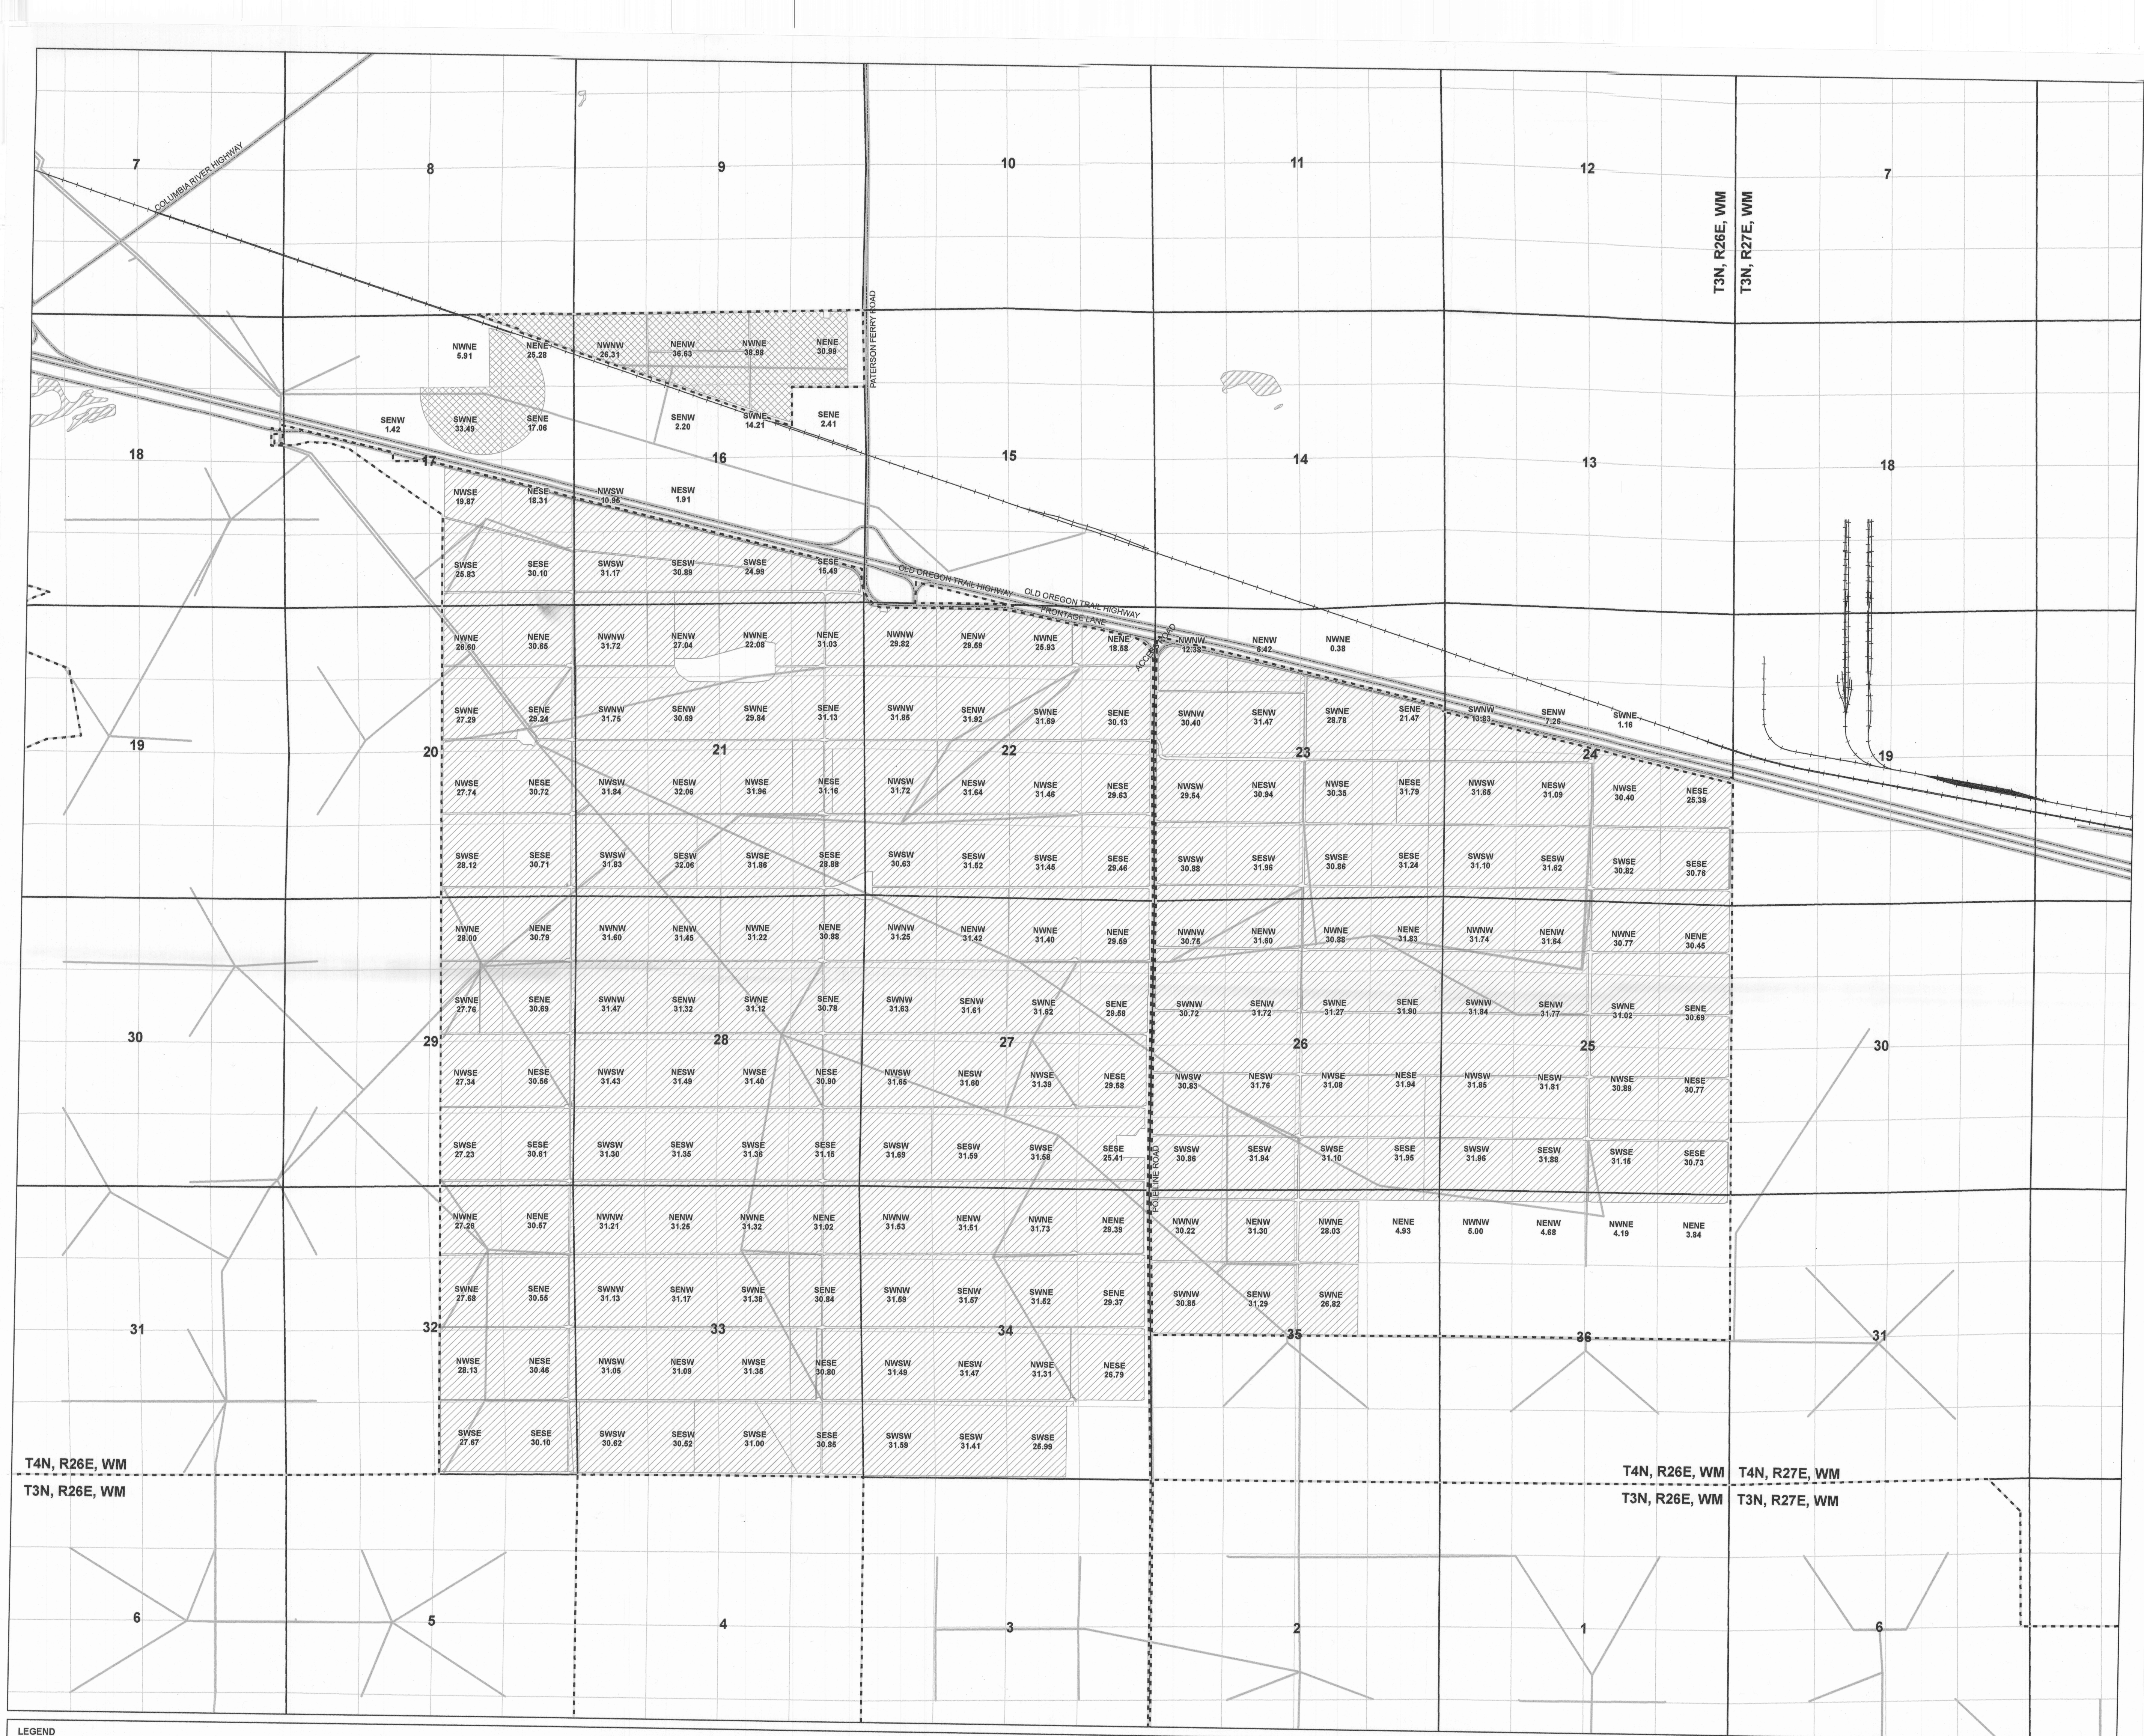

LEGEND

- FRI Property Boundary
- From Lands (Existing POU Associated with this Transfer)
- Lands Left Unchanged (Remaining Right)
- PLSS Sections
- Quarter Quarter Section Location and Water Right POU Acres
- Water Bodies
- Railroads
- Pipelines
- Paved Roads

This drawing is an exhibit for a Water Right Permanent Transfer. This map is not intended to provide legal dimensions or locations of property ownership lines. Property lines and/or other lines of occupation shown hereon are not represented by the undersigned to meet accuracy standards of Land Surveys.

CWRE: Jason Smead
Drawn By: Edward Douglas
Date: October 2016
Projection: NAD83 Oregon Statewide Lambert, International Feet

0 660 1,320
Feet
1 inch = 1,320 feet

RECEIVED
NOV 03 2016
OWRD

Certified Water Rights Examiner
Jason K. Smead
July 12, 2005
STATE OF OREGON

Existing Place of Use (POU) Map
Permanent Water Rights Transfer
Certificate 89511
Farmland Reserve Inc.
Boardman, Oregon Farm

T3N, R26E, WM and T4N, R26E, WM
Morrow County, Oregon

The POU consists of 8 foot wide irrigated strips located on 10 foot centers marked by the tree rows

ch2m.