




- (xx.x)
IRR. ACRES
IN 1/4 1/4
- 
IRR. ACRES
- (x.x)
PENDING
- 
PENDING ACRES
- (x.x)
PRIVATE
- 
PRIVATE ACRES
-
PROPERTY LINE IF
OTHER THAN 1/4 1/4



SCALE: 1" = 400'

SEC. 4 , T.22 S., R.46 E., W.M.


48-102-1584

RECEIVED BY OWRD

DINN: 2016-02
OFF MAP
Tax Lot 501 22S46E04 SWSE
OFF .5 Acres Total

DINN: 2016-02
OFF MAP
T 12556
Tax Lot 501 22S46E04 NESE
OFF 1.0 Acres Total

JAN 05 2017
SALEM, OR

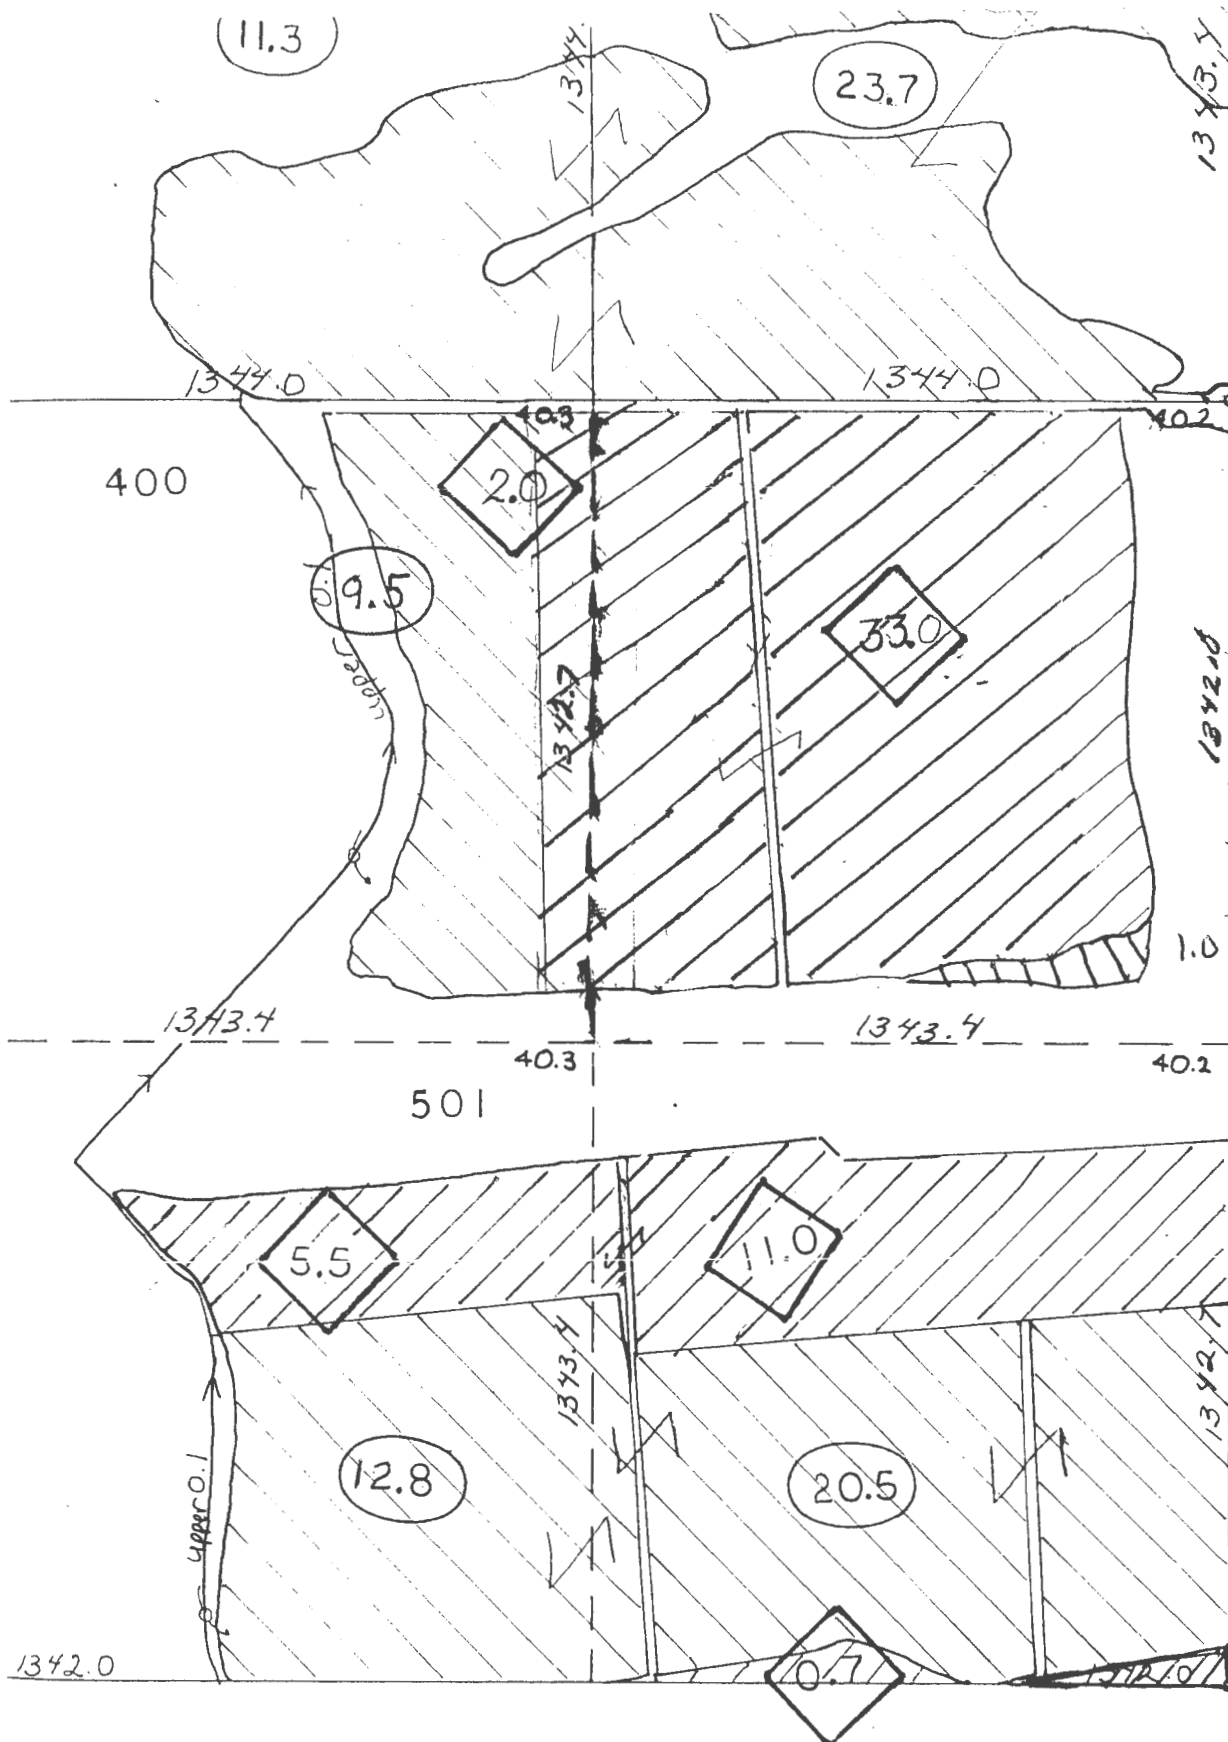

- (xx.x)
IRR. ACRES
IN 1/4 1/4
- [Hatched Box]
IRR. ACRES
- (x.x)
PENDING
- [Hatched Box]
PENDING ACRES
- (x.x)
PRIVATE
- [Vertical Lines Box]
PRIVATE ACRES
-
PROPERTY LINE IF
OTHER THAN 1/4 1/4

1.0 Ac ON

SCALE: 1" = 400'
0.5 Ac ON

SEC. 4 , T.22 S., R.46 E., W.M.


48-102-1584

RECEIVED BY OWRD

DINN: 2016-02
ON MAP
Tax Lot 501 22S46E04 NESE T 12556
ON 1.0 Acres Total

DINN: 2016-02
ON MAP
Tax Lot 501 22S46E04 SESE
ON .5 Acres Total

JAN 05 2017
SALEM, OR

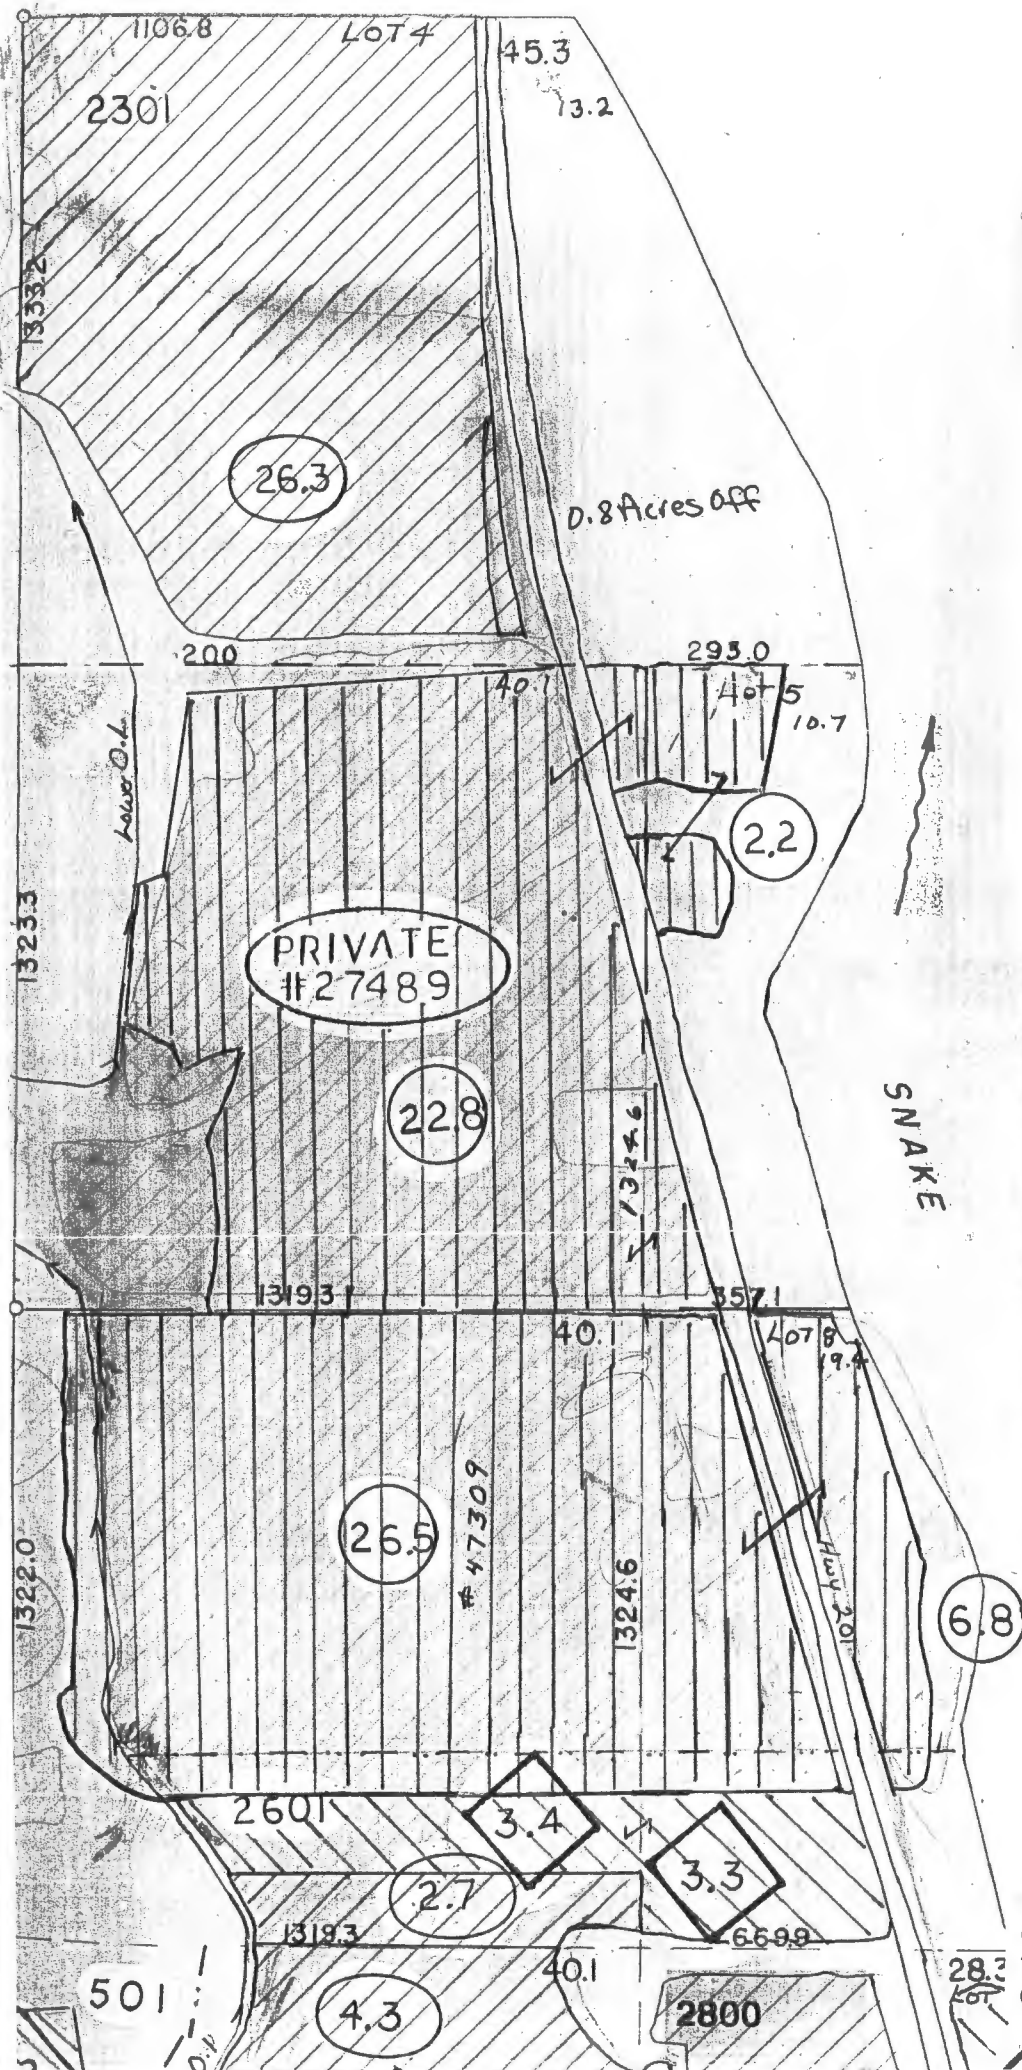

SCALE: 1" = 400'

SNAKE

3

RECEIVED BY OWRD


JAN 05 2017

SALEM, OR

T 22S R 46E Sec 3

DINN: 2016-02
 OFF MAP
 Tax Lot 500 22S46E03 Gov. Lot 4 NWNW
 OFF .8 Acres Total

T 12556

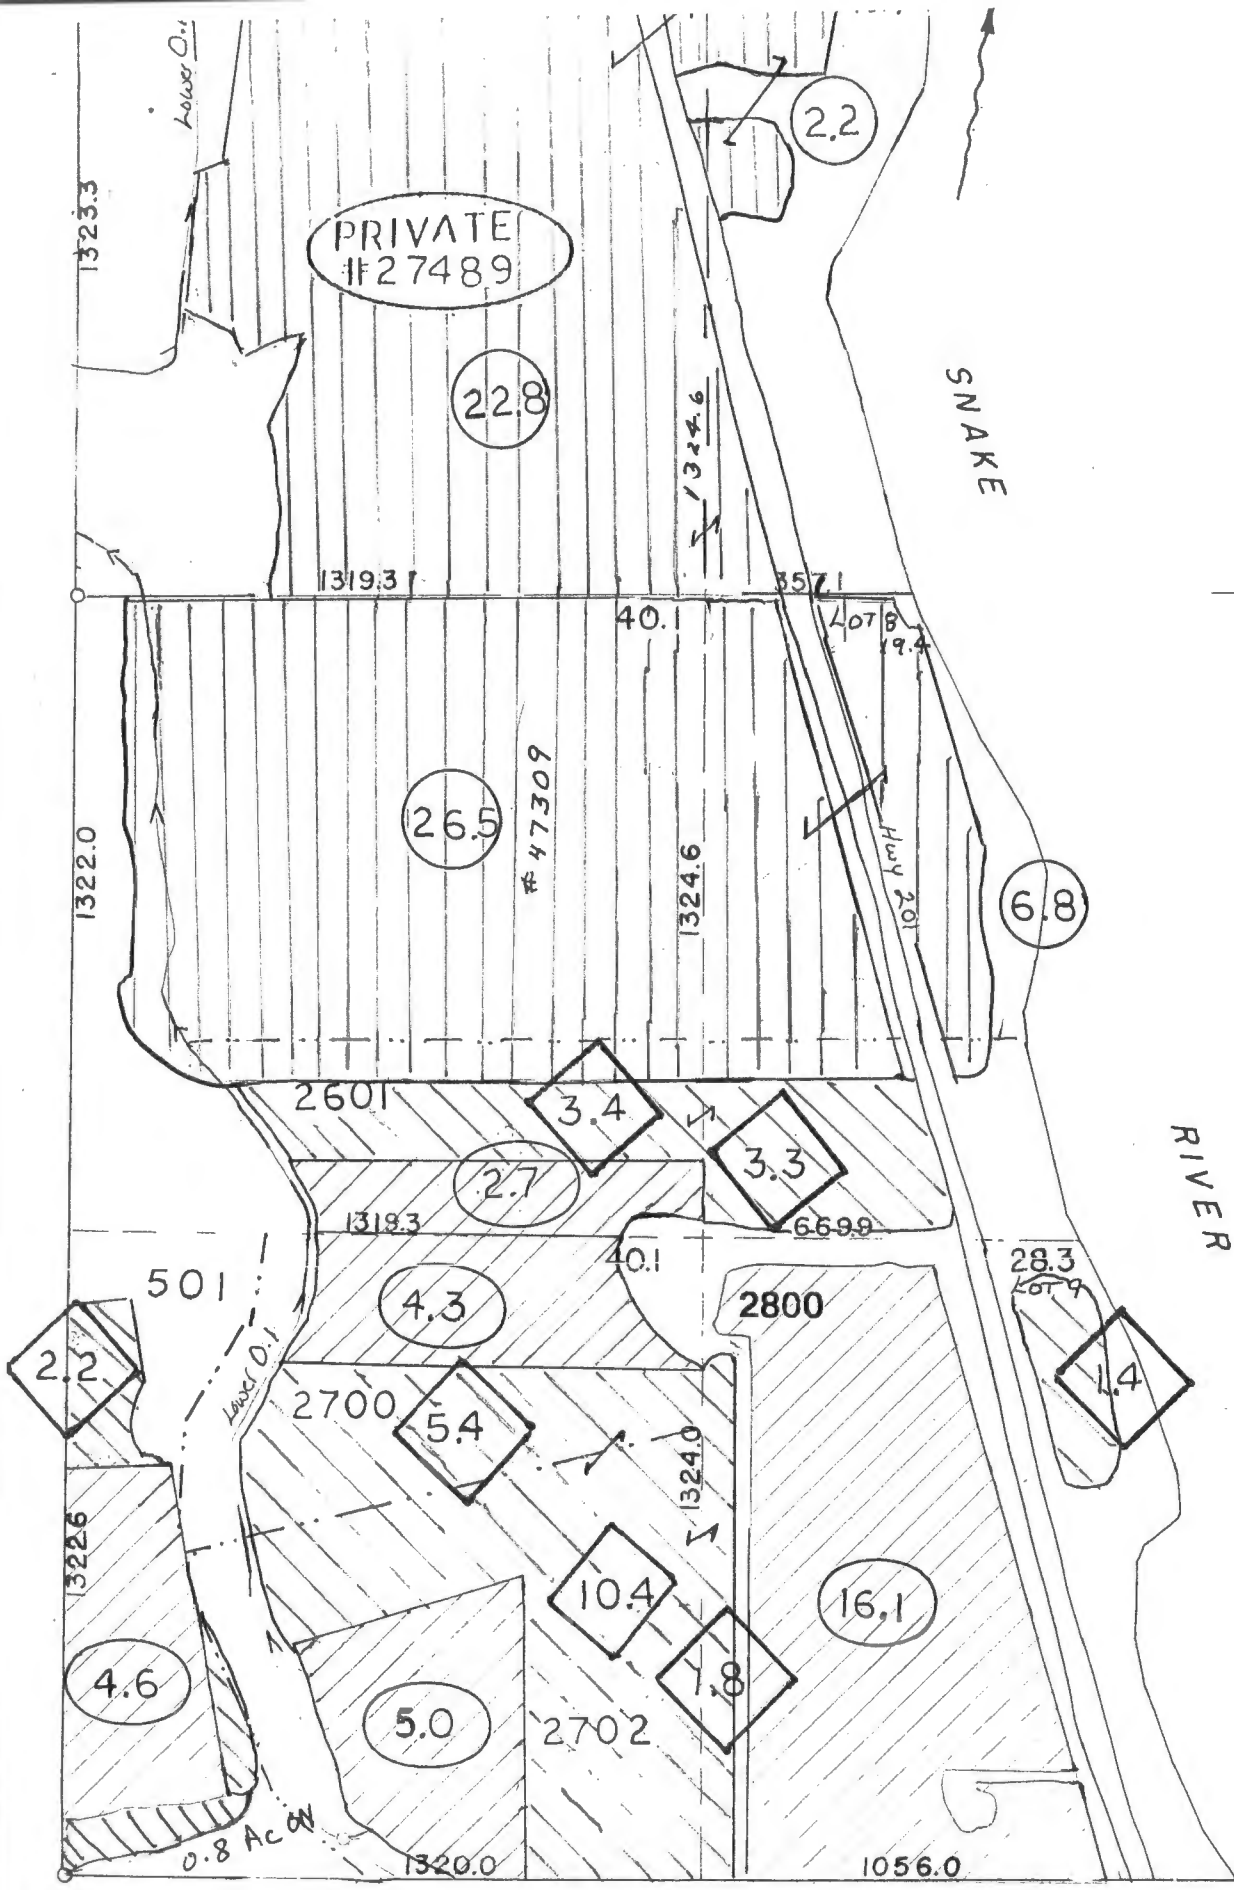

3

RECEIVED BY OWRD
 JAN 05 2017
 SALEM, OR




SCALE: 1" = 400'

Sec 3 T22S R46E

T 12556

CORNER
 3

DINN: 2016-02
 ON MAP
 Tax Lot 1800 22S46E03 SWSW
 ON .8 Acres Total

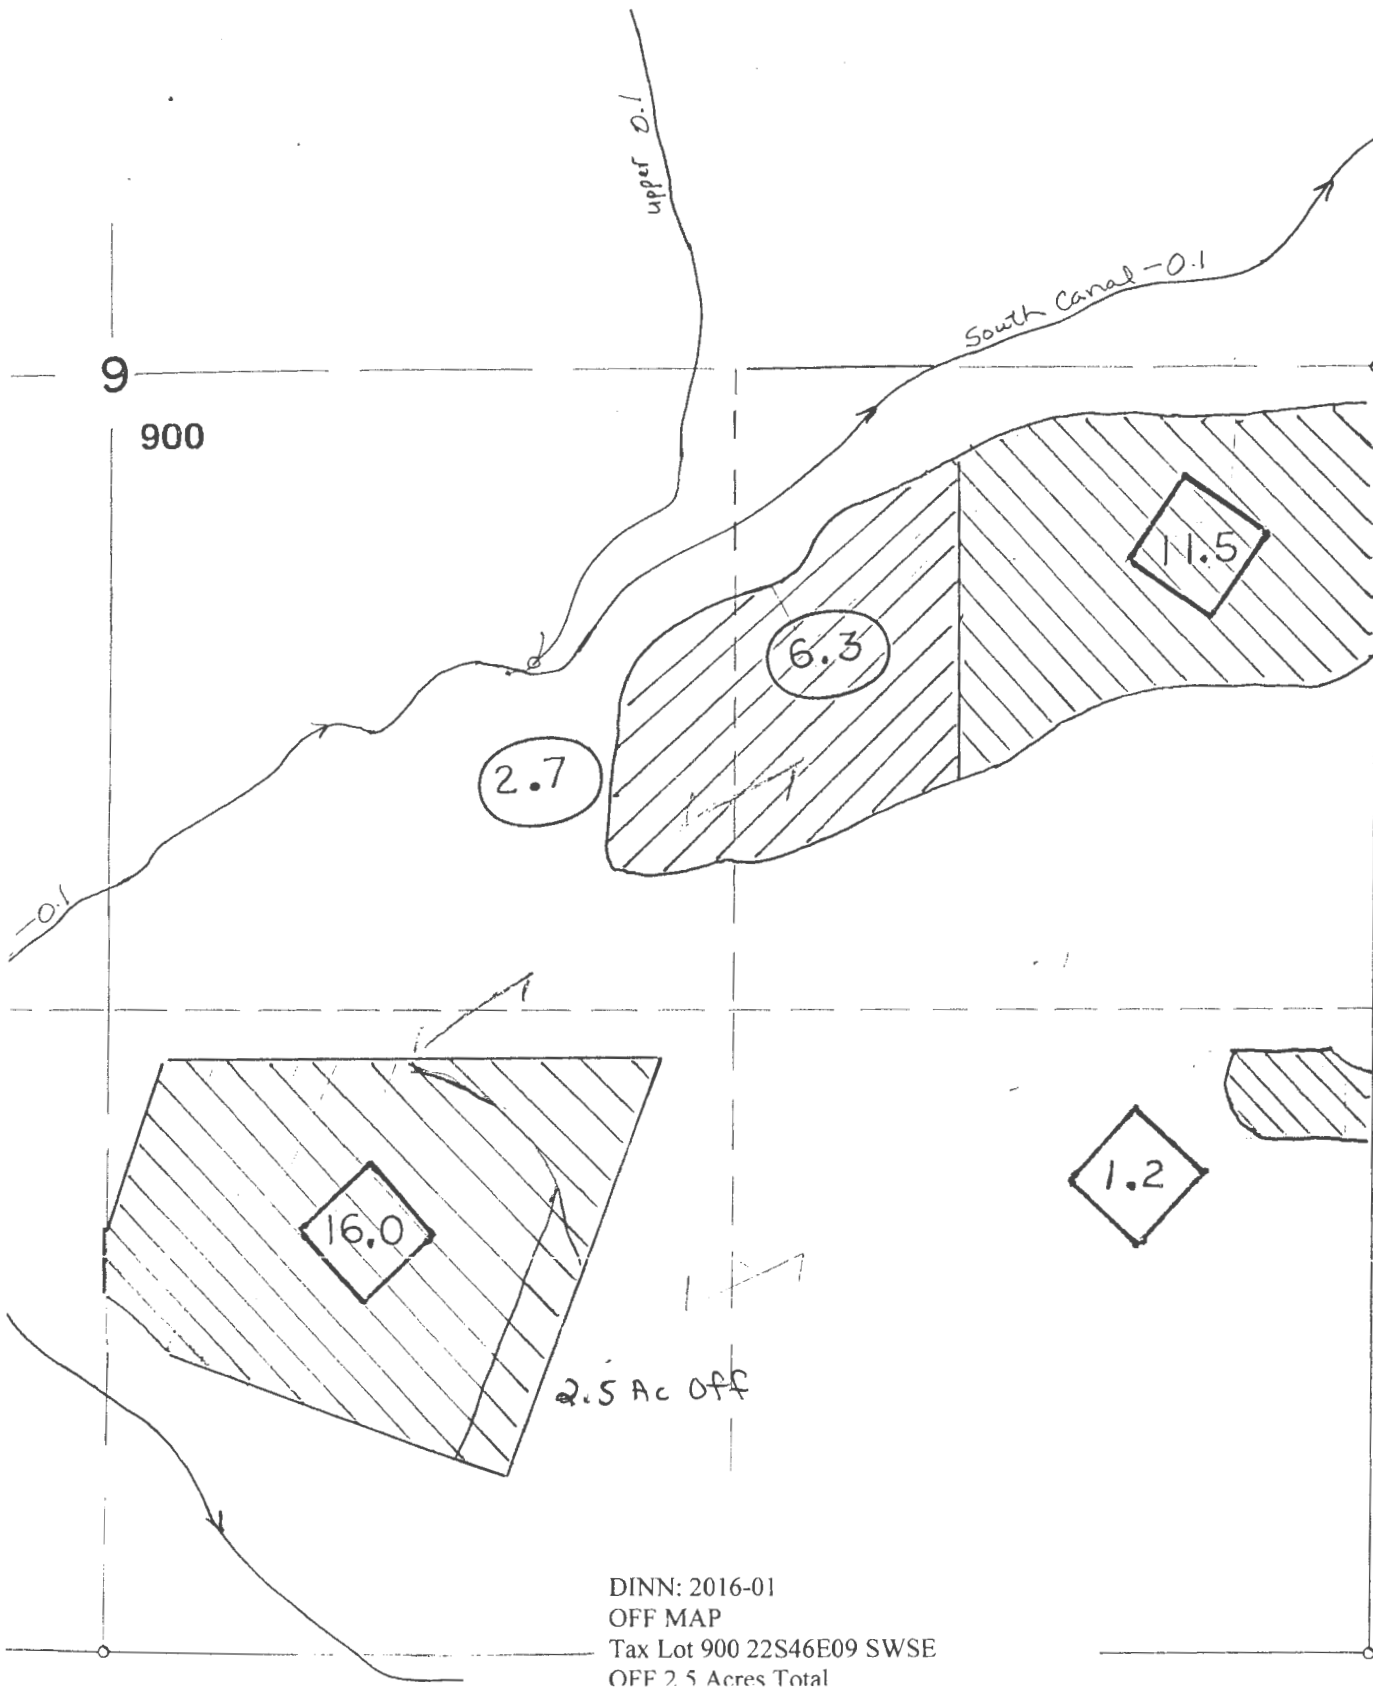

- (xx.x)
IRR. ACR
IN 1/4 1.
- [Hatched Box]
IRR. ACR
- (x.x)
PENDING
- [Hatched Box]
PENDING
- (x.x)
PRIVATE
- [Vertical Lines Box]
PRIVATE
- PROPERTY
OTHER TH



DINN: 2016-01
 OFF MAP
 Tax Lot 900 22S46E09 SWSE
 OFF 2.5 Acres Total

SCALE:
 1" = 400'
 SOUTHEAST
 OF SECTION 10

SEC. 9, T.22 S., R.46 E., W.M.


48-102-15:

RECEIVED BY OWRD

JAN 05 2017

T 12556

SALEM, OR

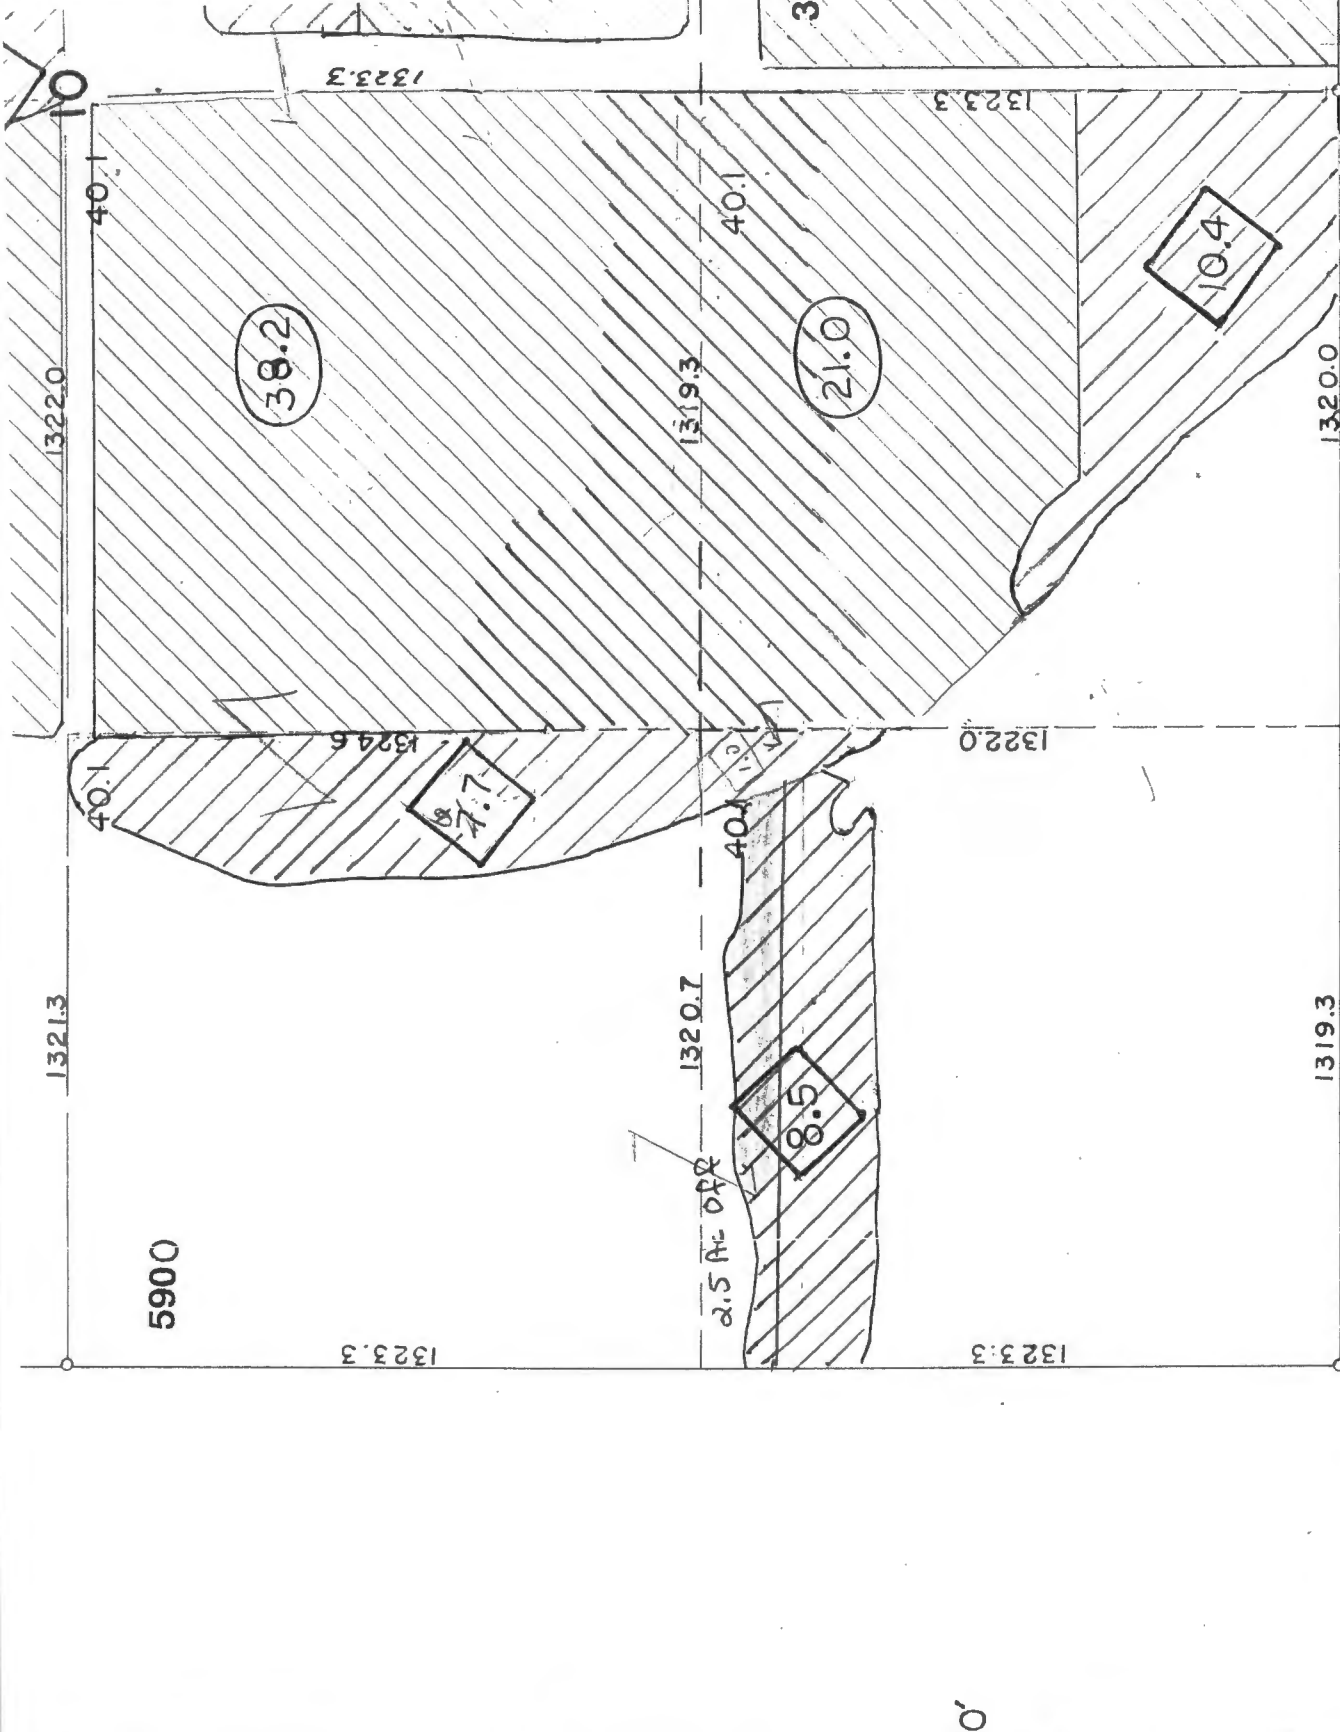

SOUTHWEST CORNER
OF SECTION 10

DINN: 2016-01
OFF MAP
Tax Lot 1100 22S46E10 SWSW
OFF 2.5 Acres Total


Troced: R.W.R. 4-15-53
Checked: R.E. 6-20-55


SCALE: 1" = 400'

12556

RECEIVED BY OWFD

JAN 05 2017

SALEM, OR

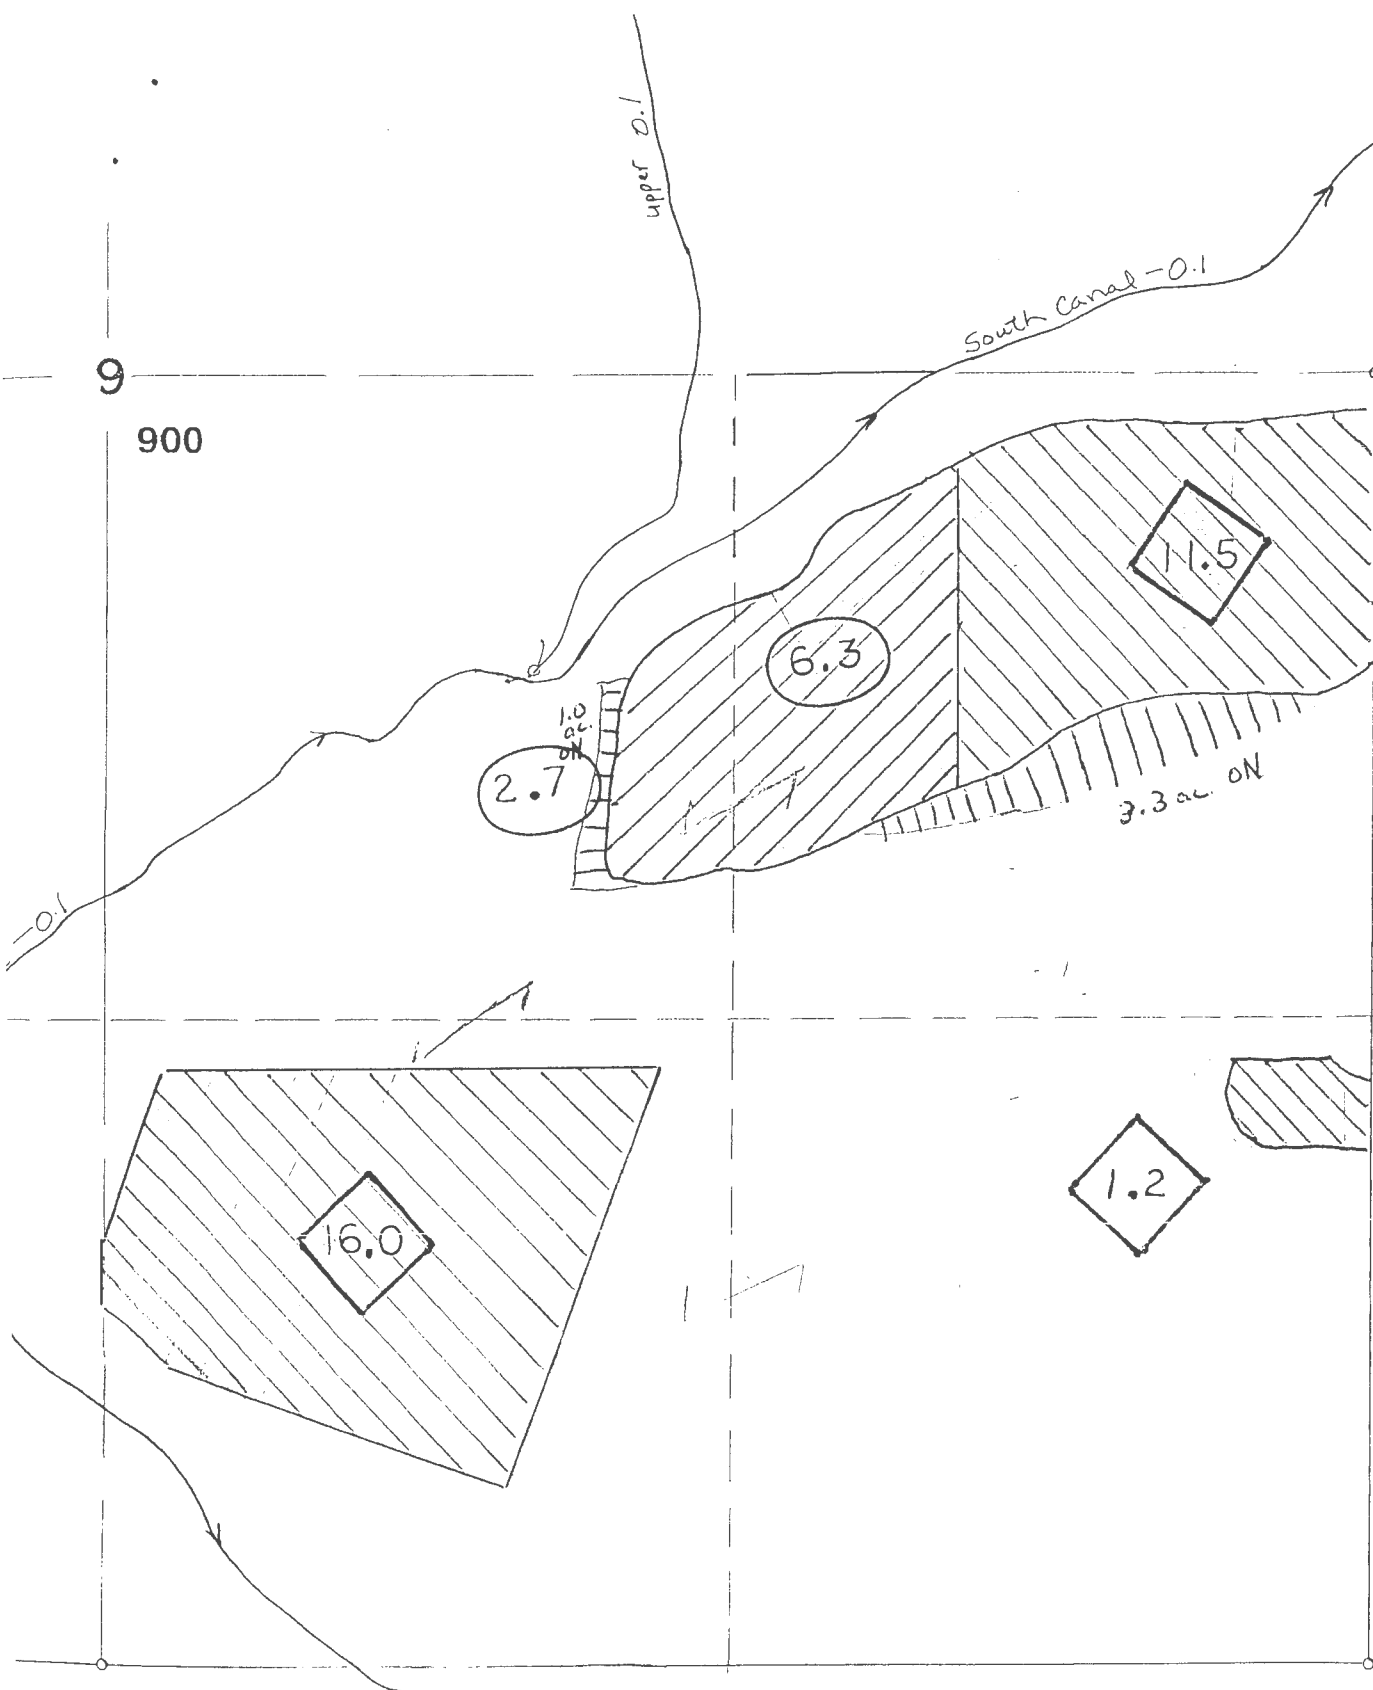

- (xx.) IRR. AC IN 1/4
- [Hatched Box] IRR. AC
- [Diamond with x.x] PENDING
- [Hatched Box] PENDING
- [Circle with x.x] PRIVATE
- [Vertical Lines Box] PRIVATE
- [Dotted Line] PROPERTY
- [Solid Line] OTHER T



SCALE:
1" = 400'
SOUTHEAST
OF SECTION

SEC. 9, T.22 S., R.46 E., W.M.

48-102-152

RECEIVED BY OWRD

DINN:2016-01
ON MAP
Tax Lot 900 22S46E09 NWSE
ON 1.0 Acres Total

DINN: 2016-01
ON MAP
Tax Lot 900 22S46E09 NESE
ON 3.3 Acres Total

JAN 05 2017

T 12556 SALEM, OR



SCALE: 1" = 400'

RECEIVED BY OWRD

JAN 05 2017

SALEM, OR

1 12556



SOUTHWEST CORNER OF SECTION 10

Sec 10 Taas R46E

DINN: 2016-01
 ON MAP
 Tax Lot 1100 22S46E10 NWSW
 ON 0.7 Acres Total

Traced: R.W.R. 4-15-53
 Checked: R.E. 6-20-55