



Application for Transfer of Water Right
Certificate 91901
Wild Waters Revocable Living Trust






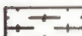
N

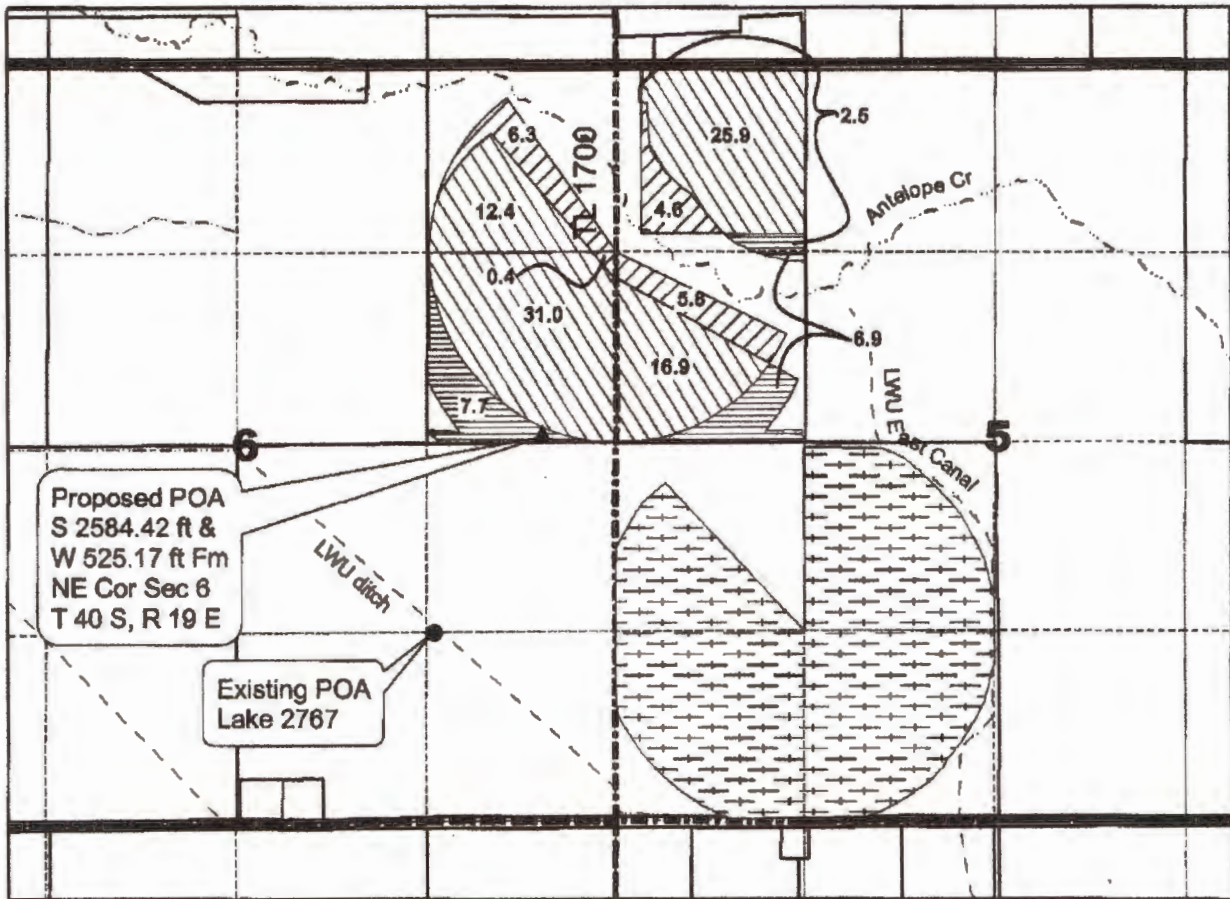

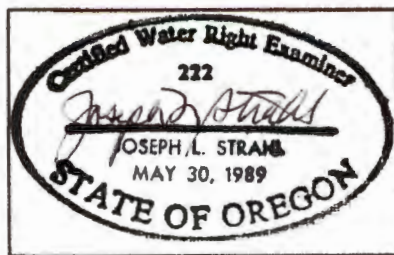1 inch = 1,320 feet



Legend

-  Trans From POU
 -  POU unchanged new POA
 -  Trans POA & POU to
 -  Cert 91901 no change
- Using new POA {

RECEIVED BY OWRD

FEB 27 2017

SALEM, OR

Note: This map for water right purposes only. It is not intended for use to represent the location of property lines.

T 12595