


T.6S.,R.1W.,W.M.

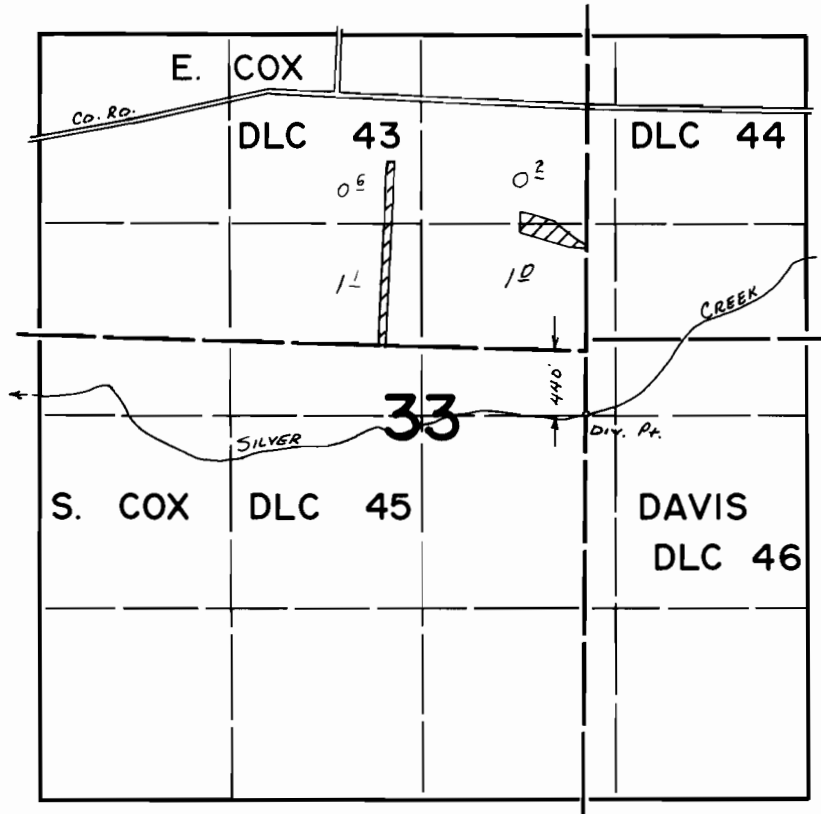

FINAL PROOF SURVEY UNDER

Transfer No. 3021
Application No. 51852..... Permit No. 39039.....
IN NAME OF

LEROY E. BEALS

Surveyed Aug. 11, 1976, by L. Tall.....
MAR 16 1978 S. P. APPLGATE