



T. 2S, R. 3E, W.M.

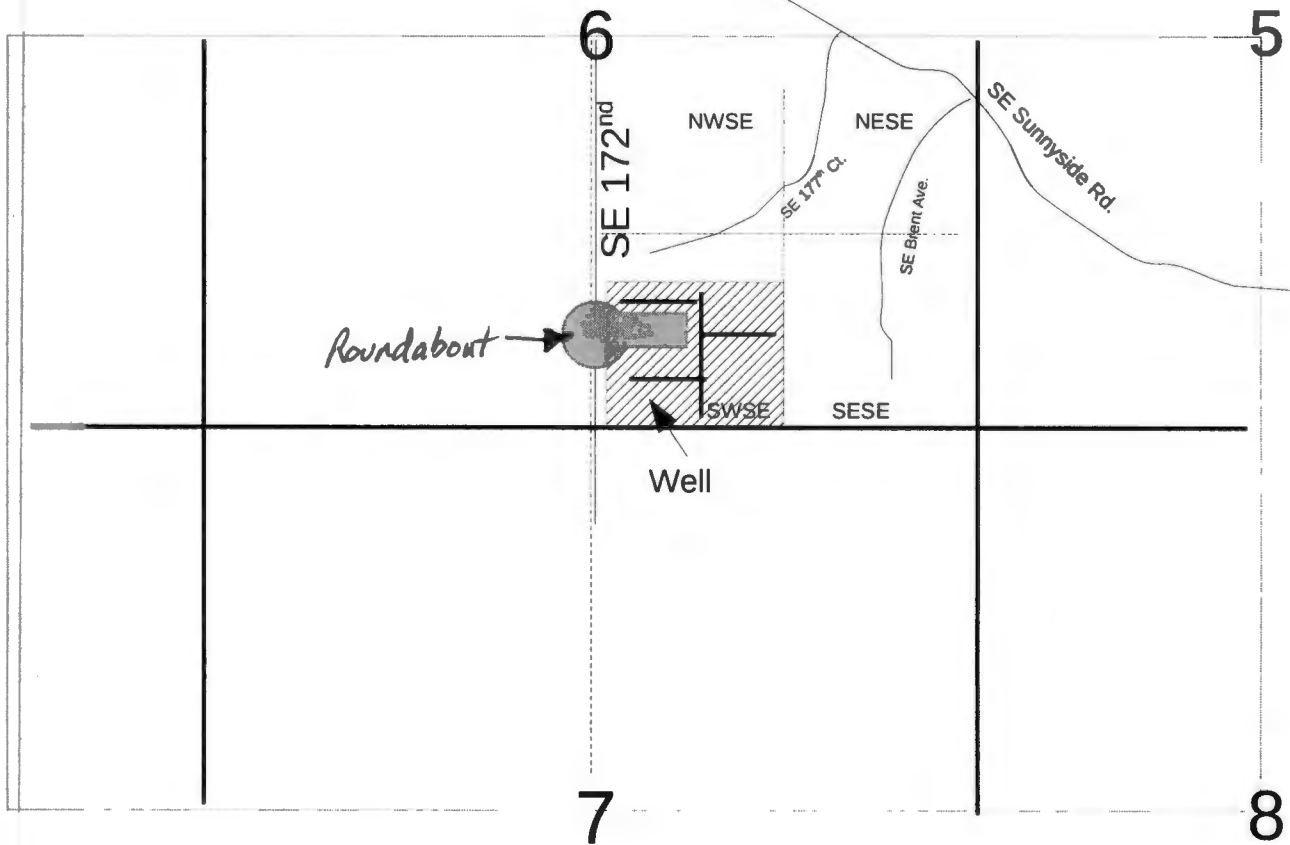

Scale: 1 inch = 1,320 feet

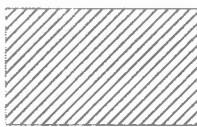

= Tax lot 400, 15.5 acres, water right cert. 29292 priority date Sept. 1957



= water delivery pipe

Roundabout =



RECEIVED BY OWRD

MAY 03 2017

SALEM, OR


RECEIVED BY OWRD

APR 24 2017


SALEM, OR

T 12658

T. 2S, R. 3E, W.M.

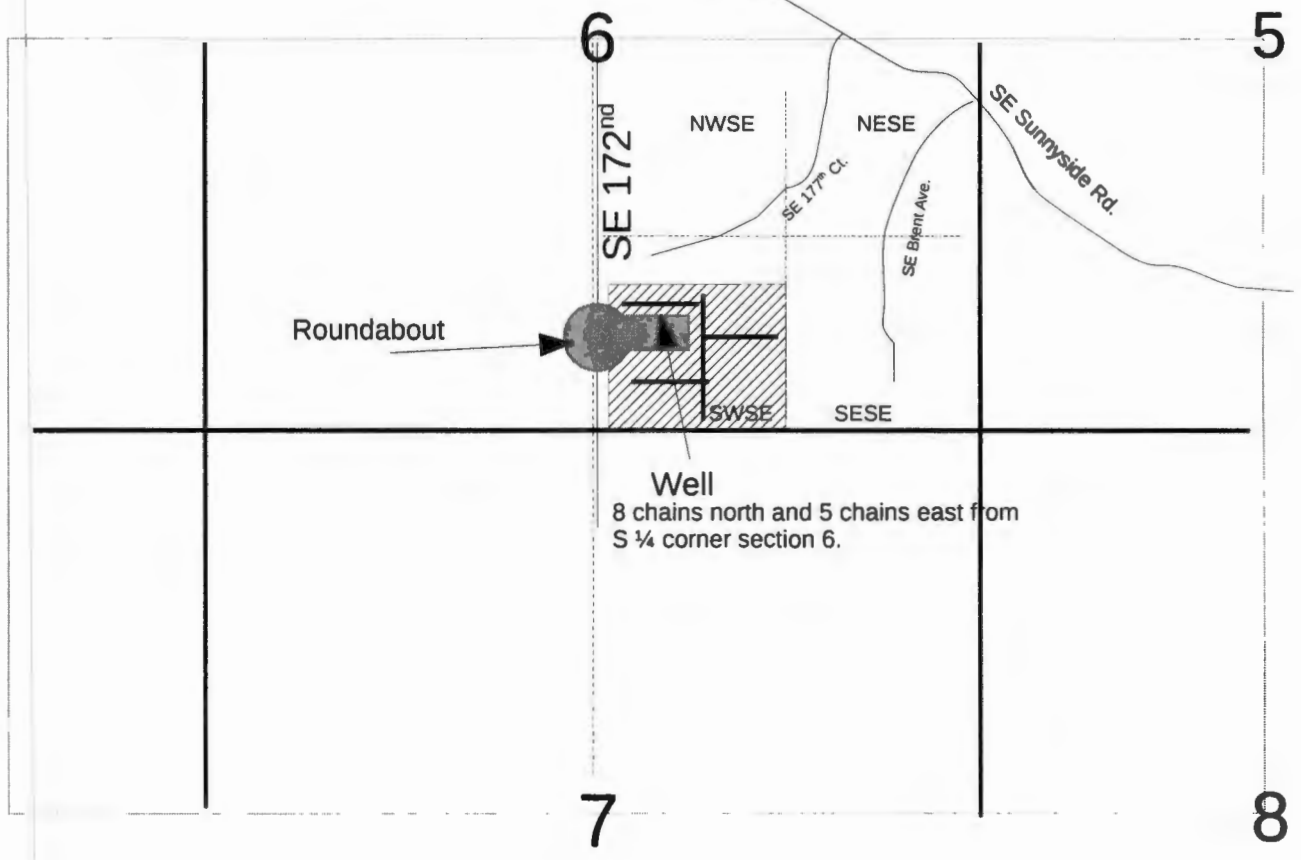

Scale: 1 inch = 1,320 feet

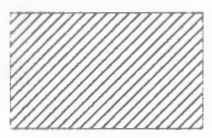

= Tax lot 400, 15.5 acres, water right cert. 29292 priority date Sept. 1957

..... = water delivery pipe

Roundabout =

RECEIVED BY OWRD

MAY 03 2017

SALEM, OR

T 12658

N ↑

T. 1S. R. 3E, W.M.

Hemrich Rd

Foster Rd.

32

Well

NWNE

NENE

SWNE

SENE

SE 172nd

31

RECEIVED BY OWRD

RECEIVED BY OWRD


MAY 03 2017

APR 24 2017


SALEM, OR

SALEM, OR

Scale: 1 inch = 400 feet

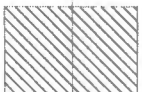

= Tax lot 101

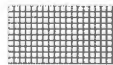

= Proposed 15.5 acres of new area of use

T 12658



T. 1S. R. 3E, W.M.

Hemrich Rd

Foster Rd.

Well

9 chains west and 8 chains north of the center of the NE 1/4 sec. 31.



32

NWNE

NENE

SWNE

SENE

SE 172nd

RECEIVED BY OWRD

31


MAY 03 2017

SALEM, OR

Scale: 1 inch = 400 feet



= Tax lot 101

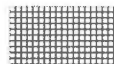

= Proposed 15.5 acres of new area of use

T 12658

Amended



T. 1S. R. 3E, W.M.

Hemrich Rd

Foster Rd.

NENE

NWNW

Well

9 chains west and 8 chains north
of the center of the NE 1/4 sec. 31.

Sec. 32

RECEIVED

JUL 12 2017

WATER RESOURCES DEPT
SALEM, OREGON

Sec. 31

SENE

SWNW

SE 172nd

Scale: 1 inch = 400 feet




= Proposed 13.4 acres
of new area of use in
tax lot 101


T-12658

Amerced

T. 2S, R. 3E, W.M.

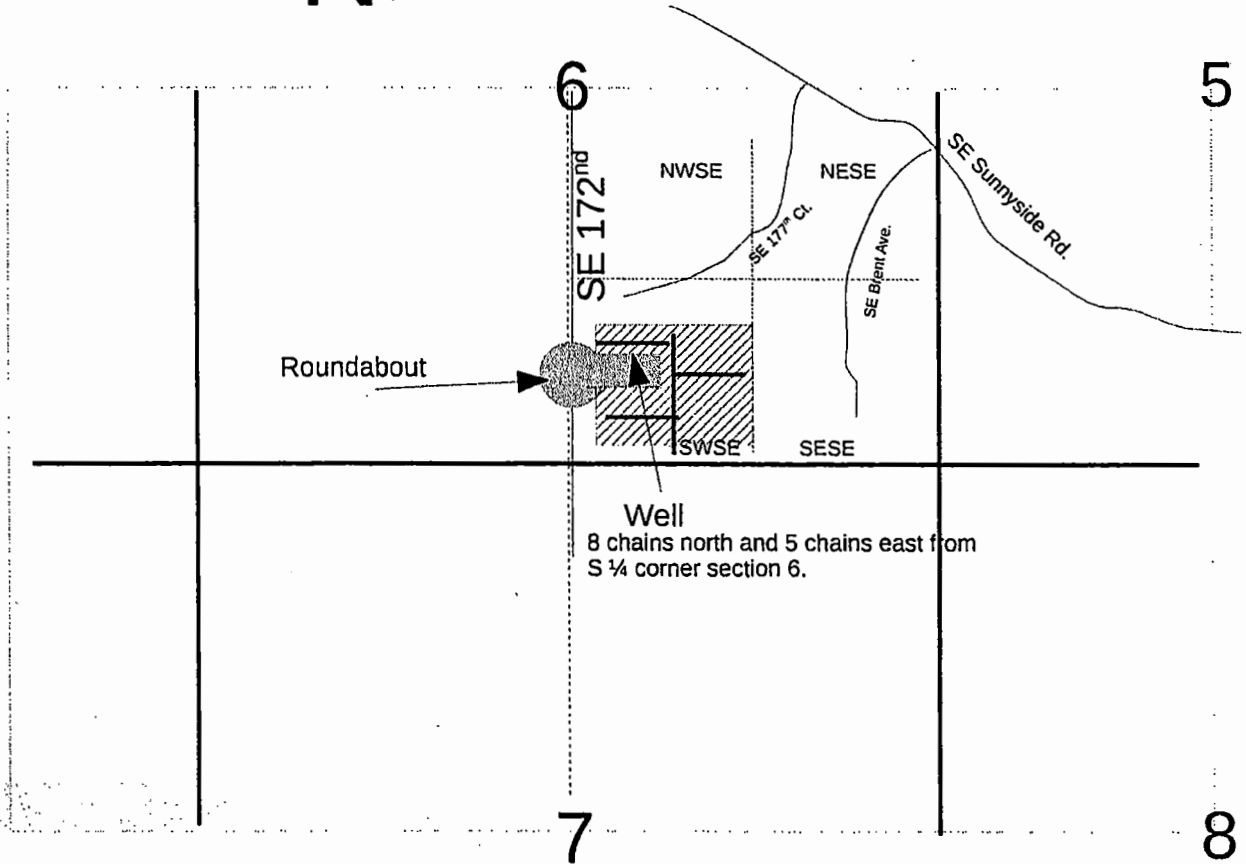

Scale: 1 inch = 1,320 feet

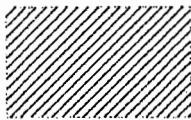

= Tax lot 400, 13.4 acres, water right cert. 29292 priority date Sept. 1957

— ····· = water delivery pipe

Roundabout =



RECEIVED

JUL 12 2017

WATER RESOURCES DEPT
SALEM, OREGON

T-12658