


T-5594

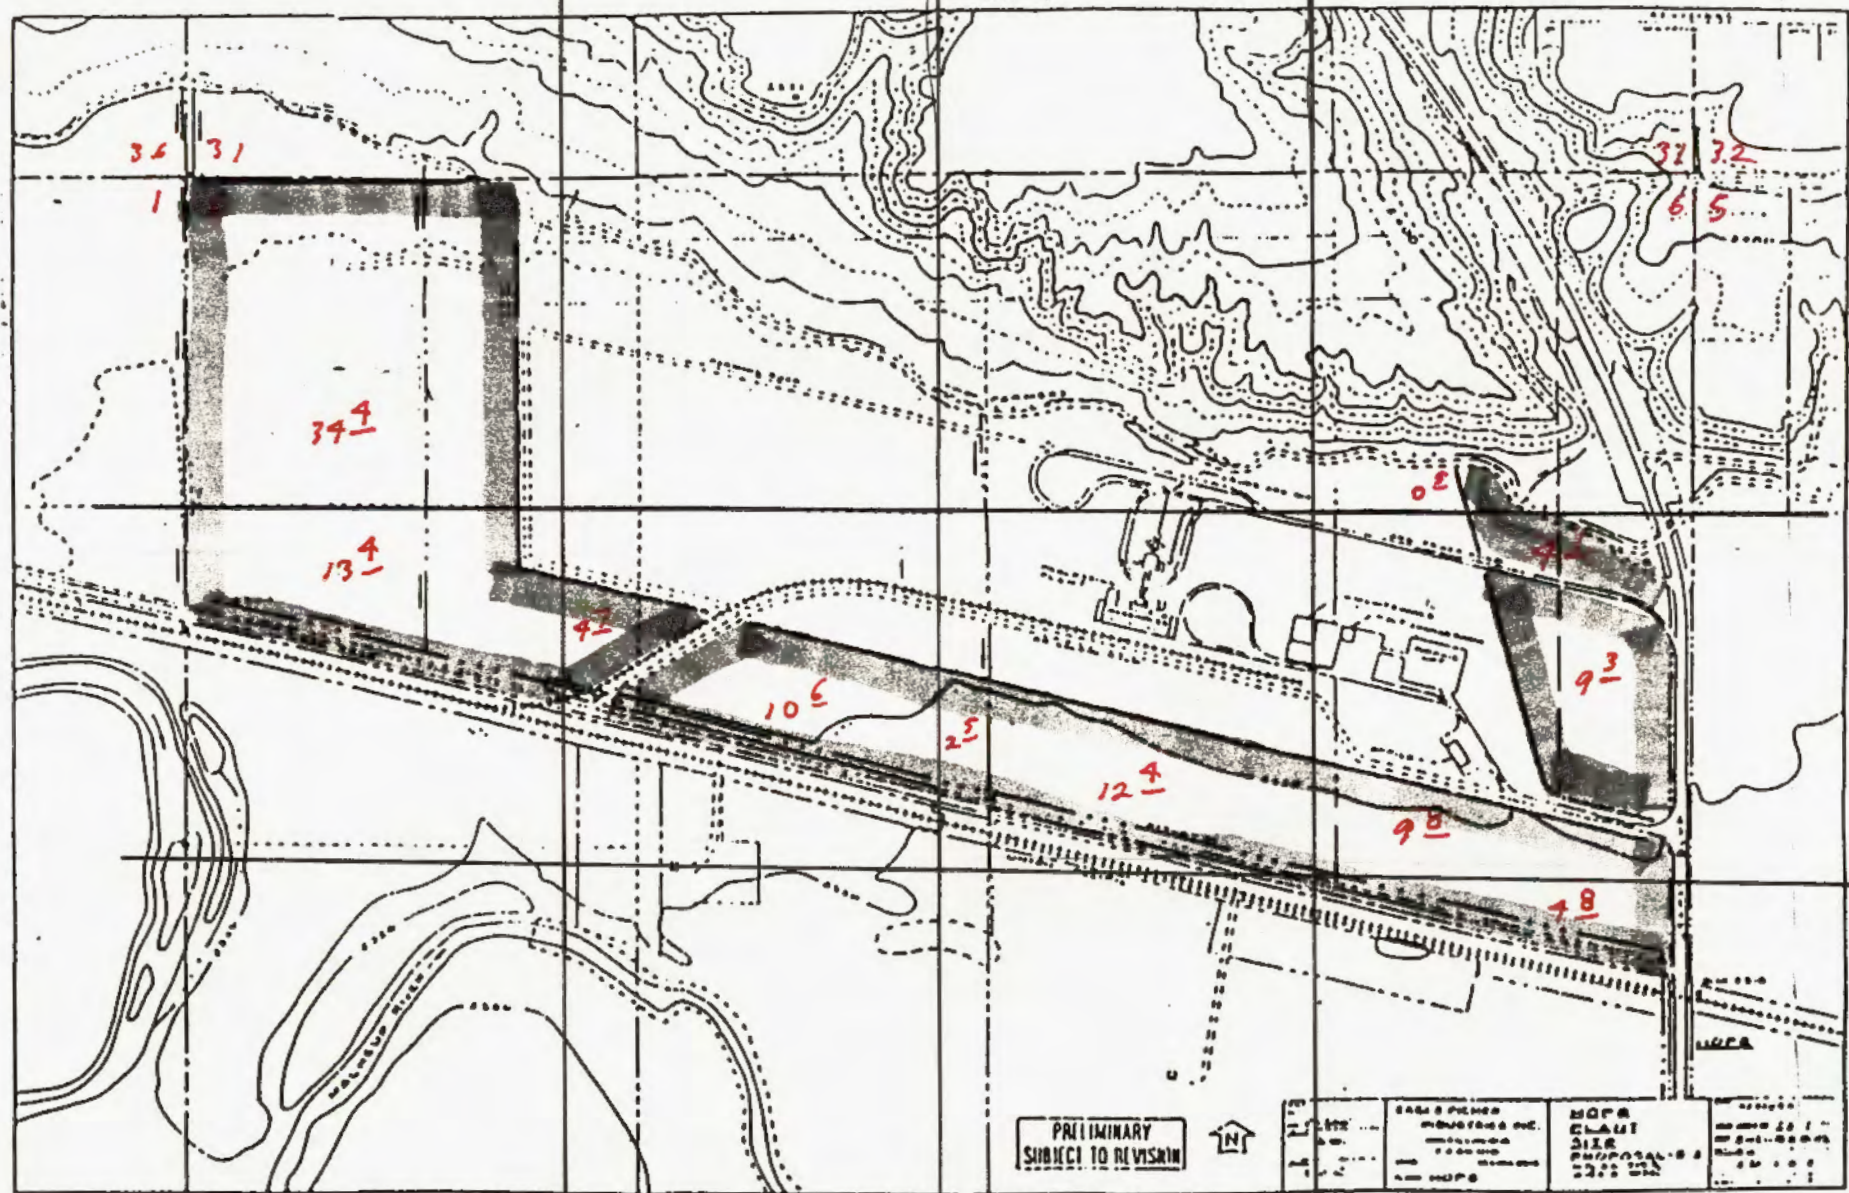

Schedule "C"
PROPOSED

PRELIMINARY
SUBJECT TO REVISION



DATE	BY	NO. OF SHEETS	TOTAL NO. OF SHEETS

NOTE: "40" LINES APPROXIMATE

T195R44E, WM

OWR

T-5594
OUT

Range 43
Range 44

