


Additional Historic POA Transfer Map for C-31765
 Map ID: 36S-2W-25-SWSE/SESE TL 1501
 SESE 1.6 acres
 SWSE 2.4 acres

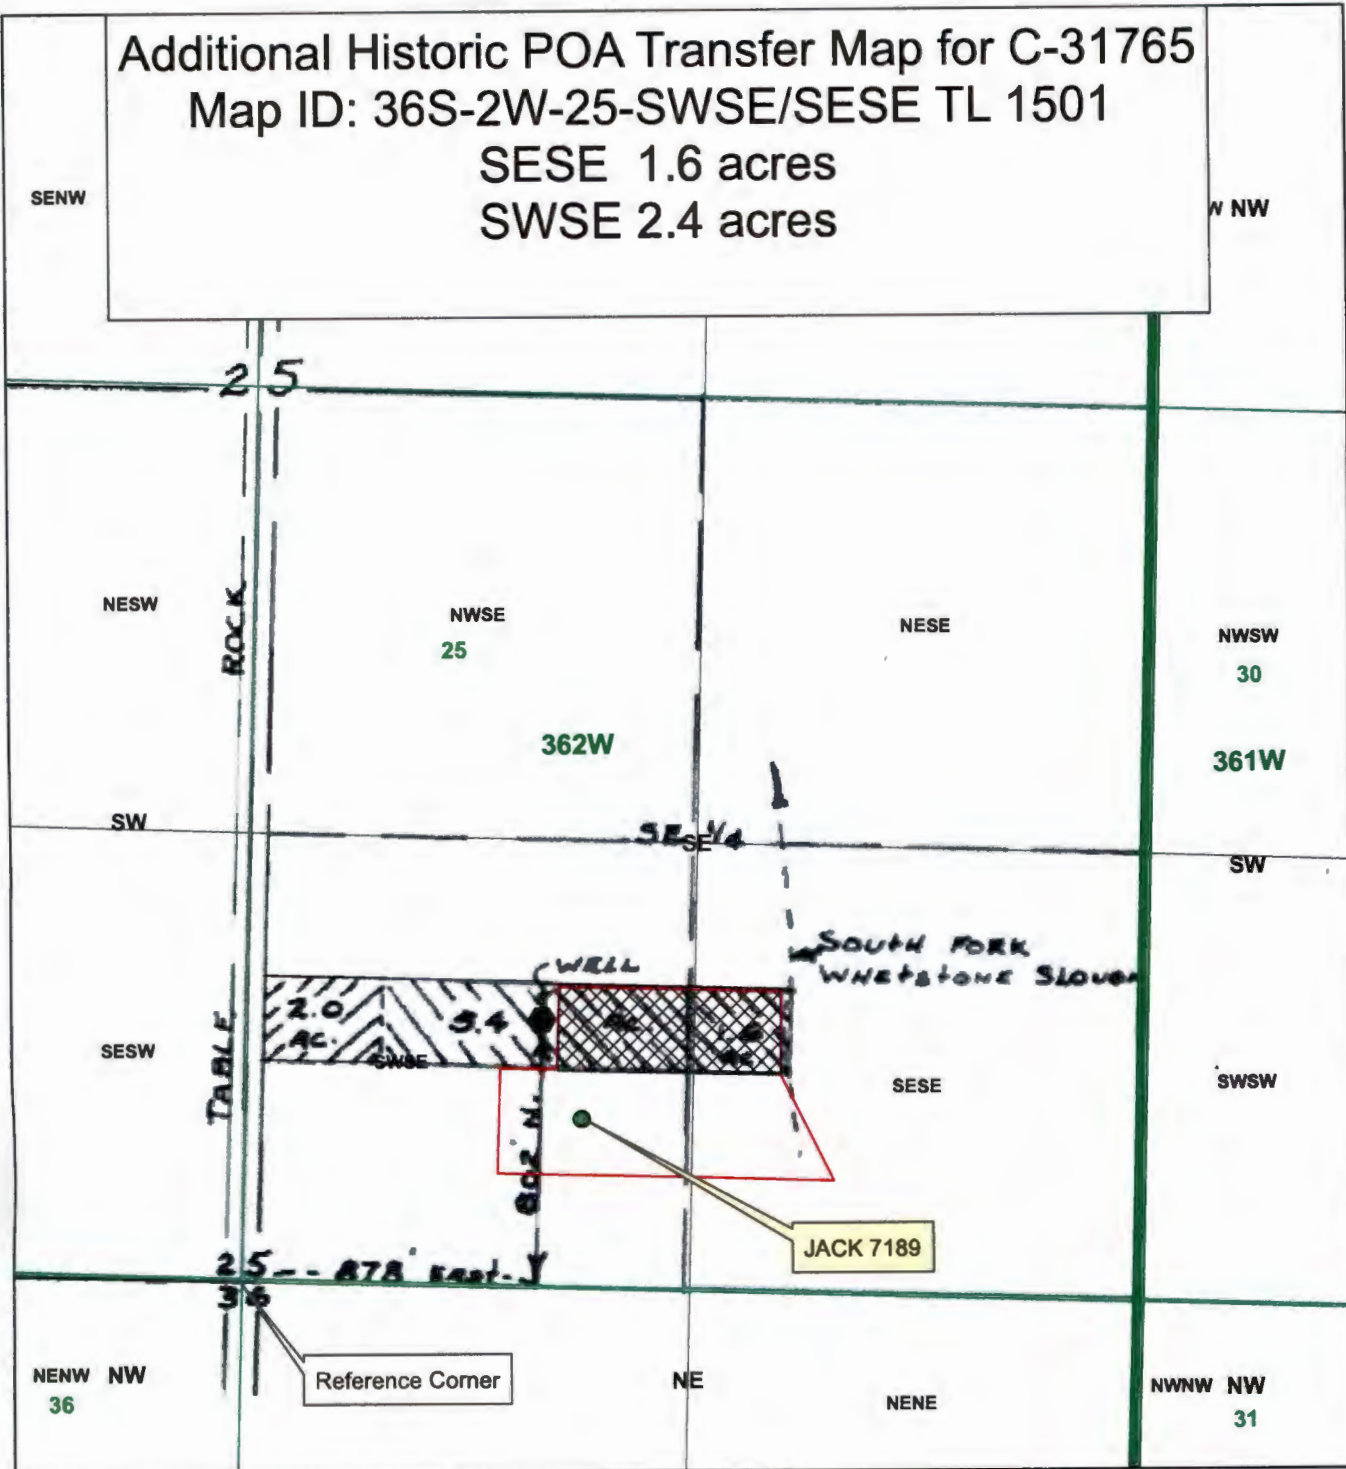

Legend

- JACK 7189 (Historic)
- TL 1501
- Ingram Well #2 (Authorized)
- ▨ Irrigated land from JACK 7189
- Quarter Sections
- Quarter Quarter Sections
- ▨ Unchanged Irrigated Land

JACK 7189 is
 1539 N and
 1033 E from S 1/4 corner
 Section 25

1 inch = 500 feet

JACKSON COUNTY
WATERMASTER
 Prepared by Shavon Haynes

This map is based on a digital database compiled by Jackson County from a variety of sources. Jackson County cannot accept responsibility for errors, omissions, or positional accuracy. There are no warranties, expressed or implied.

Date: 5/19/2017, 36-2W-25 TL 1501 Historic POA Title.mxd, haynes

RECEIVED

MAY 30 2017

T 12678

OWRD