


T 3 S R 38 E

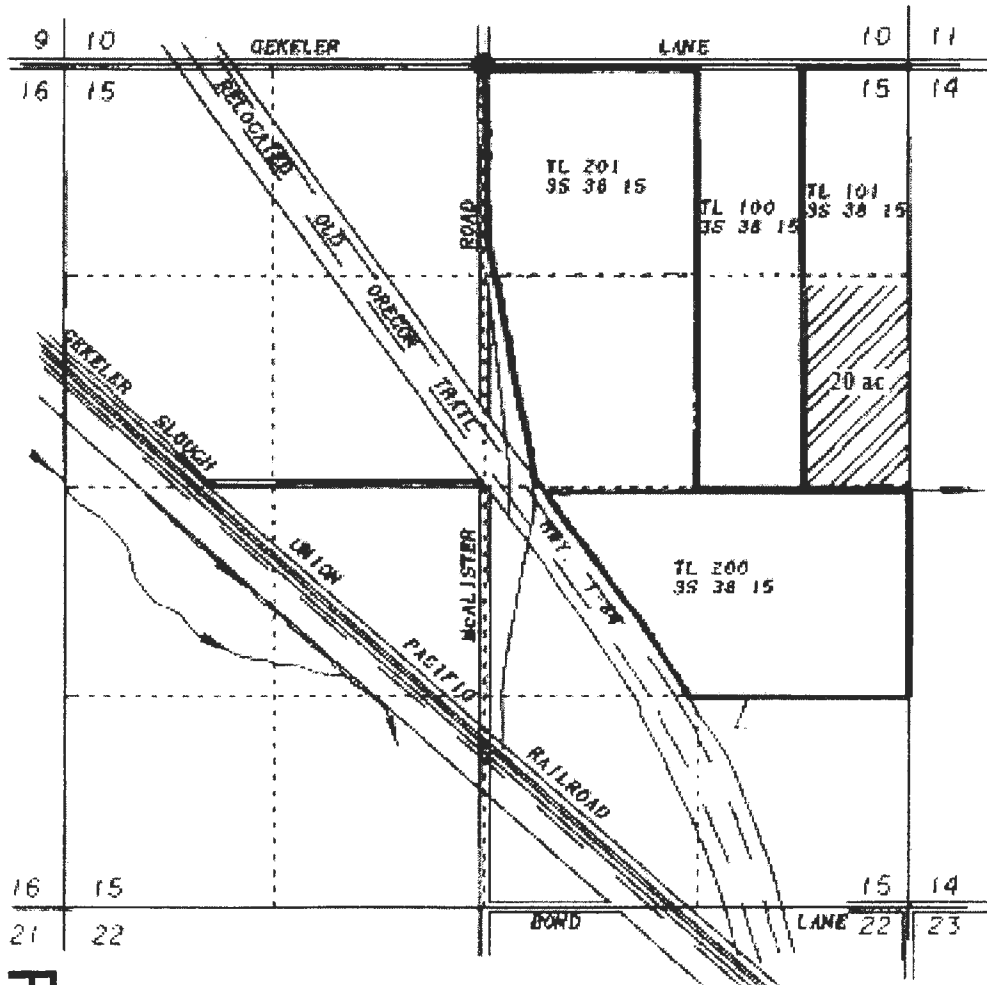

SCALE 1" = 1320'

 Portion of certificate 80275 to be canceled


RECEIVED

NOV 09 2017




OWPRD

12770

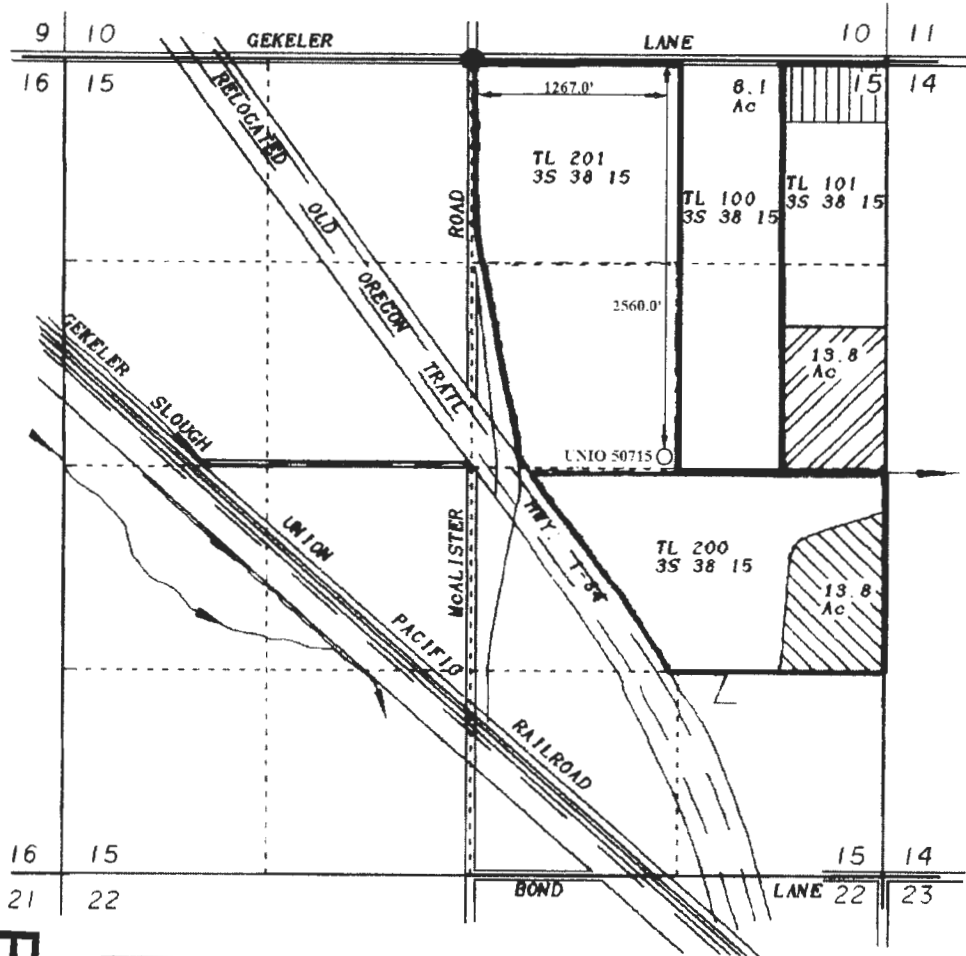T 3 S R 38 E



SCALE 1" = 1320'

-  Existing portion of permit to remain unchanged
-  Proposed new place of use
-  Existing place of use

12770

OWPRD

NOV 01 2017

RECEIVED