
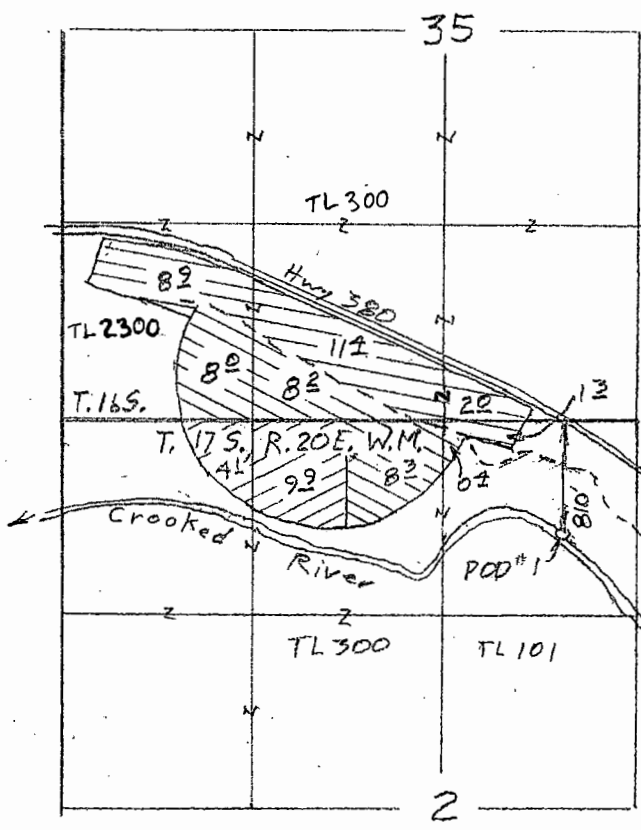


- From:
- ⊕ 50[±] acres C-47487 (3/22/1918)
 - ⊕ 14[±] acres C-47486 (5/27/1916)
 - ⊕ 32[±] acres C-47488 (3/16/1961)


Scale 1"=1320'
(4"=1 mile)

RECEIVED
DEC 31 2017
OWRD

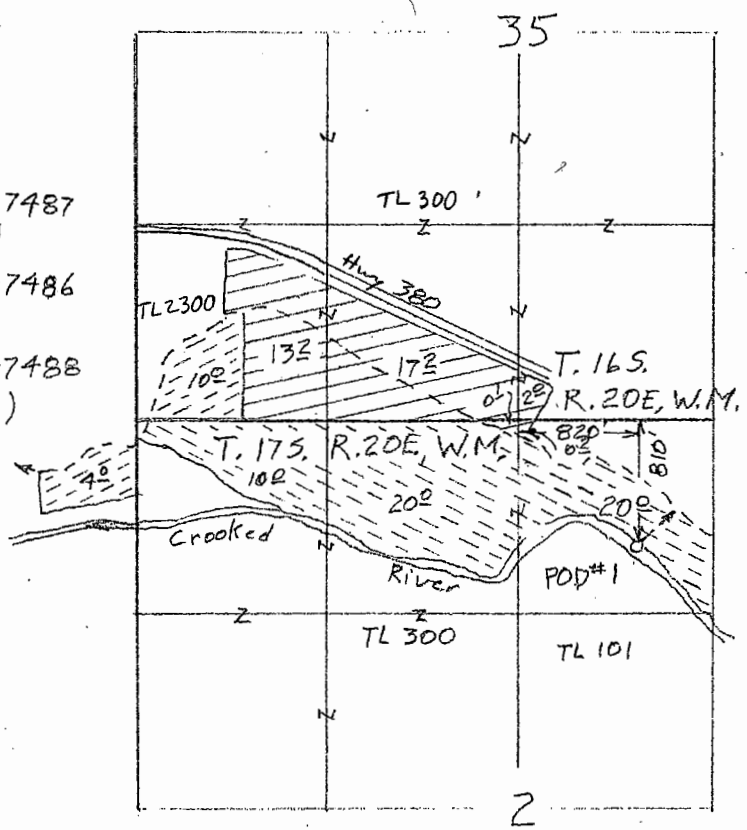

- To:
- ⊕ 24[±] acres C-47487 (3/22/1918)
 - ⊕ 14[±] acres C-47486 (5/27/1916)
 - ⊕ 23[±] acres C-47488 (3/16/1961)

Transfer Application Map
for
Shotgun Ranch, LLC

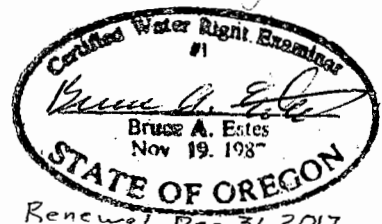


Sheet 1 of 2

T 12797


This map is for the purpose of locating a water right only and has no intent to provide legal dimensions or the location of property lines.

ESTES SURVEYS, LLC
 PO Box 17549 60382 Arnold Rd
 Salem, OR 97305-7549 Bend, OR 97702
 (503) 585-7593 (541) 382-7301

T. 17 S., R. 20 E., W. M.

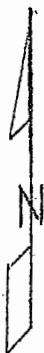

Scale 1" = 1320'
(4" = 1 mile)

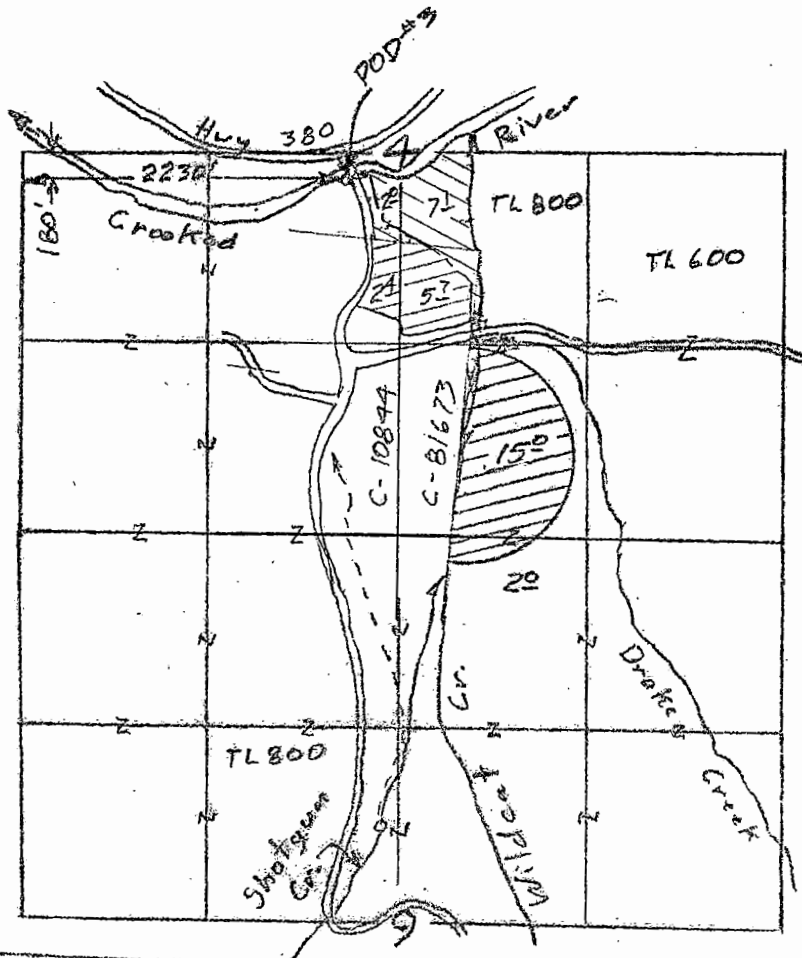


RECEIVED

DEC 21 2017

OWRD

- To:
- ⊖ 25+ acres C-47487 (3/22/1918)
 - ⊖ 9+ acres C-47488 (3/16/1961)

Transfer Application Map
for
Shotgun Ranch, LLC

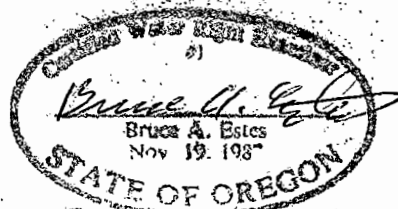

Renewal Dec 31, 2017
Sheet 2 of 2

This map is for the purpose of locating a water right only and has no intent to provide legal dimensions or the location of property lines.

ESTES SURVEYS

PO Box 17519
Salem, OR 97305-7519
(503) 585-7593

60382 Arnold Rd
Bend, OR 97702
(541) 382-7391

T 12797