

IMPORTANT
This Map for Assessment
and Taxation Purposes
ONLY

SEC. 7 T8S R4W WM
POLK COUNTY

Scale 1" = 400'

See Map 8.4.6

8.4.7


T 12811

OWRPD

DEC 29 2017

RECEIVED

06/22/17

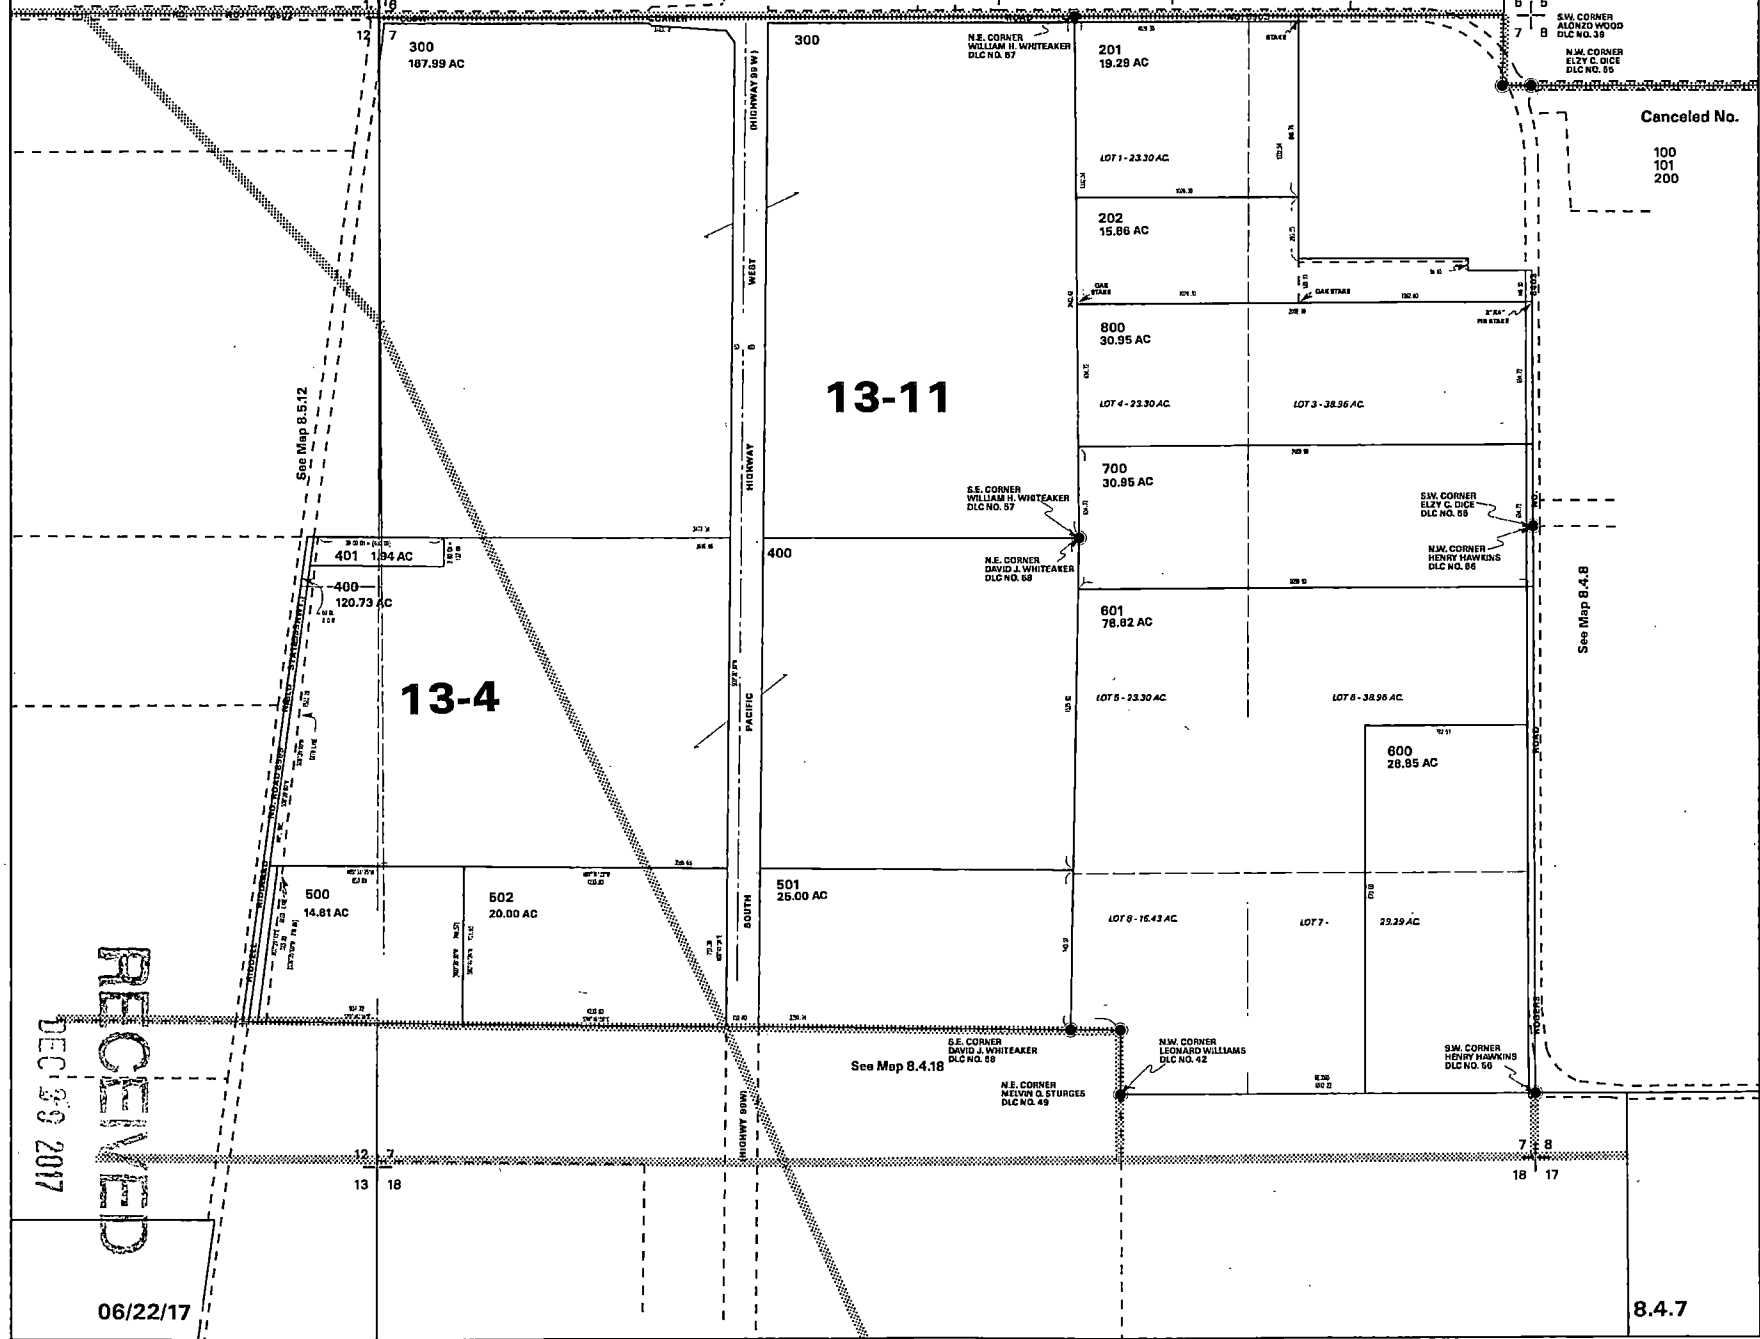

8.4.7

IMPORTANT
This Map for Assessment
and Taxation Purposes

See Map 8.4.7

SEC.18 T8S R4W WM
POLK COUNTY

8.4.18

Scale 1" = 400'

ONLY

202
29.23 AC

13-6

200
69.07 AC

13-12

100
139.61 AC

13-11

13-12

Canceled No.
203

204
64.69 AC

201
51.74 AC

13-8

501
30.87 AC

800
800M
46.61 AC

900
19.69 AC

901
32.51 AC

300
5.67 AC

301
37.89 AC

N.E. CORNER
AARON BURBANK
DLC NO. 49

W/4 SW CORNER
LEONARD WILLIAMS
DLC NO. 42

GAP

SW CORNER
LEONARD WILLIAMS
DLC NO. 42

600
72.56 AC

700
58.30 AC

LOT 2
12.34 AC

LOT 1
46.66 AC

13-7

400
49.17 AC

500
60.52 AC

602
2.84 AC

See Map 8.4.19

06/22/17

See Map 8.5.24A

8.4.18

T 12811

OWPRD

DEC 29 2017

RECEIVED

Sol-Sisters Inc.

1" = 1320'


Tax Lot:

Township 8 South, Range 4 West, Section 7, Tax Lot 202 & 502 & Section 18, Tax Lot 202 & 204

RECEIVED
North

DEC 29 2017

OWRD

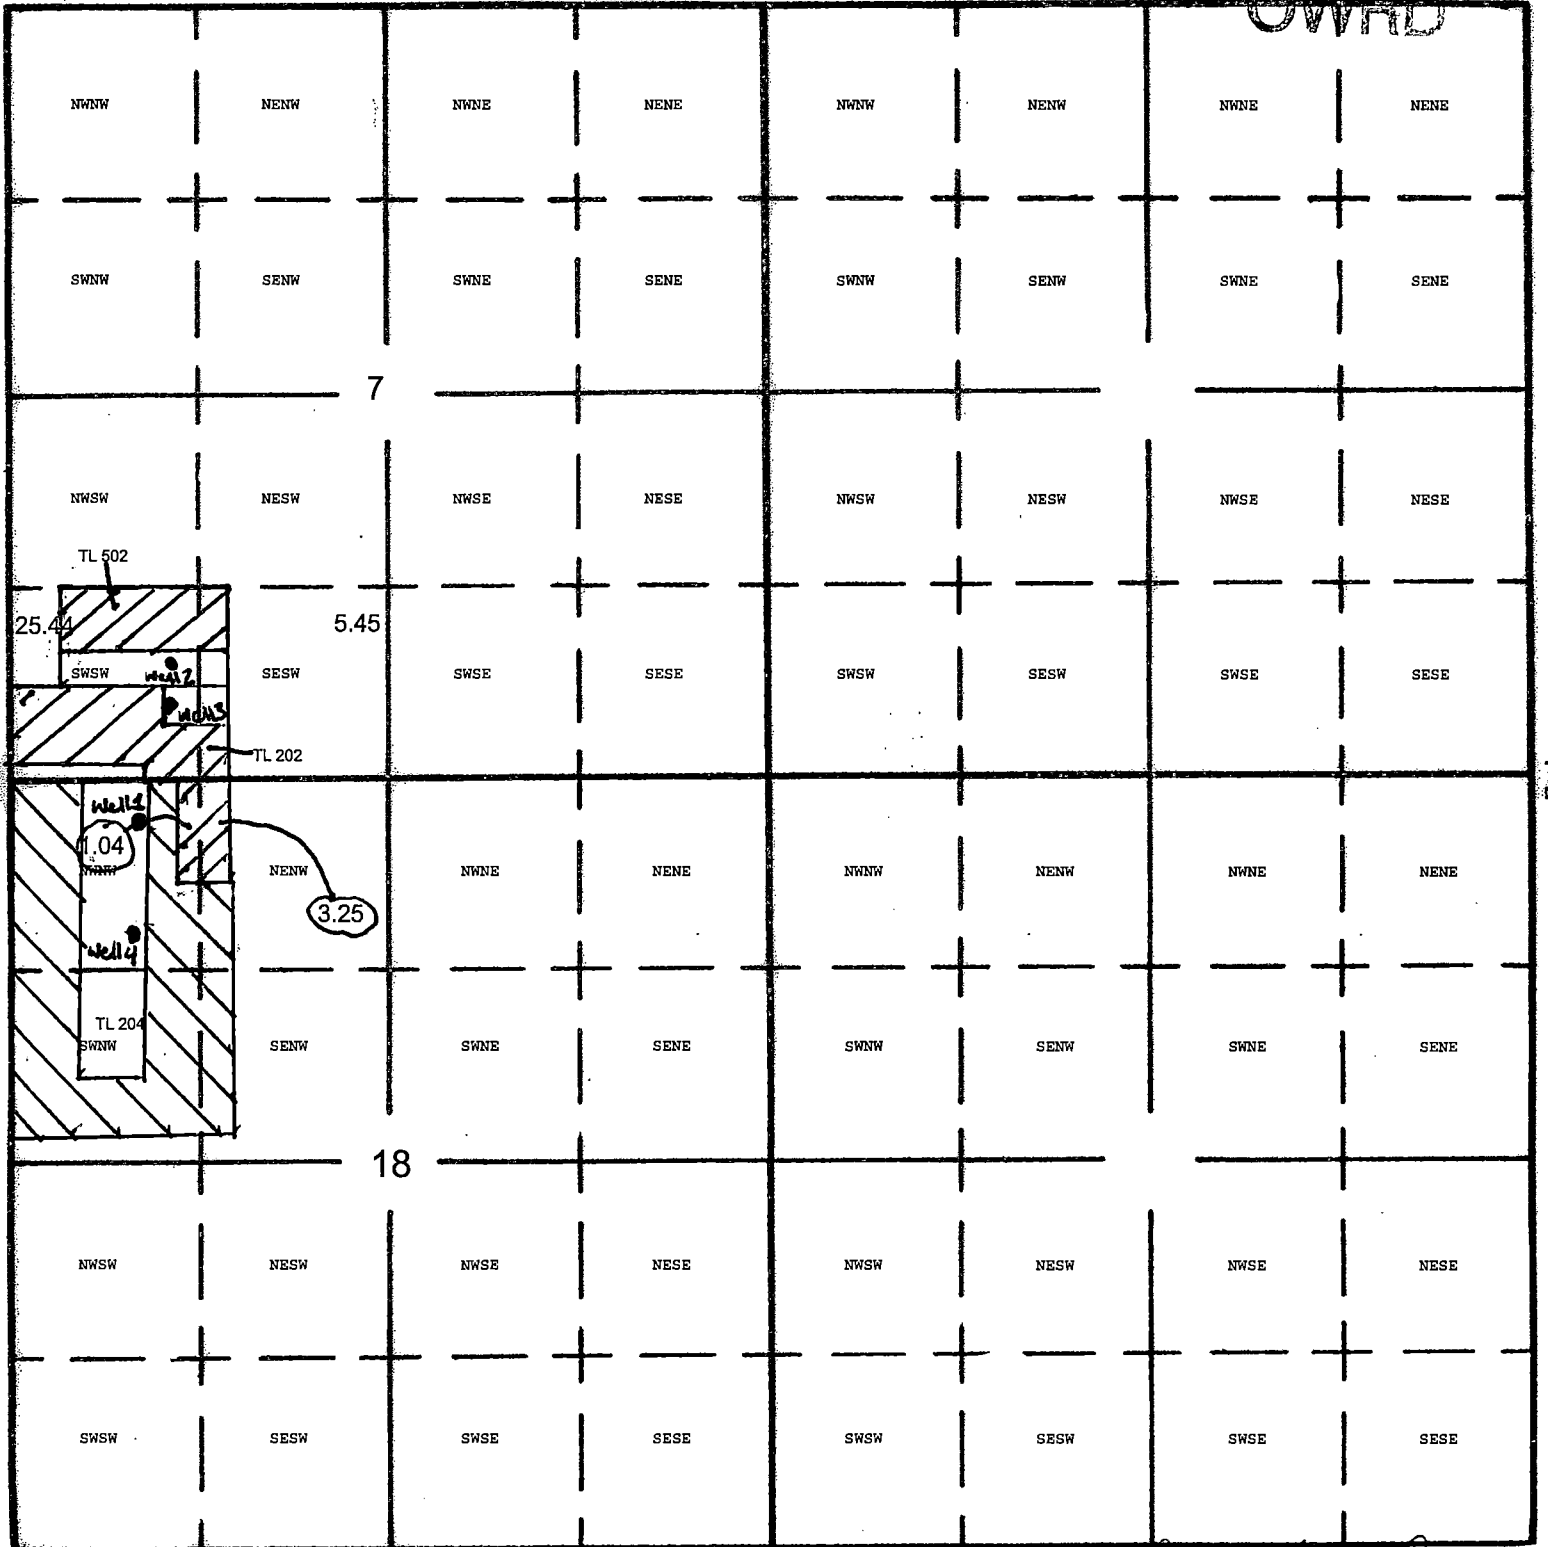

- Well 1 (L-65554): 300 South and 937 East West from NW Corner Section 18, Latitude 44.88223 Longitude -123.23190
- Well 2 (POLK 3227): 835 North and 1160 East from SW Corner Section 7, Latitude 44.88524 Longitude -123.23072
- Well 3 (POLK 375): 540 North and 1090 East from SW Corner Section 7, Latitude 44.88446 Longitude -123.23100
- Well 4 Authorized: 1025 South and 910 East from NW Corner Section 18

NO CHANGE


Seanna L. Harb 11-29-17

T 12811

PROPERTY DESCRIPTION

Section: 7, Township: 8S, Range: 4W, Willamette Meridian,
Polk County, State of Oregon.

Map / Tax Lot or Parcel No.: 08418-00-00202

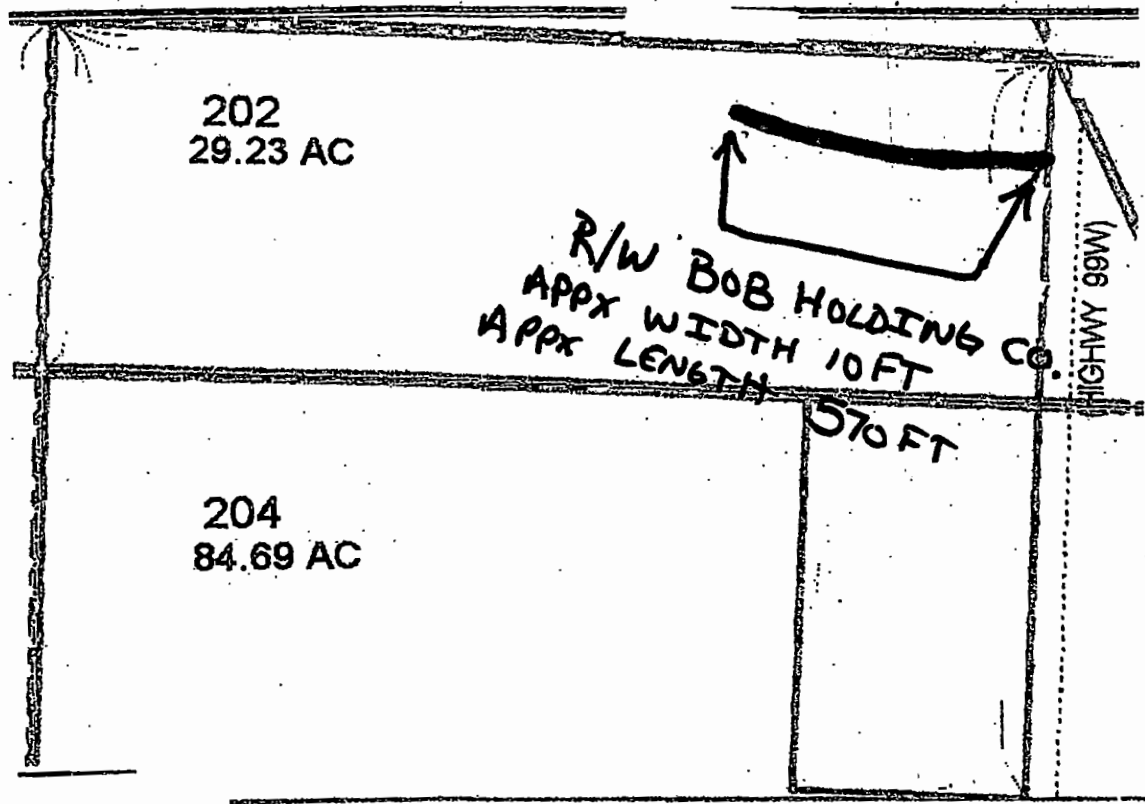

CC#: 11246 WO#: 6151086
Landowner Name: Bob Holding Co. LLC
Drawn by: J. Albers

This drawing should be used only as a representation of the location of the easement area. The exact location of all structures, lines and appurtenances is subject to change within the boundaries of the described easement area.

EXHIBIT A




RECEIVED
DEC 20 2017

OWRD



EXHIBIT 1

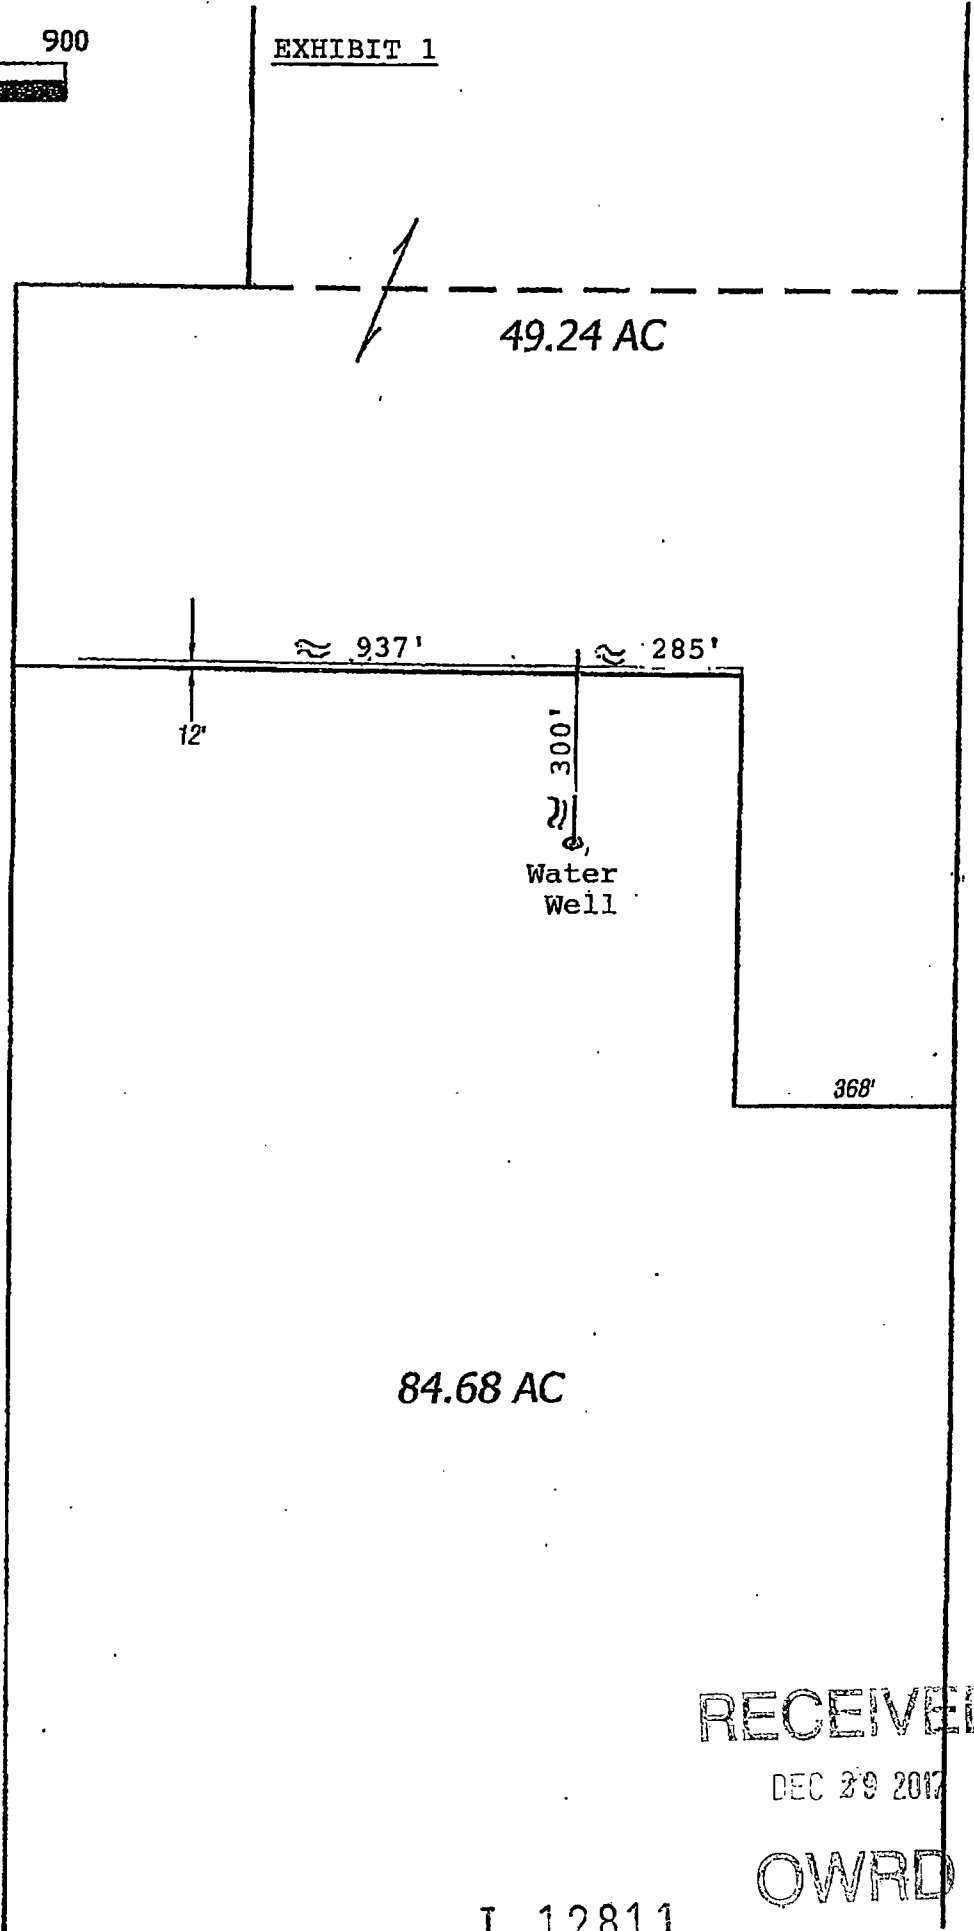

RECEIVED

DEC 29 2017

OWRD

T 12811