APPLICATION FOR PERMANENT WATER RIGHT TRANSFER

FOR

DELYLE AND DANIELLE DIAZ

T40S, R11E, Sec. 28, 29, & 33 W.M.
KLAMATH COUNTY, OREGON
CERTIFICATE 93008
APPLICATION No. G-12811
PERMIT No. G-12431

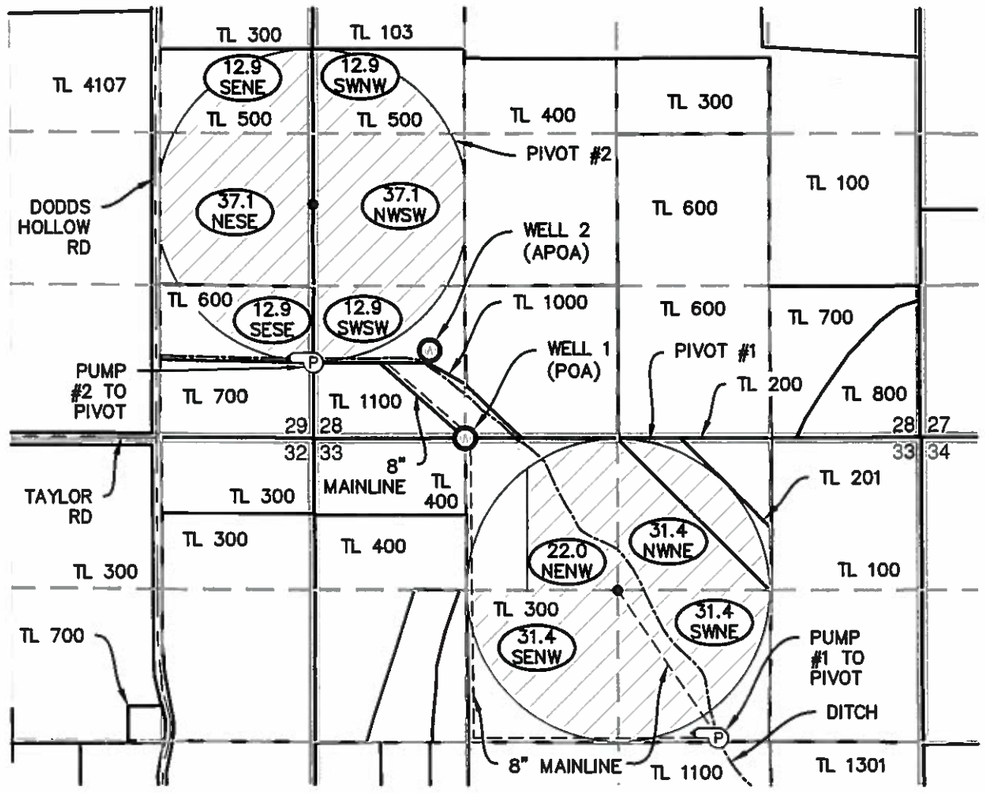

NOTES:

1. THIS MAP WAS PREPARED FROM FIELD MEASUREMENTS, NAIP 2005 AERIAL PHOTOGRAPH, KLAMATH COUNTY TAX MAP 40 11 28 AND OREGON GLO MAPS.

2. THE PURPOSE OF THIS MAP IS TO IDENTIFY THE LOCATION OF THE WATER RIGHT ONLY, AND IS NOT INTENDED TO PROVIDE DIMENSIONS OR LOCATION OF PROPERTY LINES.

3. FOR TAX LOT INFORMATION, SEE TAX MAP INCLUDED WITH THIS APPLICATION.

4. DATE OF PRIORITY FOR THIS CERTIFICATE IS MARCH 6, 1992.

WELL TIE:

WELL 1 (AUTHORIZED POINT OF APPROPRIATION) AND METER ARE LOCATED 145' NORTH & 875' WEST FROM THE SOUTH 1/4 OF SECTION 28, T40S, R11E, W.M. IN THE SE1/4 SW1/4, SECTION 28.

WELL 2 (ADDITIONAL POINT OF APPROPRIATION) IS LOCATED 1111.4' EAST & 659.5' NORTH OF THE SOUTHWEST CORNER OF SECTION 28, T40S, R11E, W.M. IN THE SE1/4 SE1/4, SECTION 28.

RECEIVED
JAN 18 2018
OWRD

LEGEND

- SECTION LINE
- 1/4 1/4 LINE
- TAX LOT LINE
- DITCH LINE
- BURIED PIPE
- ℄ ROAD
- PUMP
- PIVOT CENTER
- 22 22 / 22 22 — SECTION CORNER
- TL 0000 — TAX LOT NUMBER
- IRRIGATED UNDER PERMIT G-12431
- 35.0 SWSE — IRRIGATED ACRES; 1/4 1/4 SECTION
- WELL

Applicant Signature

CERTIFIED WATER RIGHT EXAMINER #88332CWRE
Daniel B. Scalas
April 23, 2015
STATE OF OREGON
RENEWAL 06/30/18

ADKINS CONSULTING ENGINEERING, LLP
Engineers ▲ Planners ▲ Surveyors
1435 Esplanade Ave · Klamath Falls, Oregon 97601 · (541) 884-4666 · FAX (541) 884-5335
Oregon · California

1/9/2018 TRANSFER 2972-03

T 12826