



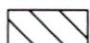

Transfer of Water Right  
Lakeview Water Users Inc  
Certificate 93497

T 40 S, R 19 E, WM  
Section 8, NESE

Map 1 of 6

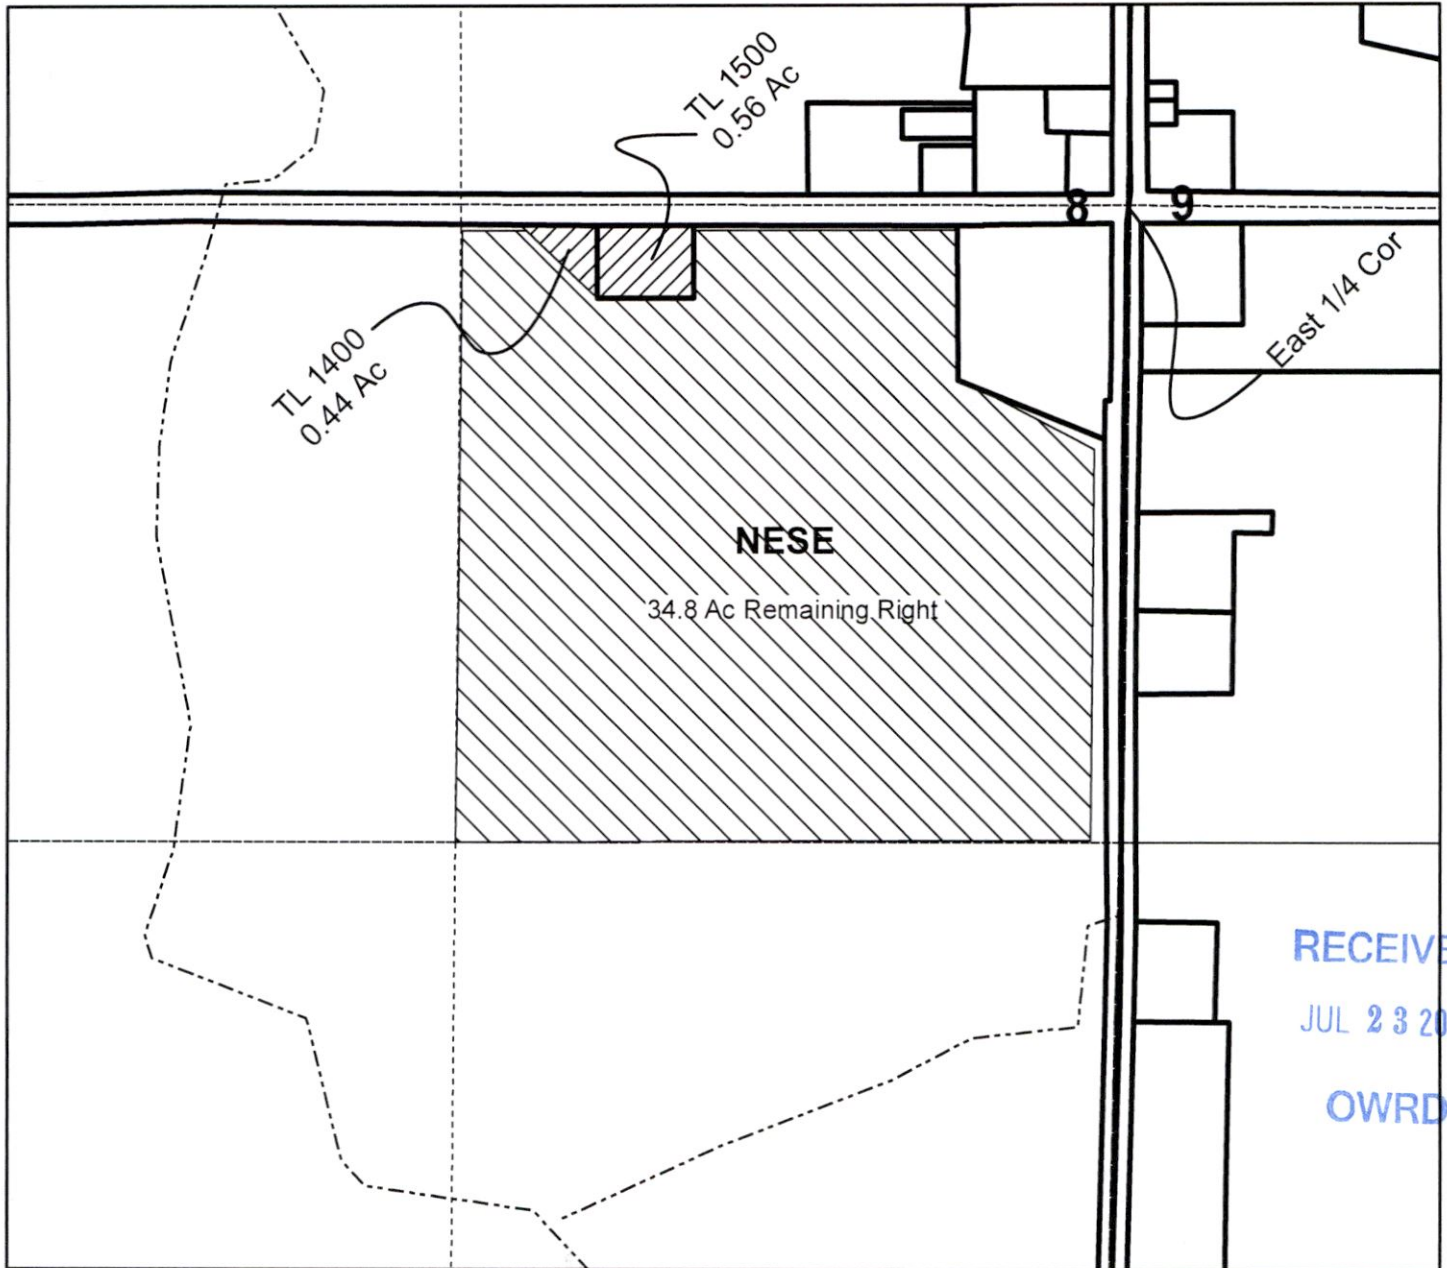


Legend

-  Transfer FROM 1.0 Ac
-  Remaining Right
-  Lakeview Water User ditch



1 inch = 400 feet

T 12985

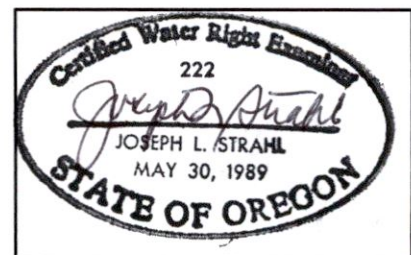


Note: This map is not intended to provide legal dimensions or locations of property ownership lines.

Transfer of Water Right  
Lakeview Water Users Inc  
Certificate 93497

T 40 S, R 19 E, WM  
Section 6, SWSE

Map 2 of 6

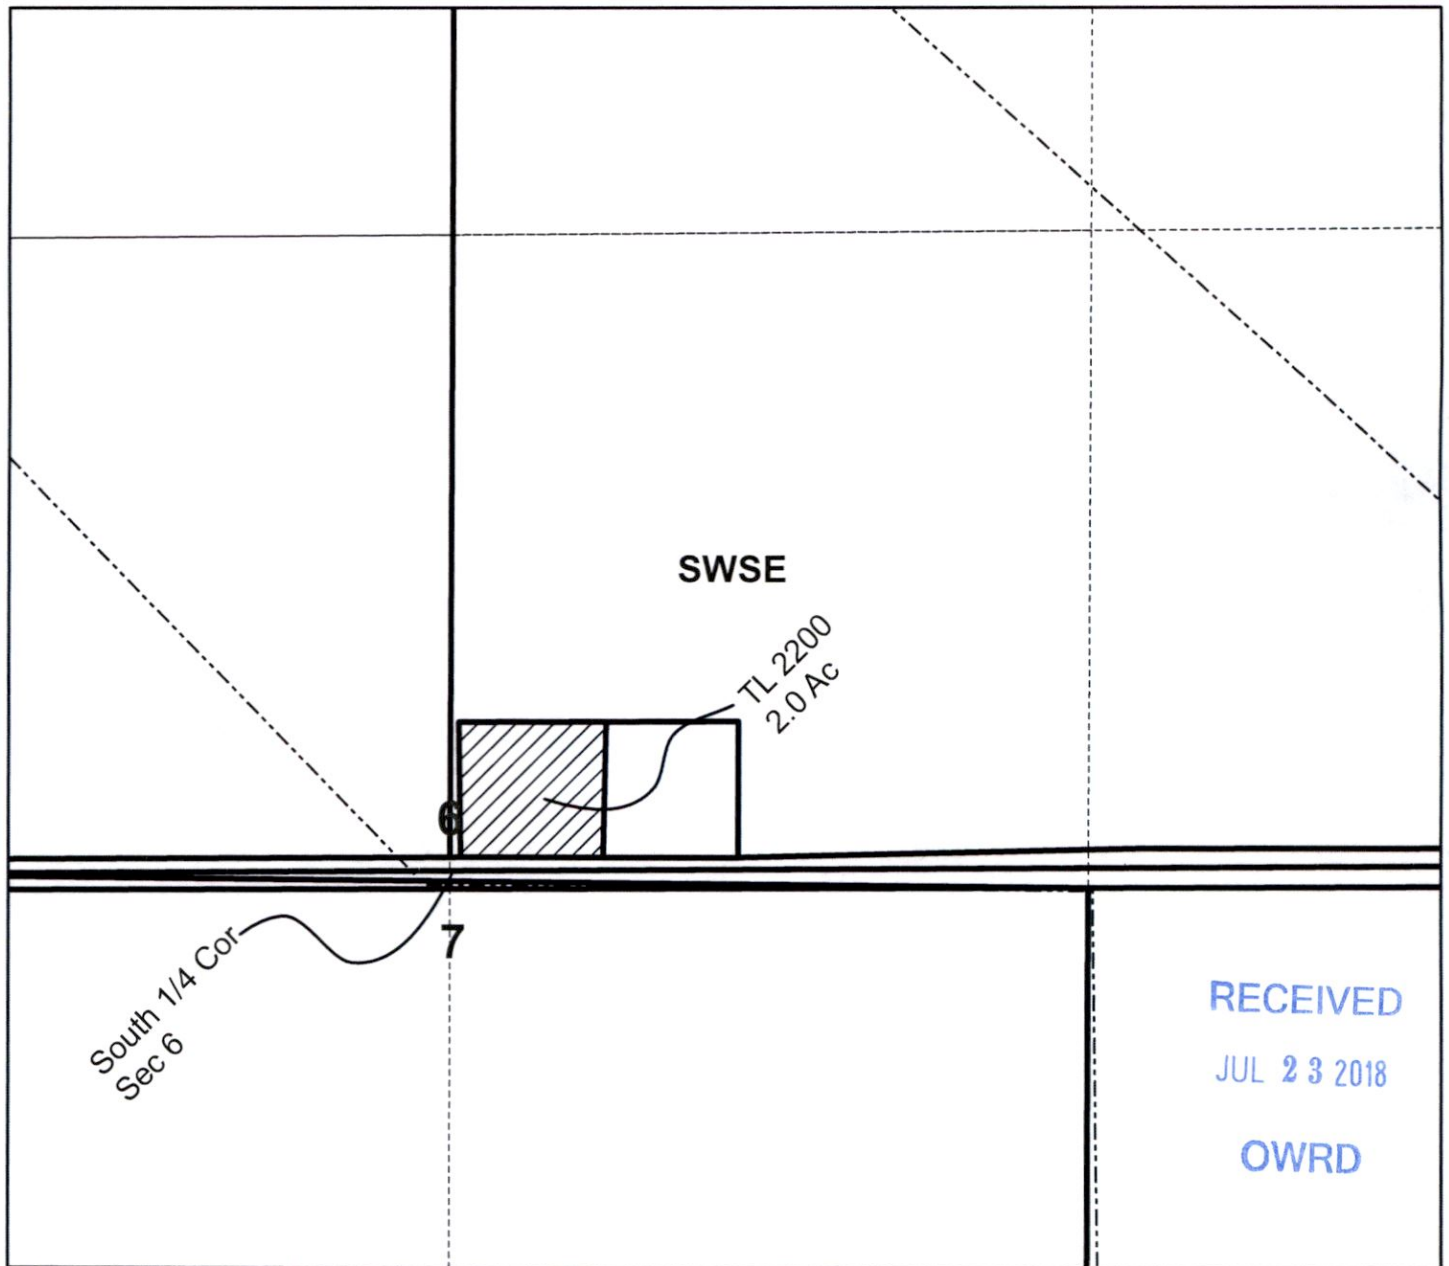



T 12985

N



1 inch = 400 feet

Legend

-  Transfer FROM 2.0 Ac
-  Lakeview Water User ditch




Note: This map is not intended to provide legal dimensions or locations of property ownership lines.

Transfer of Water Right  
Lakeview Water Users Inc  
Certificate 93497

T 40 S, R 19 E, WM  
Section 17, NENE

Map 3 of 6

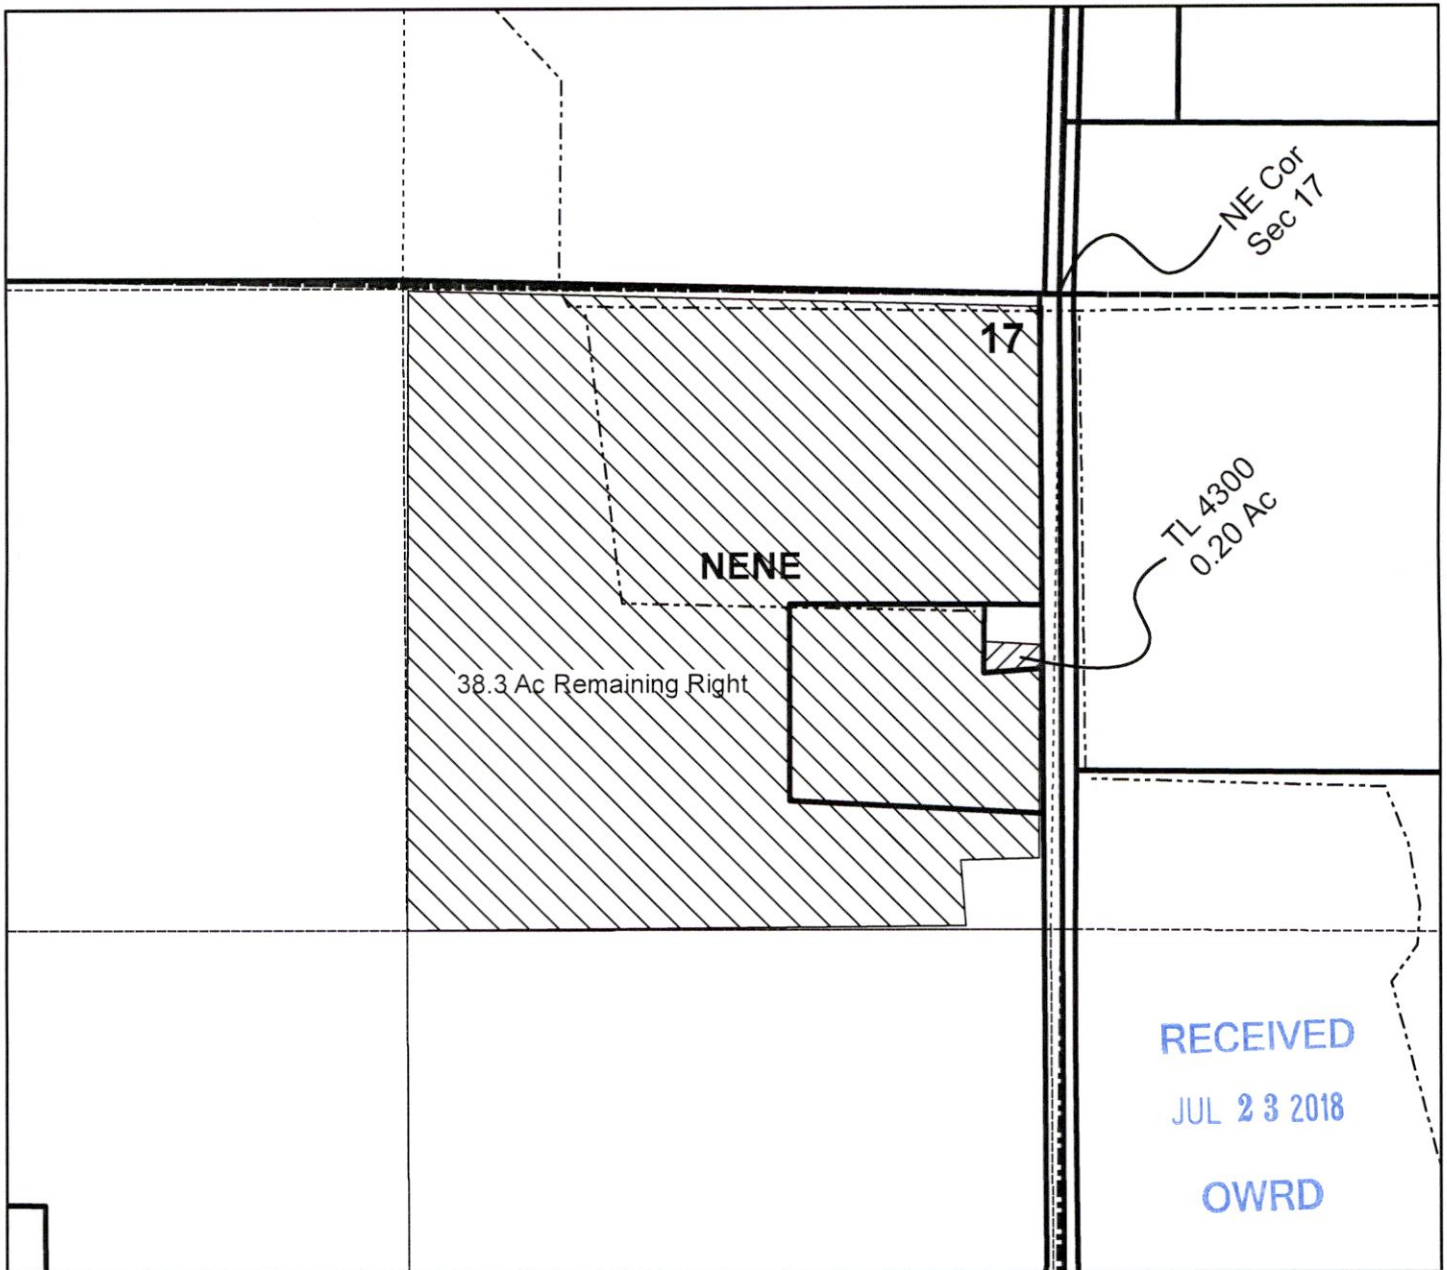




T 12985

N



1 inch = 400 feet

Legend

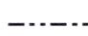-  Transfer FROM 0.2 Ac
-  Remaining Right 38.3 Ac
-  Lakeview Water User ditch




Note: This map is not intended to provide legal dimensions or locations of property ownership lines.

Transfer of Water Right  
Lakeview Water Users Inc  
Certificate 93497

T 40 S, R 19 E, WM  
Section 16, SWNE

Map 4 of 6

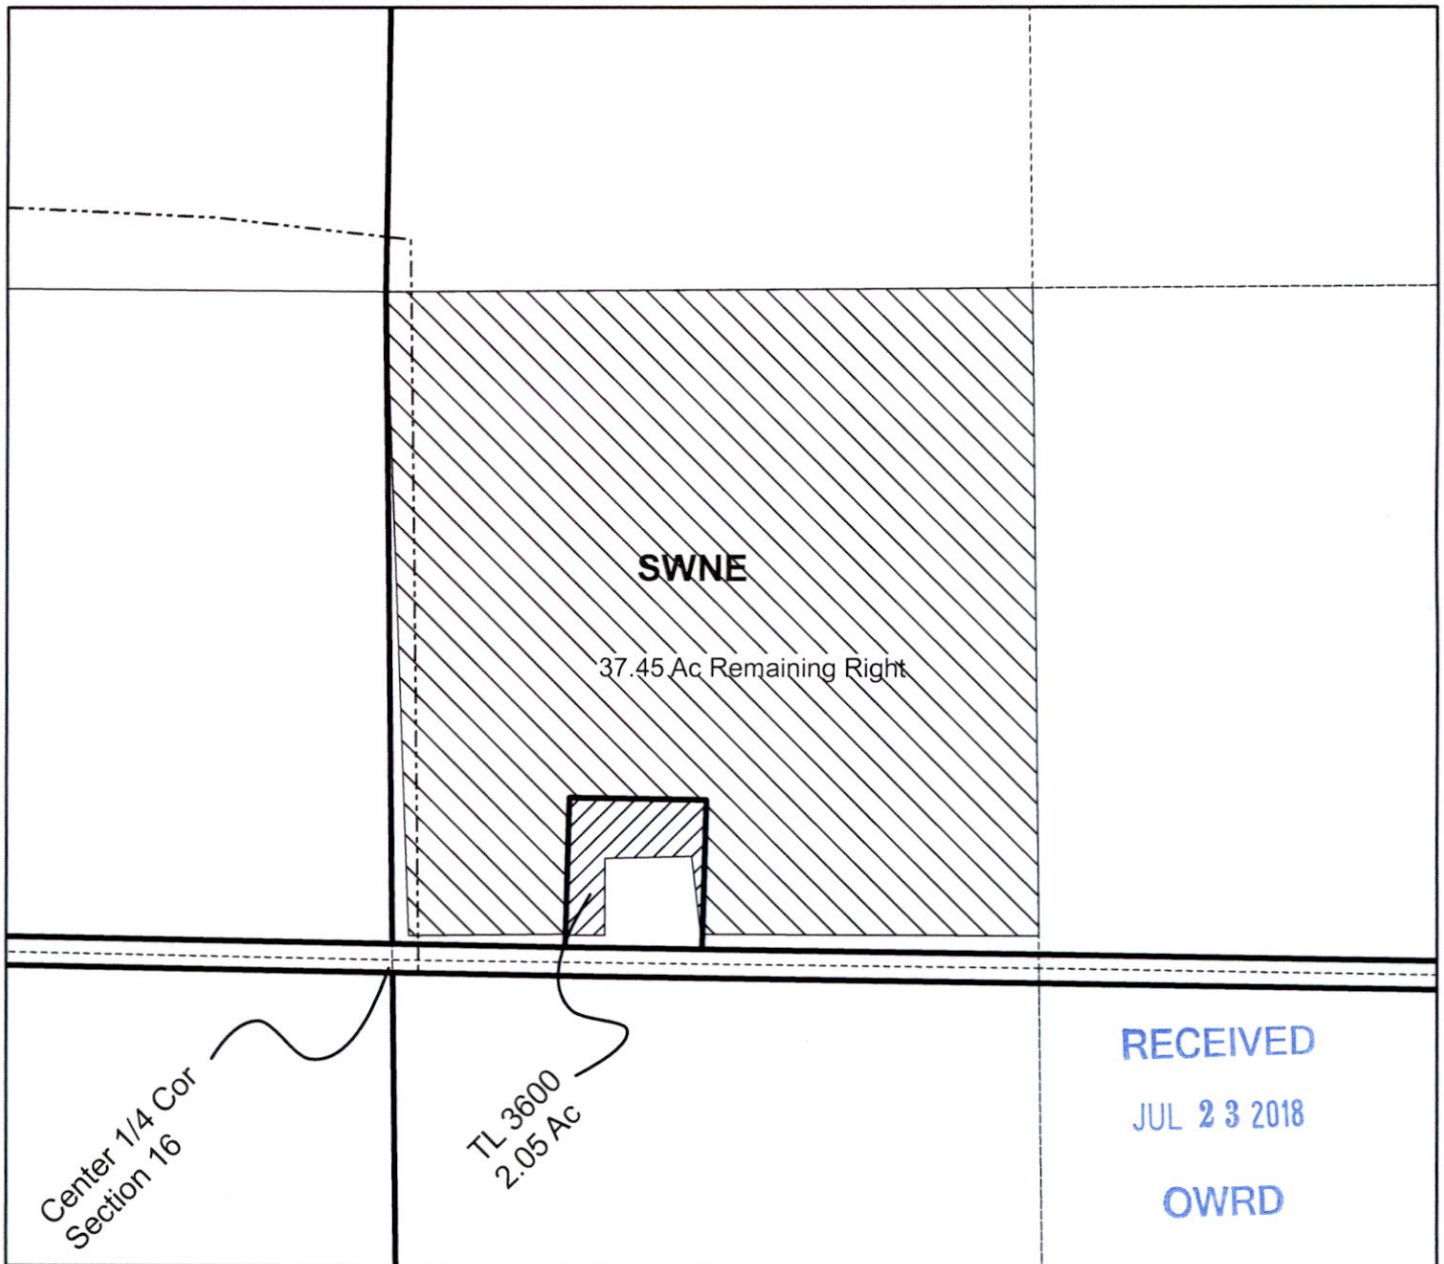

T 12985

N



1 inch = 400 feet

Legend

- Transfer FROM 2.05 Ac
- Remaining Right 37.45 Ac
- Lakeview Water User ditch




Note: This map is not intended to provide legal dimensions or locations of property ownership lines.






Transfer of Water Right  
 Lakeview Water Users Inc  
 Certificate 93497

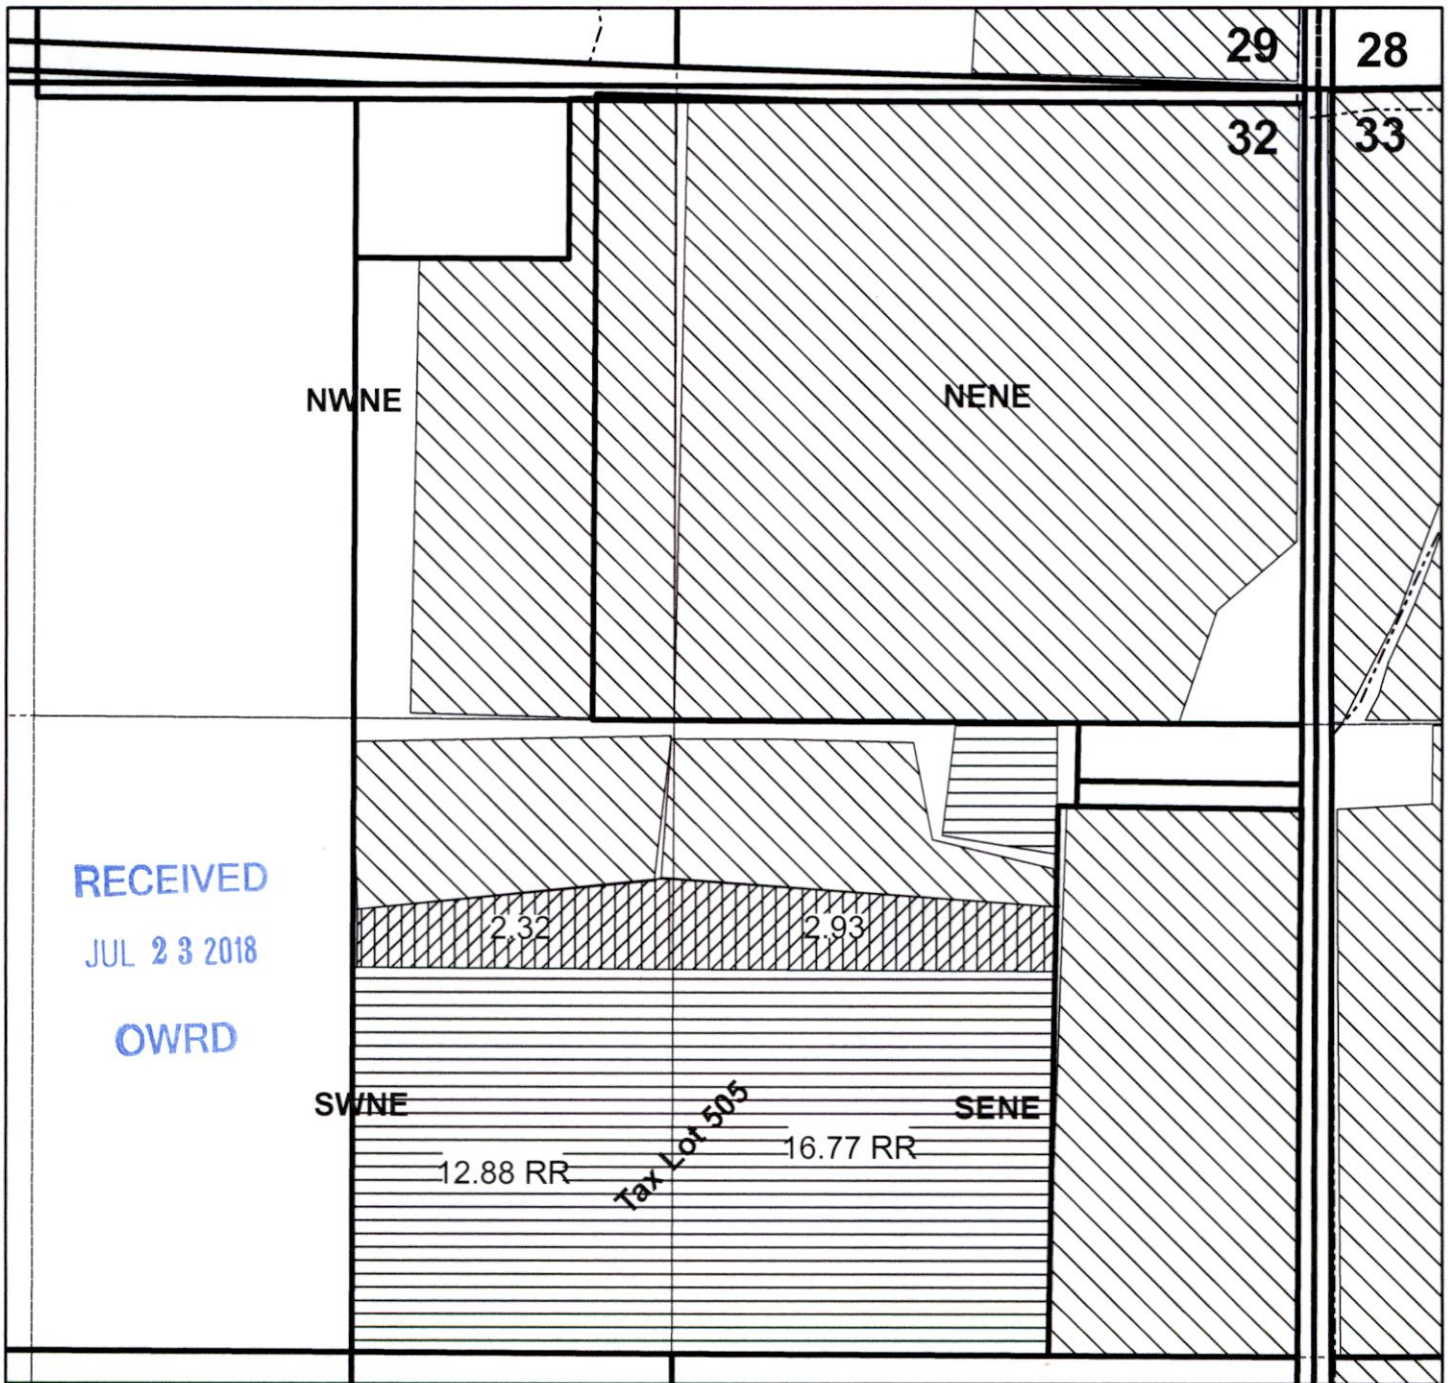
T 39 S, R 19 E, WM  
 Section 32

Map 5 of 6

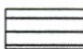

**Legend**

-  Transfer TO 5.25 Ac
-  Location of C 93497
-  C 87729 Unchanged
-  C 87729 Dim to Supp
-  Lakeview Water User ditch

N  
  
 1 inch = 400 feet  
 T 12985

Note: This map is not intended to provide legal dimensions or locations of property ownership lines.





# Lakeview Water Users Inc Points of Diversion Certificate 93497





1 inch = 1,320 feet

Note: This map is not intended to provide legal dimensions or locations of property ownership lines.

**Drews Creek Diversion  
SE NW T40S, R18E, Sec 11, WM**

**Map 6 of 6**

**Drews Creek Reservoir Diversion  
SW SE T40S, R18E, Sec 5, WM**

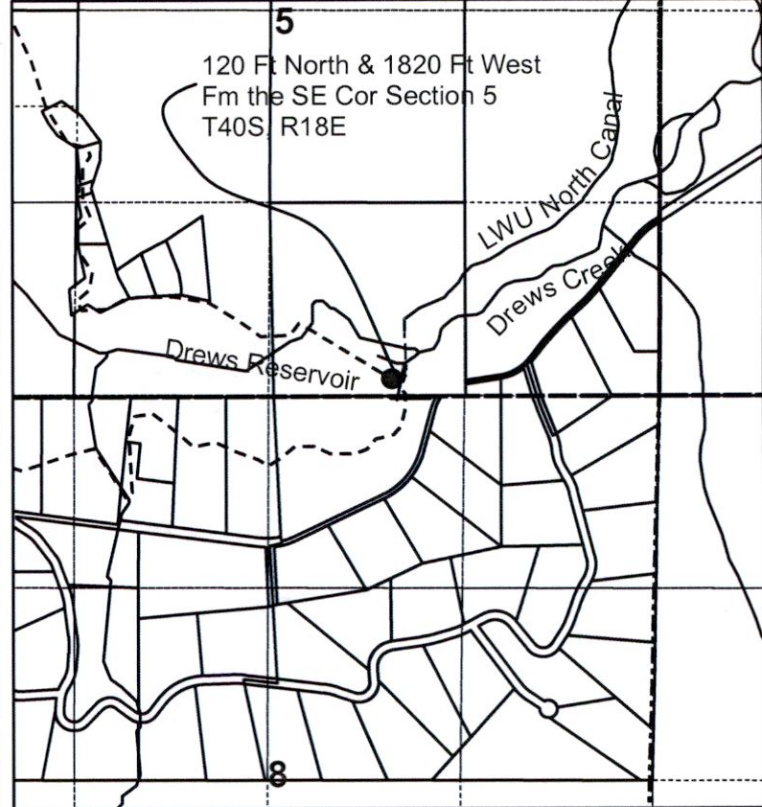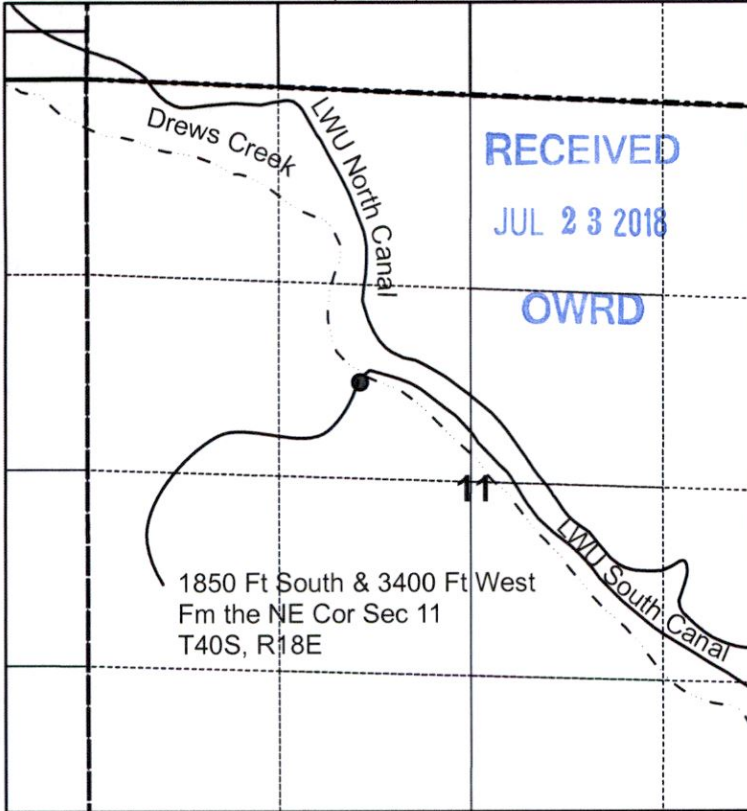

**Cottonwood Creek Reservoir Diversion  
NW SW T38S, R19E, Sec 29, WM**

**Cottonwood Creek Diversion  
NE NE T39S, R19E, Sec 16, WM**

