


# Certificate 93852 Transfer Supplemental to Primary, Loewen

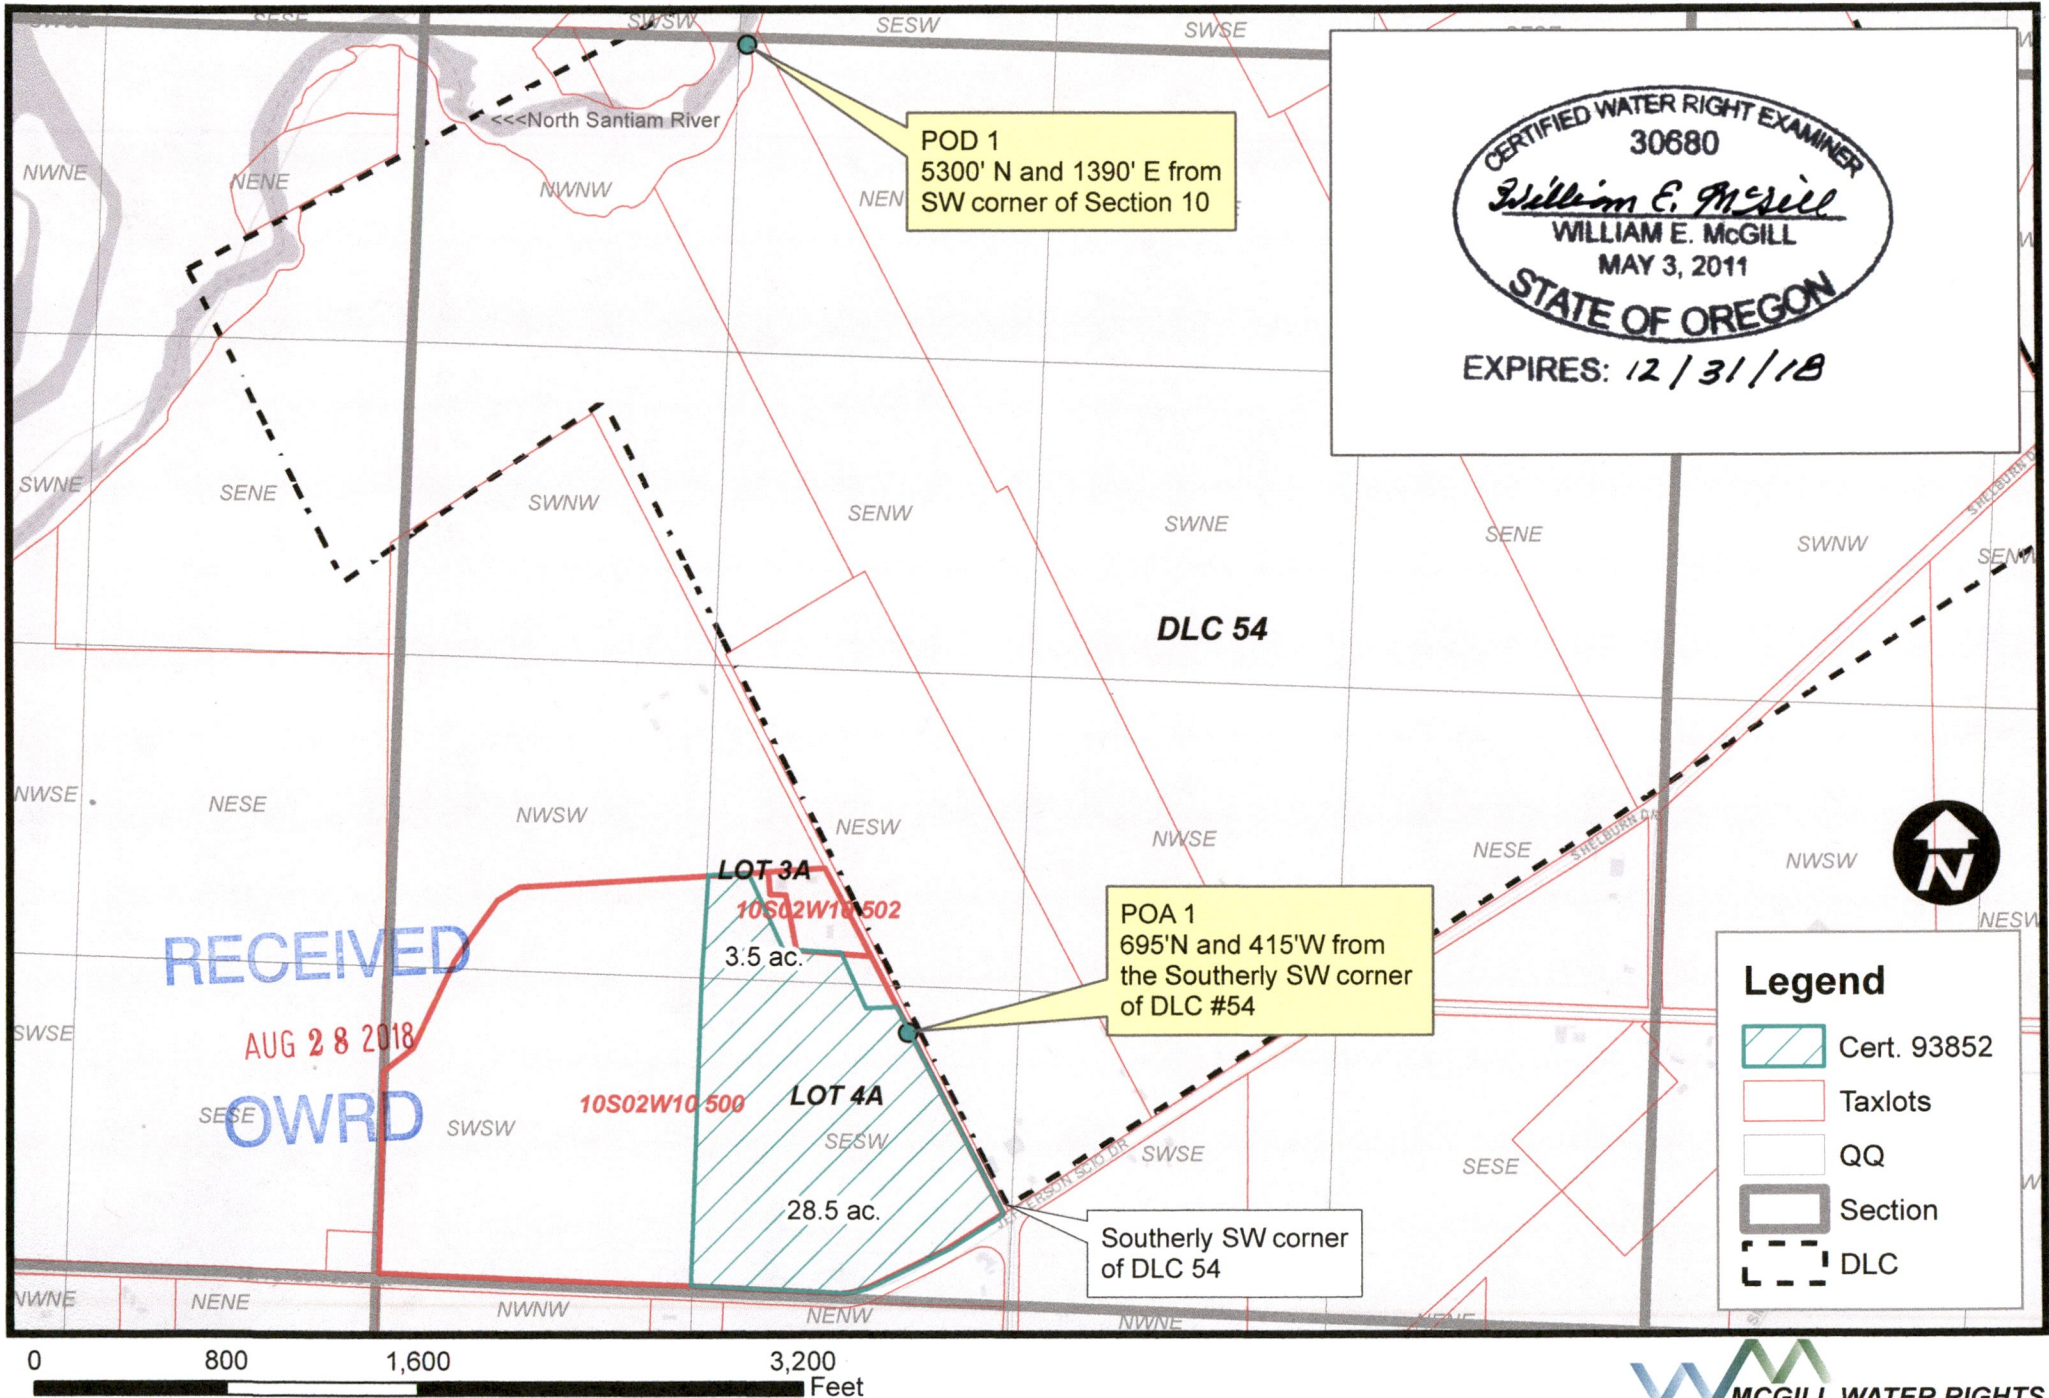


CERTIFIED WATER RIGHT EXAMINER  
 30680  
*William E. McGill*  
 WILLIAM E. MCGILL  
 MAY 3, 2011  
 STATE OF OREGON  
 EXPIRES: 12/31/18

**Legend**

- Cert. 93852
- Taxlots
- QQ
- Section
- DLC



Google Earth

Imagery Date: 7/3/2017 lat 44.711420° lon -122.928606° elev 294 ft eye alt 7785 ft 



canal  
all under  
Cont 62109

ABr 26 Ac. | 32.0  
New work | IS to IR  
Cont 93857

Robinson Dr.

POD

POD

9

10

11

10S2W

NE

NE

