


THIS MAP WAS PREPARED FOR  
ASSESSMENT PURPOSE ONLY

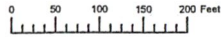


S.W.1/4 N.E.1/4 SEC.30 T.9S. R.46E. W.M.  
BAKER COUNTY  
1" = 100'

09S46E30AC

Cancelled  
600  
900



**T. 9S, R. 45E**

Authorized **C-83631**

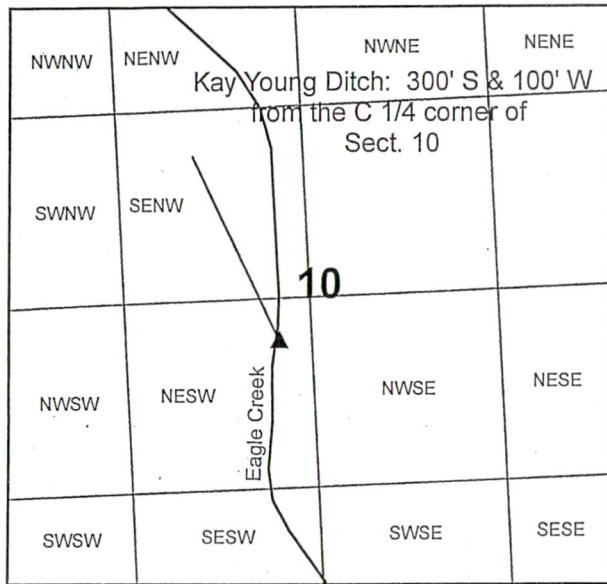


**T 8S R 45E**

Proposed **HISTORIC POD**

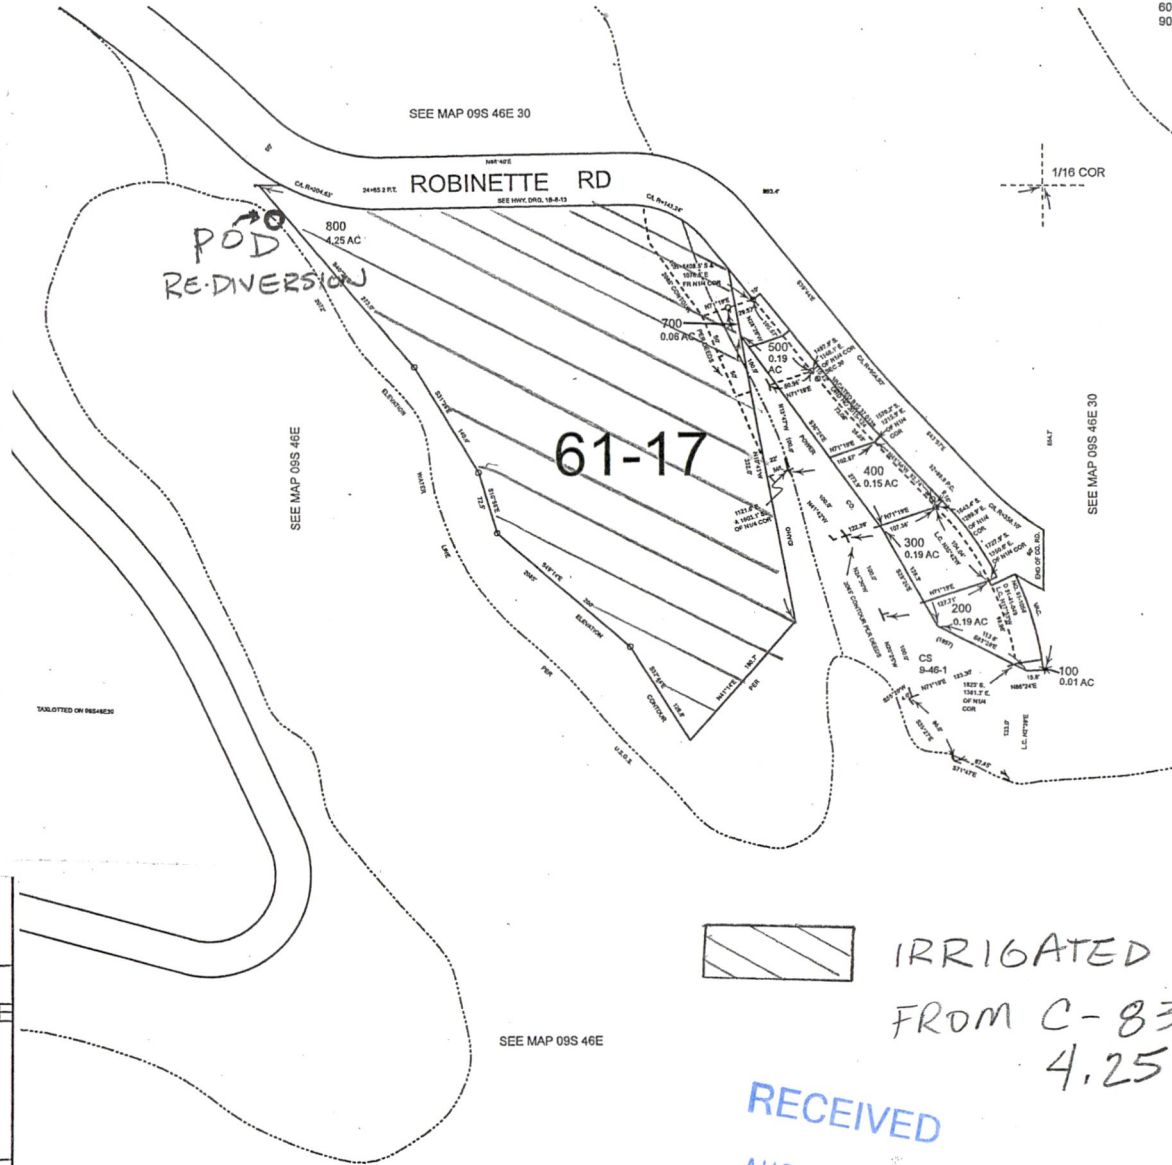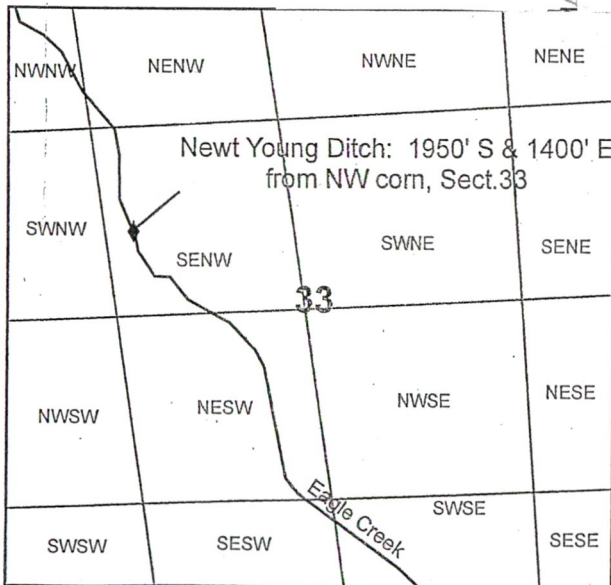

IRRIGATED ACRES  
FROM C-83631  
4.25 AC

RECEIVED  
AUG 31 2018  
OWRD

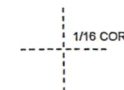

Revised: TK  
03/10/2017

09S46E30AC

# Atkeson Property

2015

Legend

Robbinette Rd

RECEIVED  
AUG 31 2018  
OWRD

Google Earth

© 2018 Google

400 ft



# Atkeson Property

2011

Legend

Robbinette Rd

RECEIVED

AUG 31 2018

OWRD

Google Earth

Image USDA Farm Service Agency



400 ft