

WATER RIGHT TEMPORARY TRANSFER APPLICATION MAP

CERTIFICATE: 65305 - PRIORITY DATE 3/13/1980

CHANGE IN PLACE OF USE

FOR

BUTTE FALLS RANCH LLC
5422 BUTTE FALLS HIGHWAY
EAGLE POINT, OR 97524


SITUATED IN

SECTION 5, TOWNSHIP 35 SOUTH, RANGE 1 EAST, W.M.
JACKSON COUNTY, OREGON


RECEIVED

SEP 06 2018

OWRD

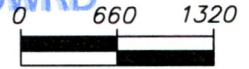

SCALE: 1"=1320'

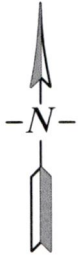


RENEWS: 12/31/2018

ROGUE CIVIL LLC
emalepsy@roguecivil.com 541-621-2868

This map is not intended to
provide legal dimensions or
locations of property
ownership lines.

EHM-August 16, 2018

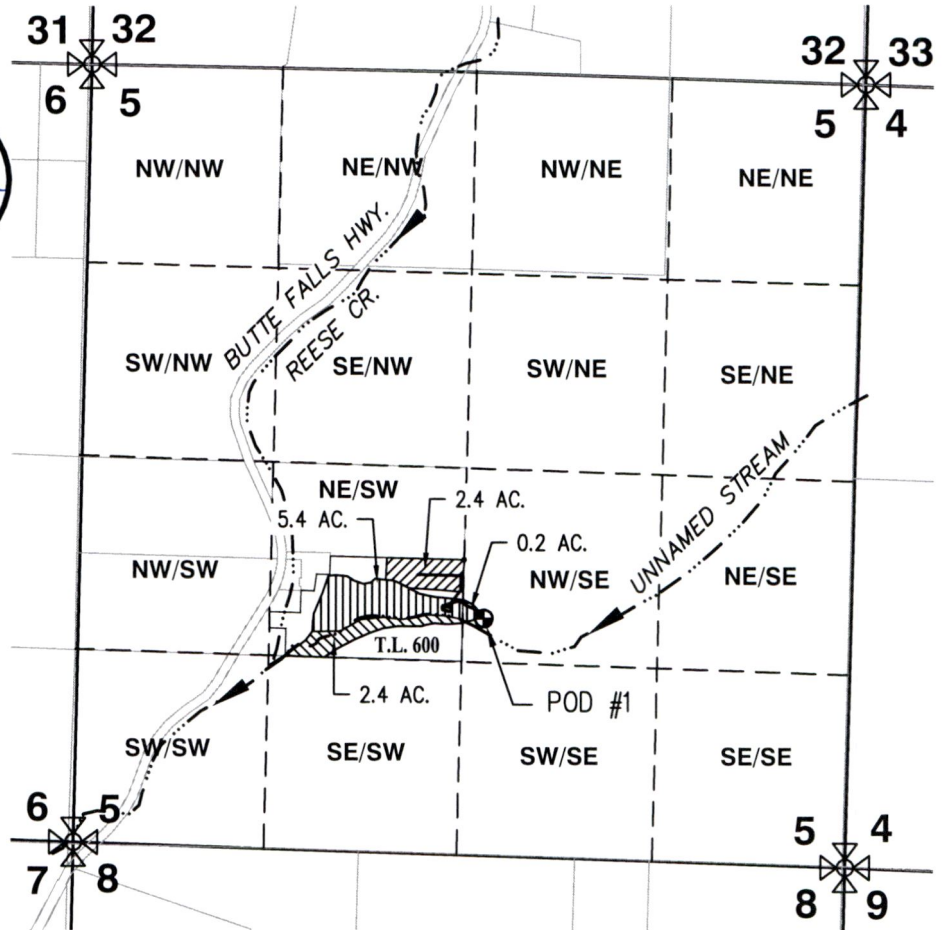

LEGEND

- POD #1
(EX. POINT OF DIVERSION CERTIFICATE 65305)
1610' NORTH AND 2760' EAST FROM THE SW
CORNER SECTION 5



PLACE OF USE CERT. 65305
NO CHANGES



PLACE OF USE CERT. 65305
CHANGE POU: FROM LANDS



PLACE OF USE CERT. 65305
CHANGE POU: TO LANDS

----- 1/4-1/4 SECTION LINE

----- EX. DITCH (APPROXIMATE)

----- CREEK/STREAM

Butte Falls Ranch

Google Earth Aerial Photo
Dated 7/4/2014

RECEIVED
SEP 06 2018
OWRD

Butte Falls Hwy

Google Earth



500 ft