


Swalley Irrigation District

2015 District Transfer Claim of Beneficial Use Map

Certificates: 74145

for Lennie & Charlotte Brant

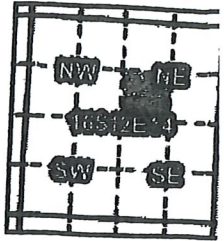

Taxlot 00603, 16S12E14SWNE: 2.05 ac. On, 9.0 Acres Remaining

RECEIVED

SEP 24 2018

OWRD





T-12230

1 inch = 400 feet

Swalley Irrigation District 2015 District Transfer Claim of Beneficial Use Map

Certificates: 74145
for Andrew & Cheryl Tillman

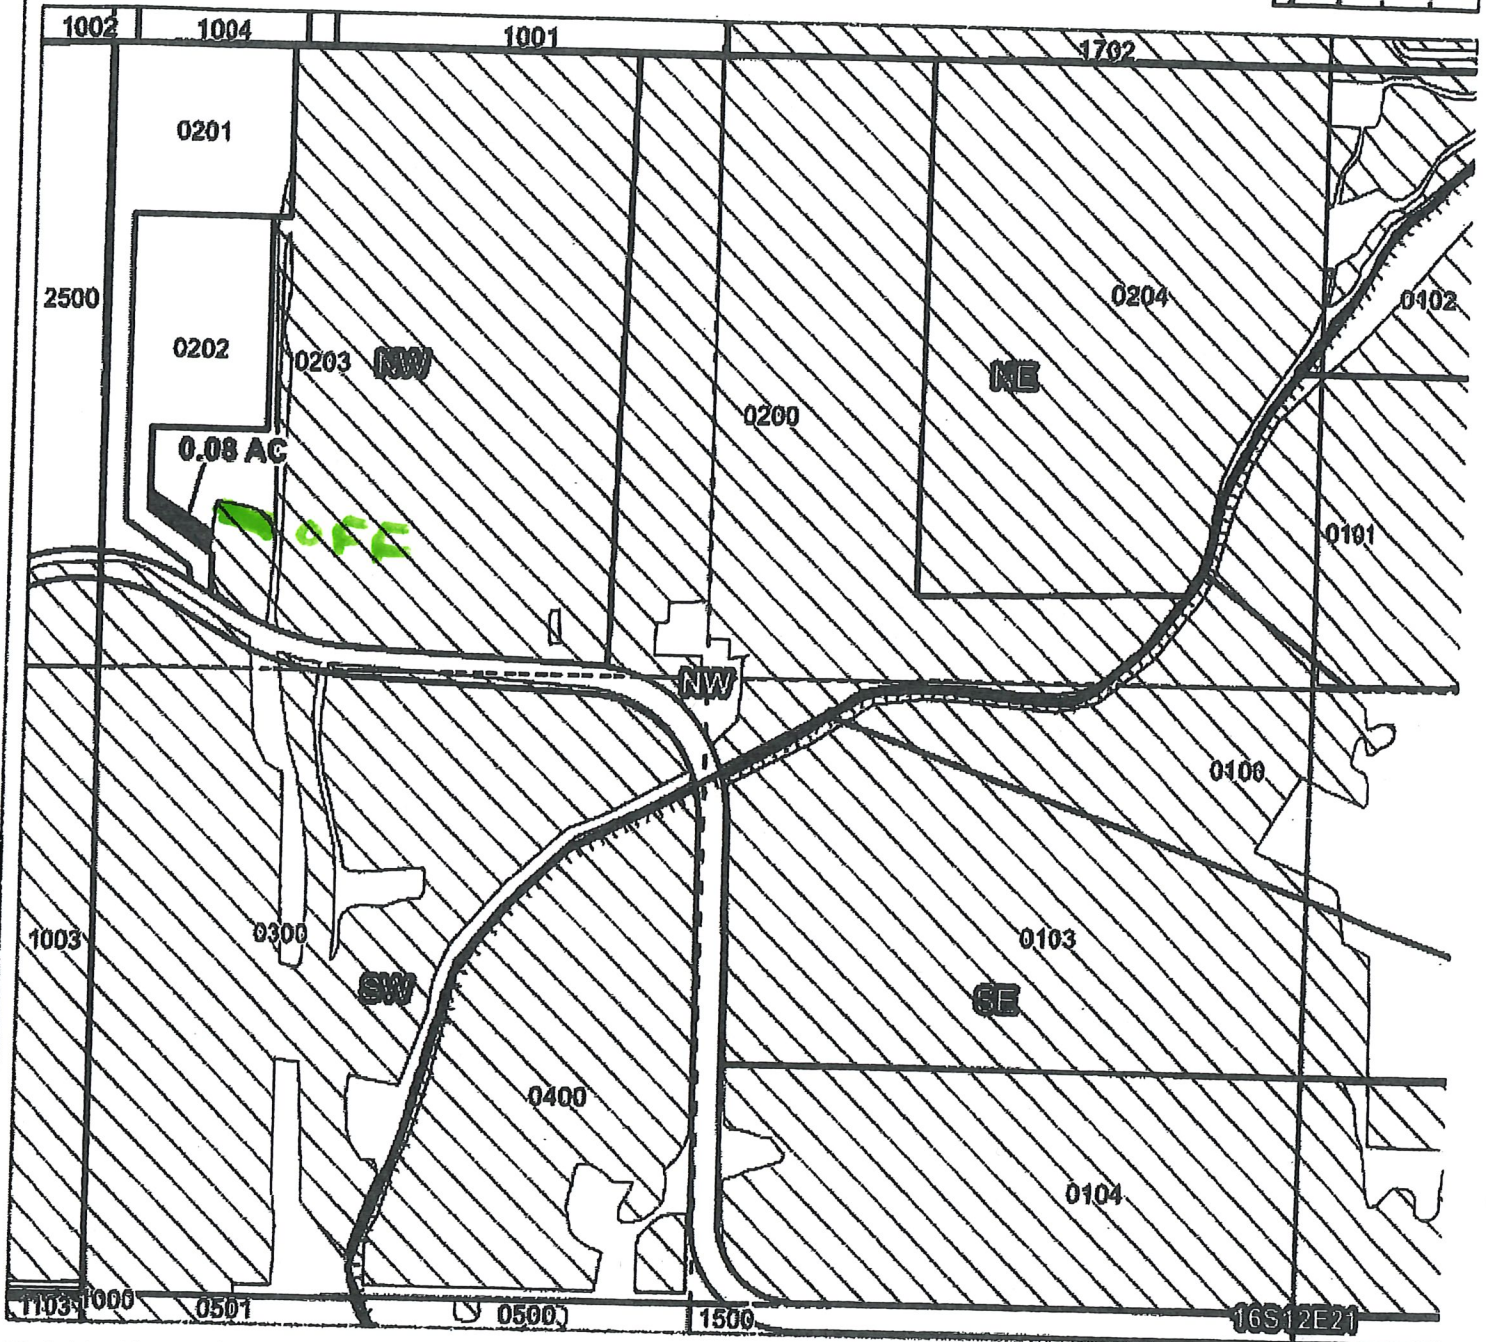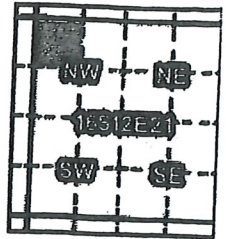

Taxlot 00203, 16S12E21NWNW: 0.08 ac. On, 23.0 Acres Remaining

- Point of Diversion
- Canals
- Taxlots
- Transfer
- Cert 74145

RECEIVED

SEP 24 2018

OWRD





T-12230

1 inch = 400 feet

Swalley Irrigation District

2015 District Transfer Claim of Beneficial Use Map

Certificates: 74145
for Trevor & Kristin Wigle

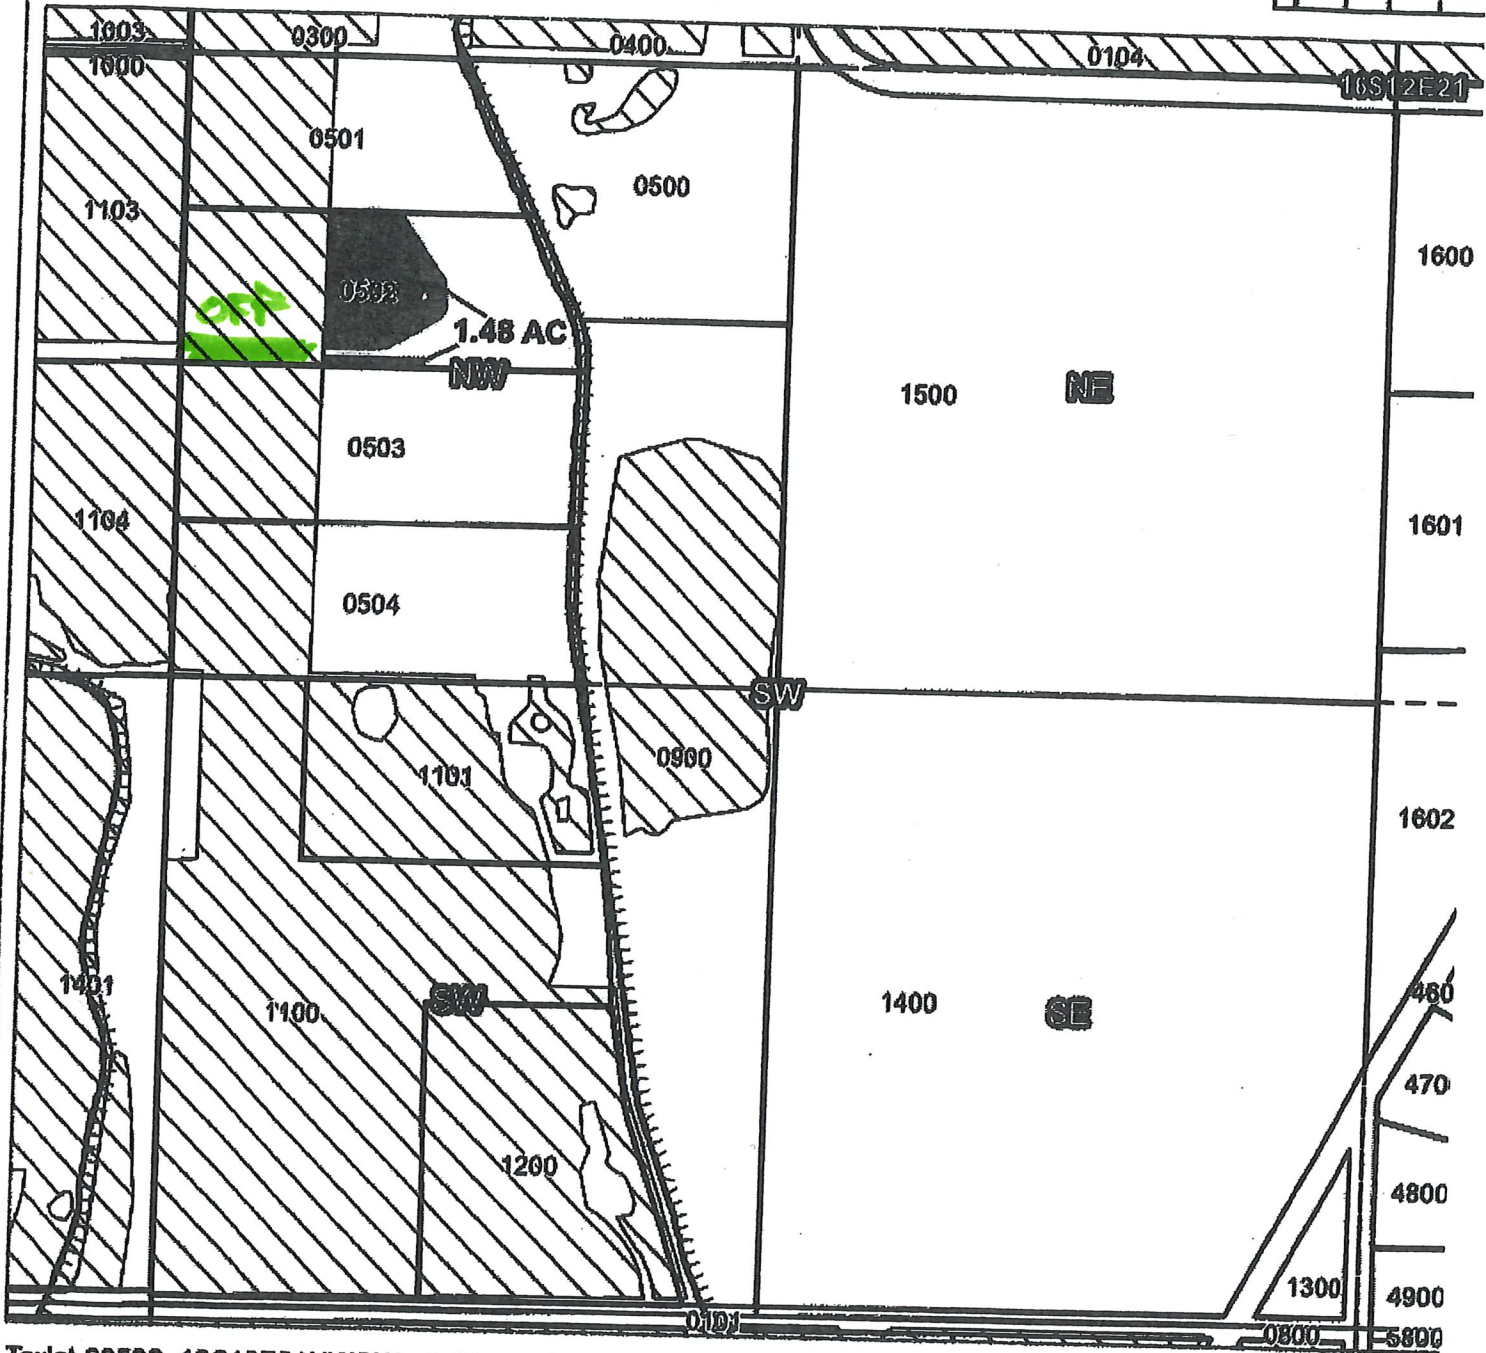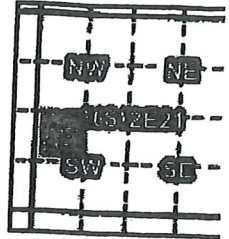

Taxlot 00502, 16S12E21NWSW: 1.48 ac. On, 3.60 Acres Total

- Point of Diversion
- ▬ Canals
- ▭ Taxlots
- Transfer
- ▨ Cert 74145

RECEIVED
SEP 24 2018
OWRD

T-12230





4 inch = 400 feet

Swalley Irrigation District

2015 District Transfer Claim of Beneficial Use Map

Certificates: 74145
for Timothy & Jenny Munson

OFF

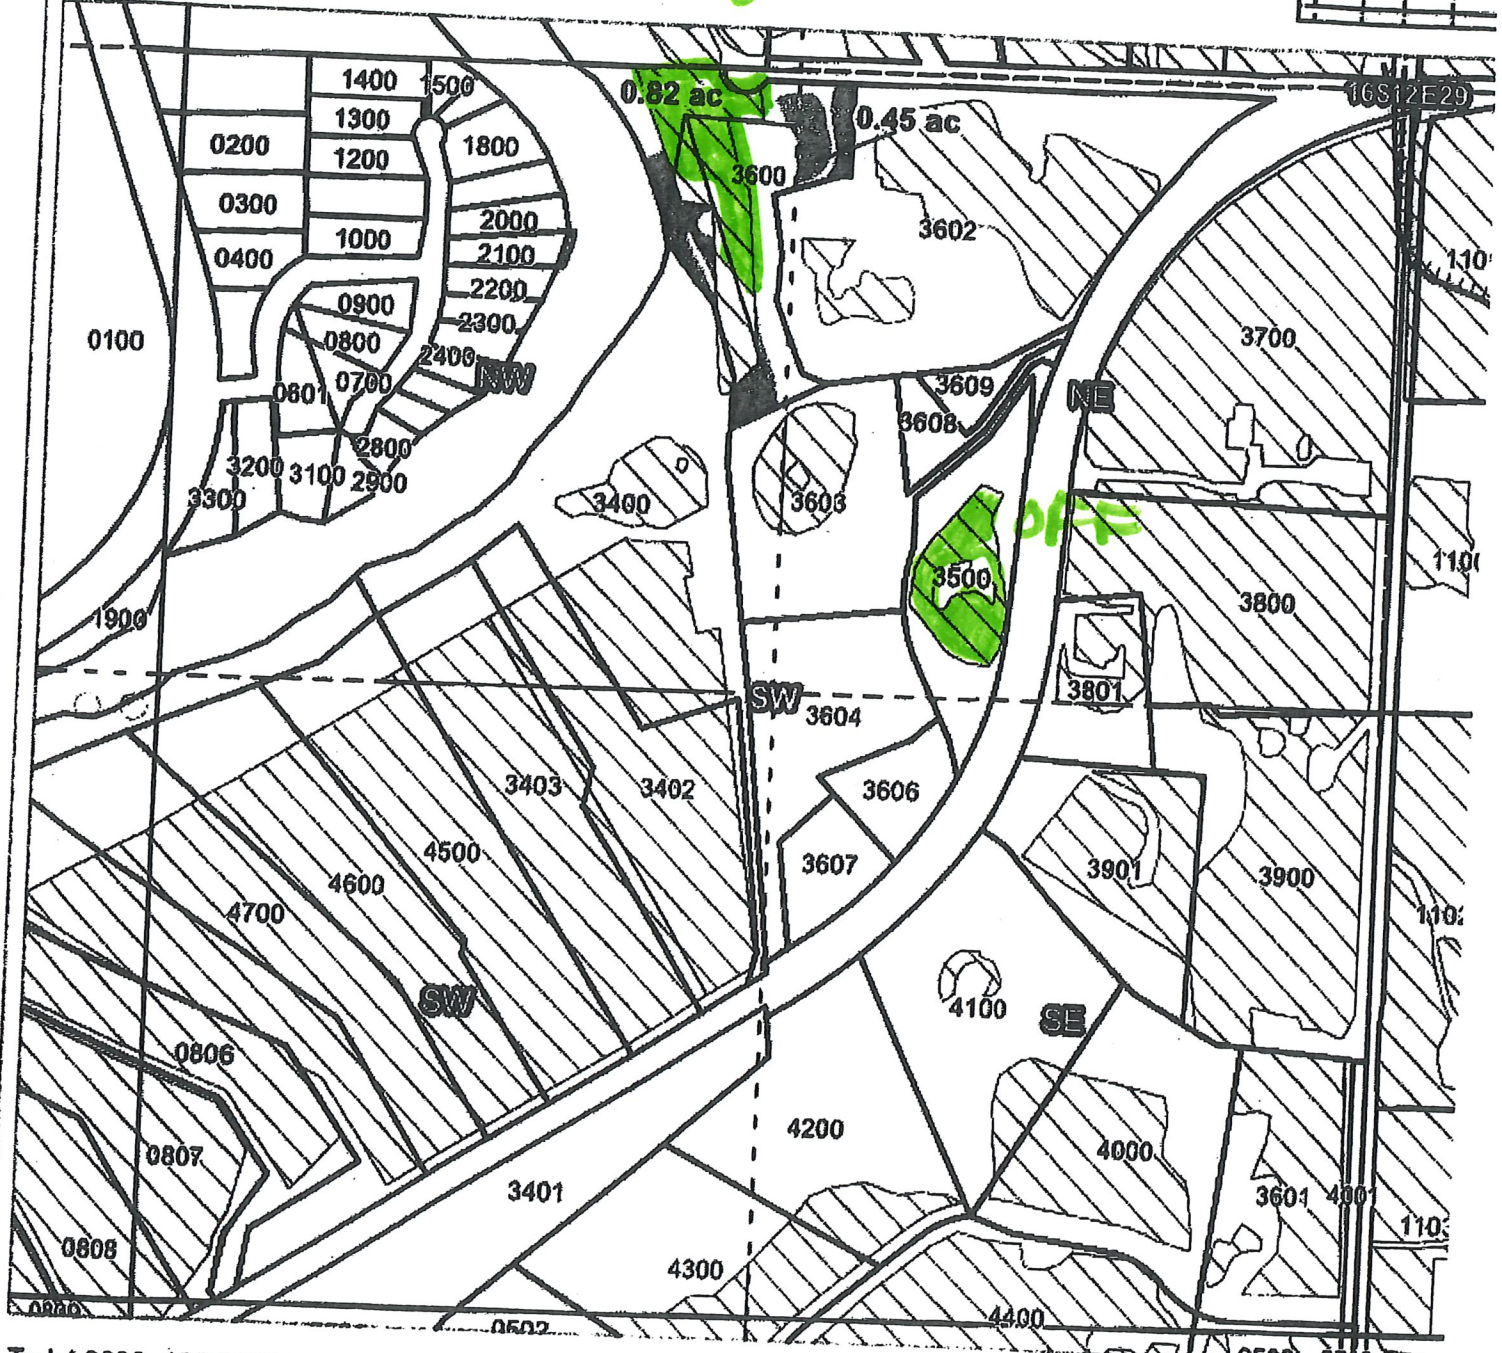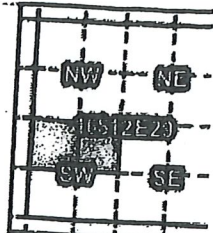

Taxlot 3600, 16S12E29NWSW: 0.82 ac. ON
Taxlot 3600, 16S12E29NESW: 0.45 ac. ON

- Point of Diversion
- ▬ Canals
- ▭ Taxlots
- ▨ Transfer
- ▭ Cert 74145


RECEIVED
SEP 24 2018
OWRD

T-12230




1 inch = 400 feet

Swalley Irrigation District 2015 District Transfer Claim of Beneficial Use Map

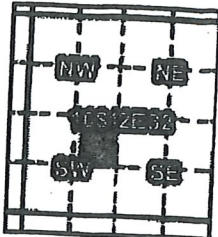

Certificates: 74145
for Eli & Dorothy Ashley

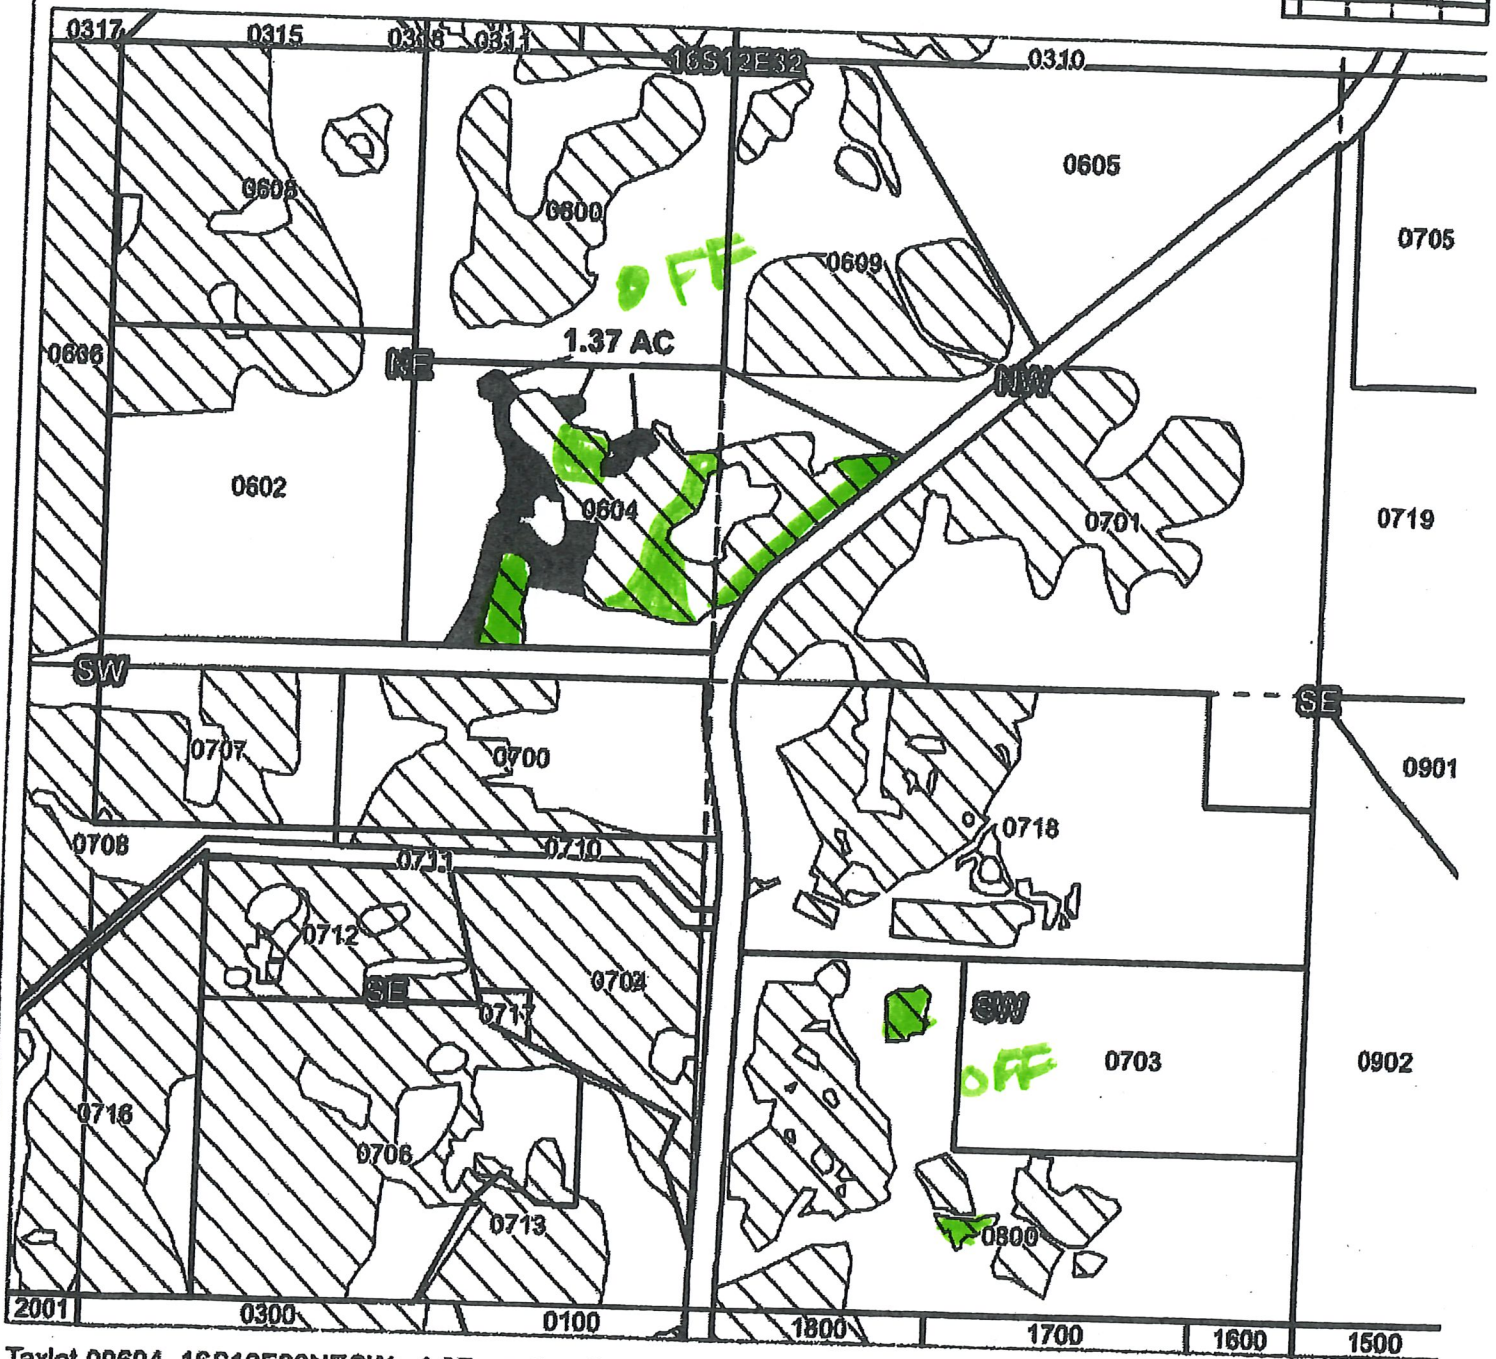

Taxlot 00604, 16S12E32NESW: 1.37 ac. On, 3.44 Acres Total

- Point of Diversion
- Canals
- Taxlots
- Transfer
- Cert 74145

RECEIVED
SEP 24 2018
OWRD





T-12230

1 inch = 400 feet

Swalley Irrigation District

2015 District Transfer Claim of Beneficial Use Map

Certificates: 74145
for Glen & Melodie Petry

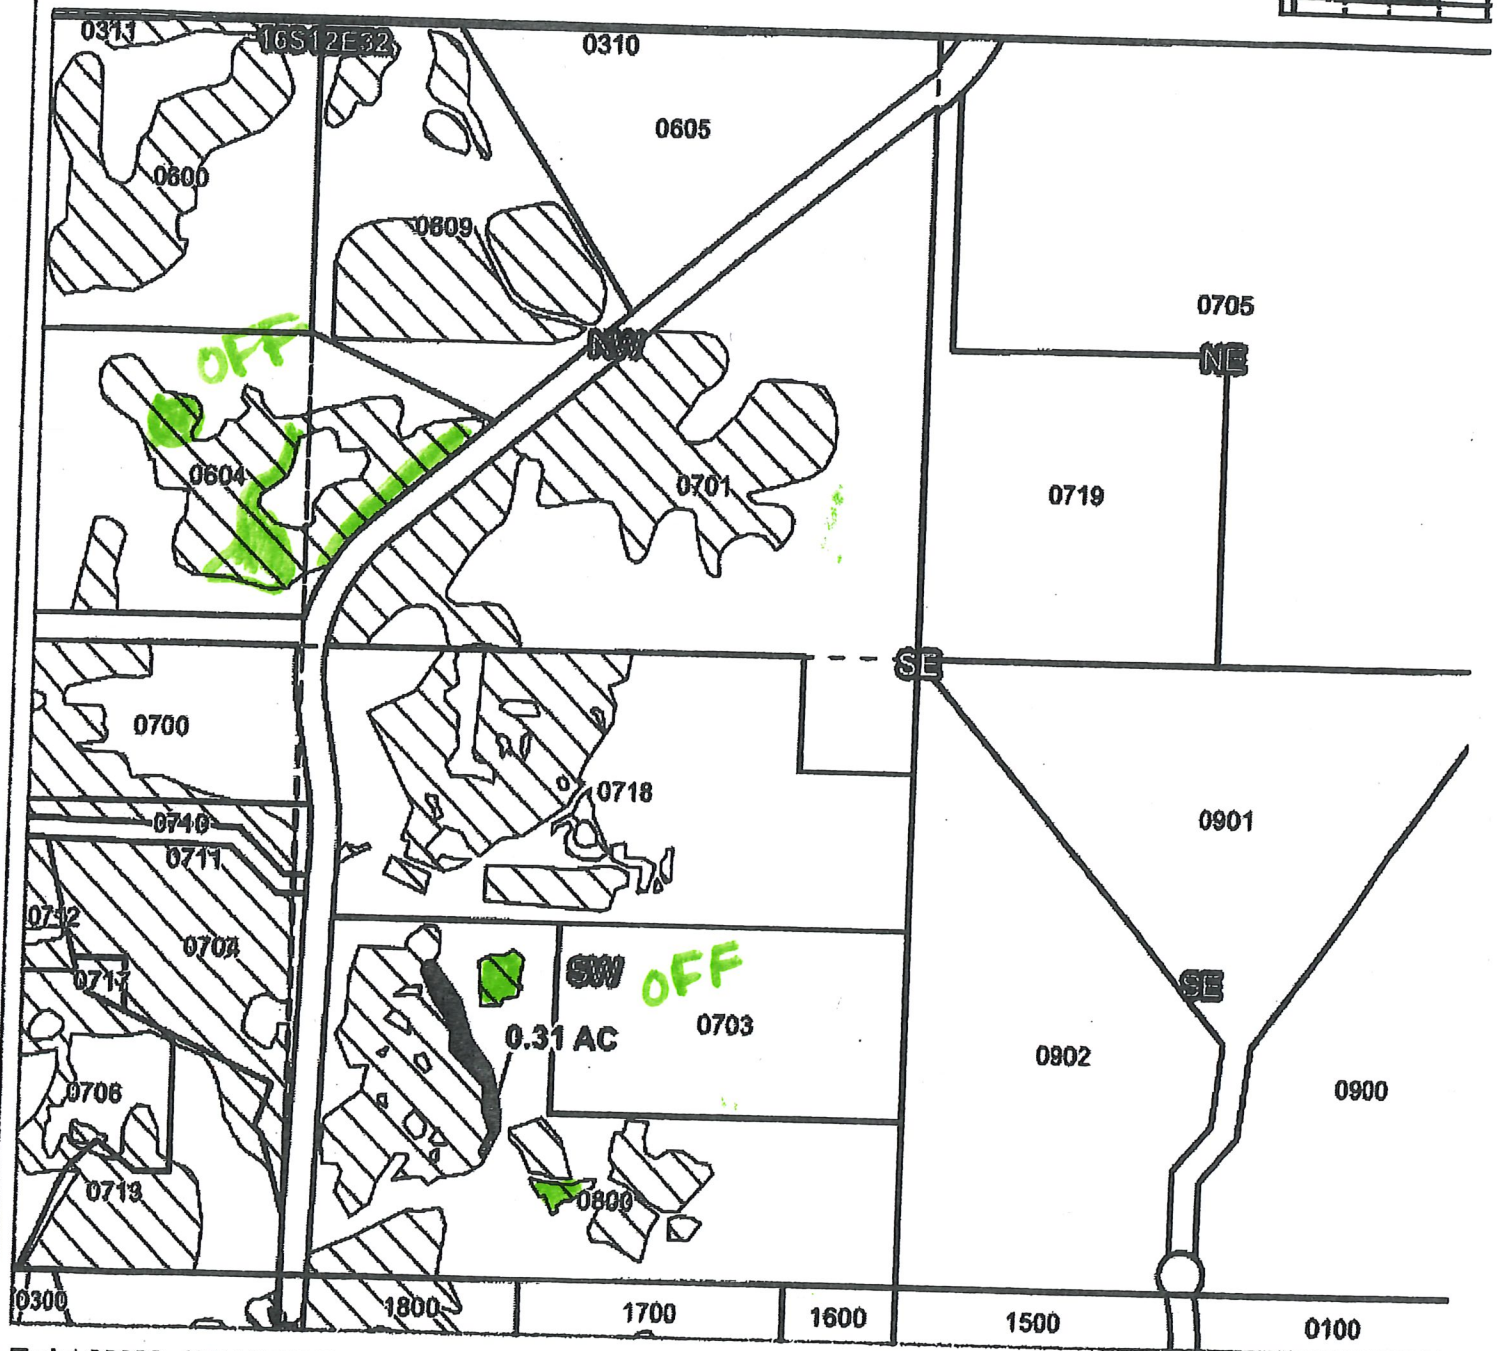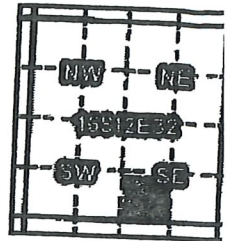

Taxlot 00800, 16S12E32SWSE: 0.31 ac. On, 4.8 Acres Total

- Point of Diversion
- Canals
- Taxlots
- Transfer
- Cert 74145

RECEIVED

SEP 24 2018

OWRD

T-12230





1 inch = 400 feet

Swalley Irrigation District

2015 District Transfer Claim of Beneficial Use Map

Certificates: 74145

for Kenneth & Audrey Moore

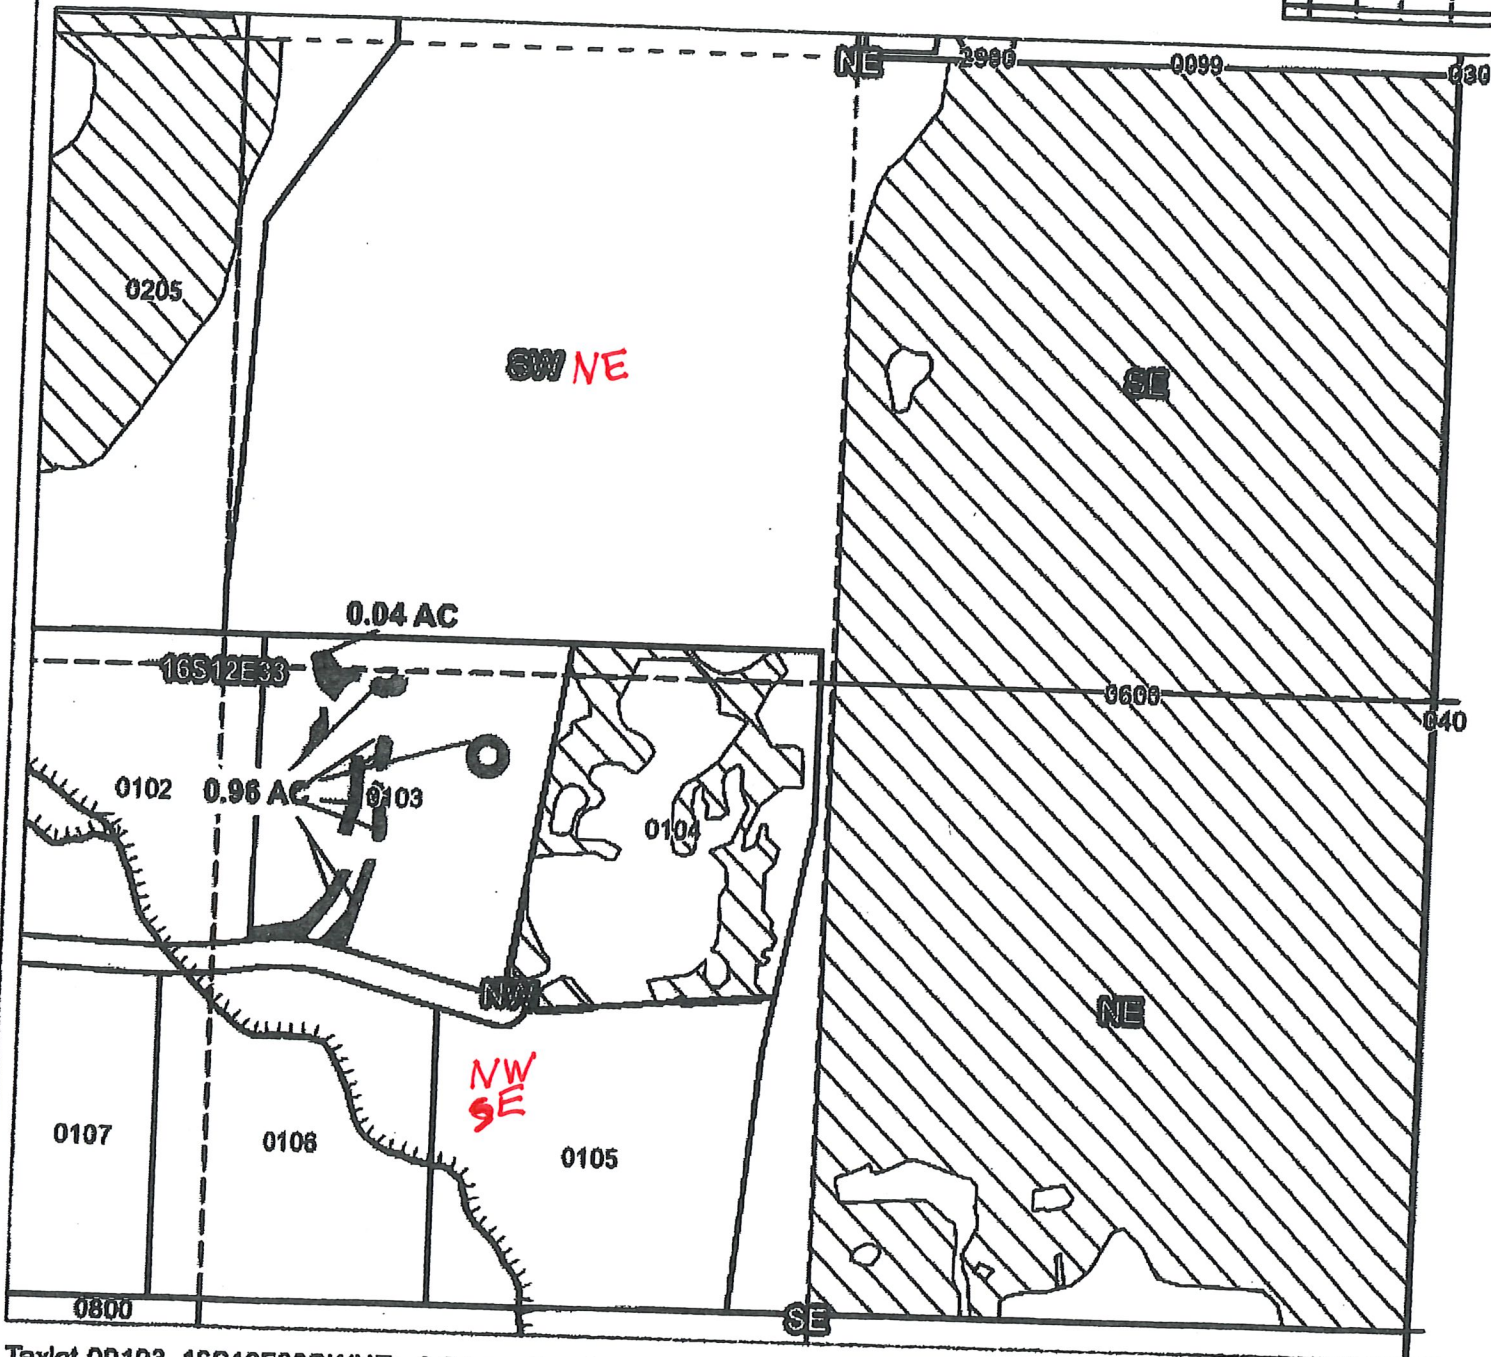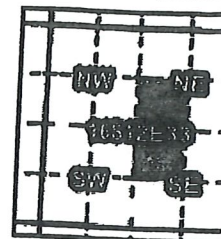

Taxlot 00103, 16S12E33SWNE: 0.04 ac. On, 0.04 Acres Total

Taxlot 00103, 16S12E33SWSE: 0.96 ac. On, 0.96 Acres Total

- Point of Diversion
- Canals
- Taxlots
- Transfer
- Cert 74145

RECEIVED

SEP 24 2018

OWRD



T-12230

4 inch = 400 feet


Swalley Irrigation District

2015 District Transfer Claim of Beneficial Use Map



Certificates: 74145

for Doug & Charise Millard

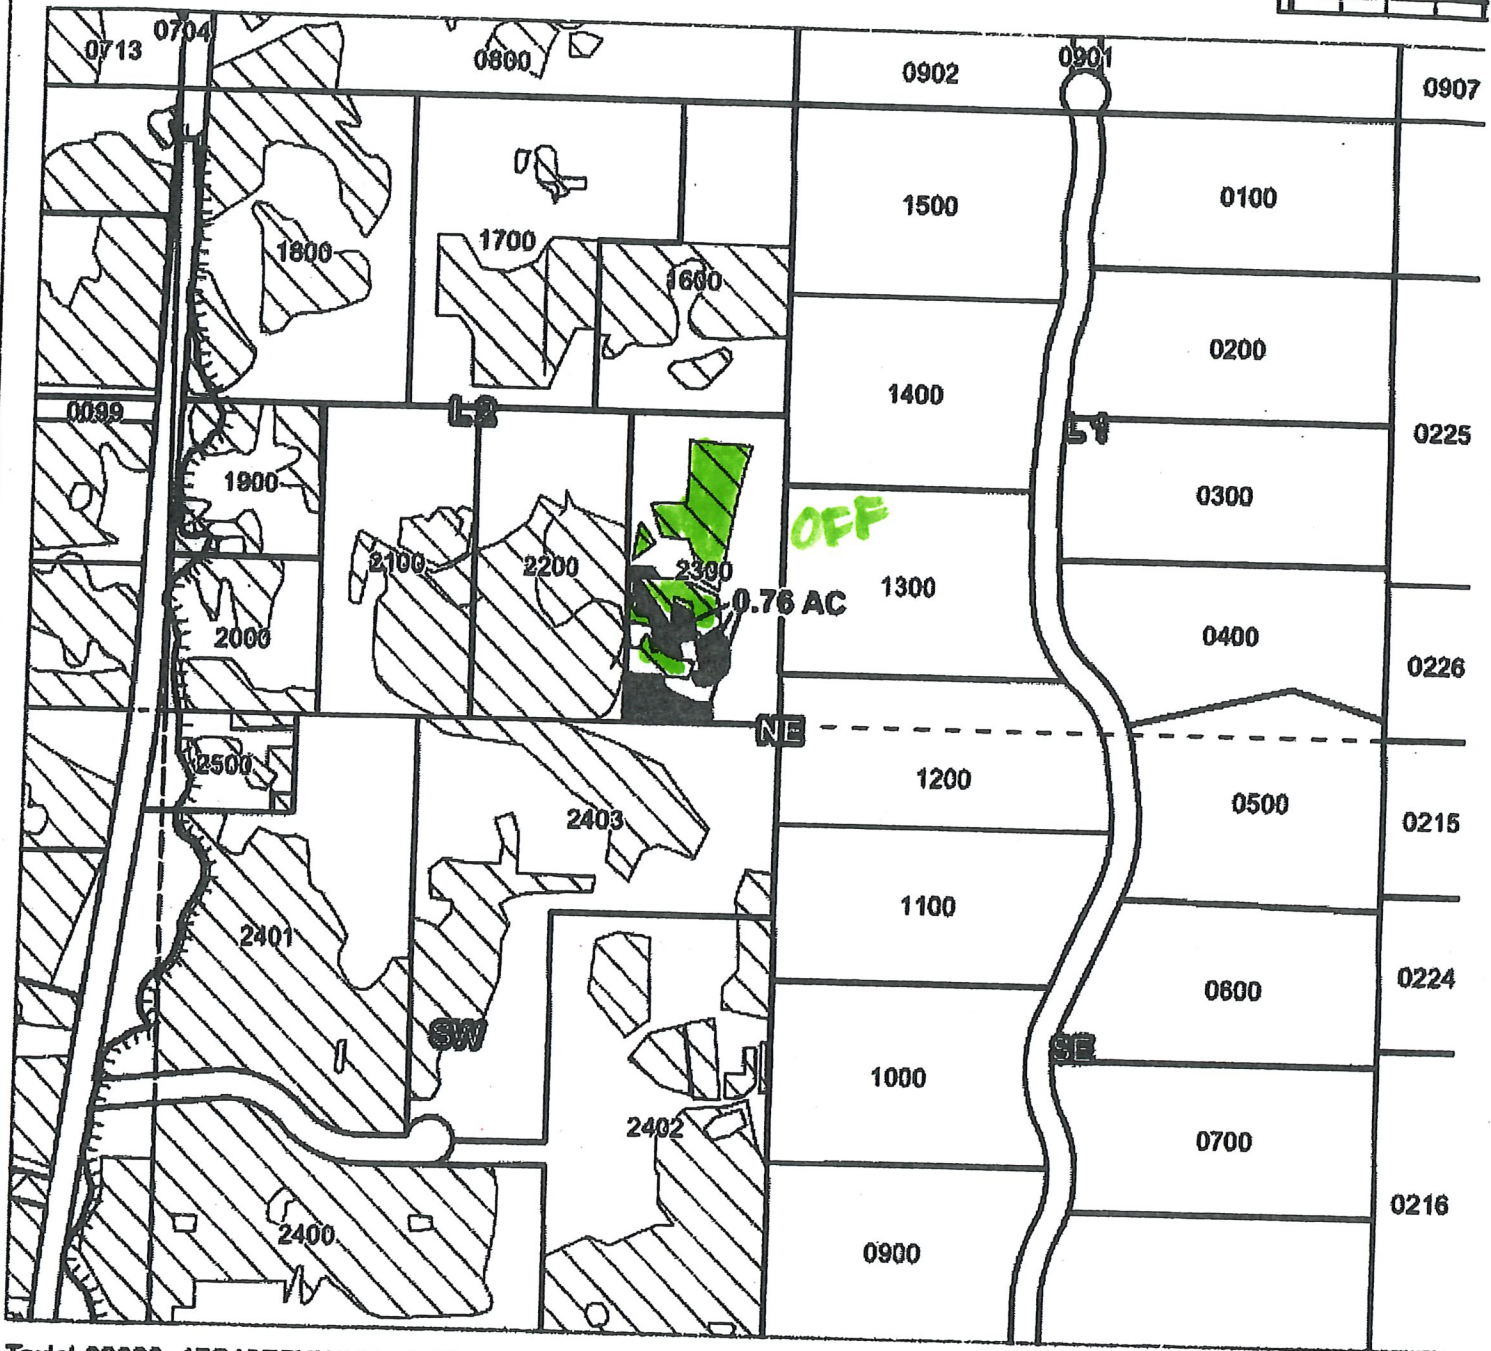

Taxlot 02300, 17S12E5NWNE: 0.76 ac. On, 1.0 Acres Total

RECEIVED

SEP 24 2018

OWRD

- Point of Diversion
- Canals
- Taxlots
- Transfer
- Cert 74145





1 inch = 400 feet

T-12230

Swalley Irrigation District

2015 District Transfer Claim of Beneficial Use Map

Certificates: 74145
for Gary Johansen

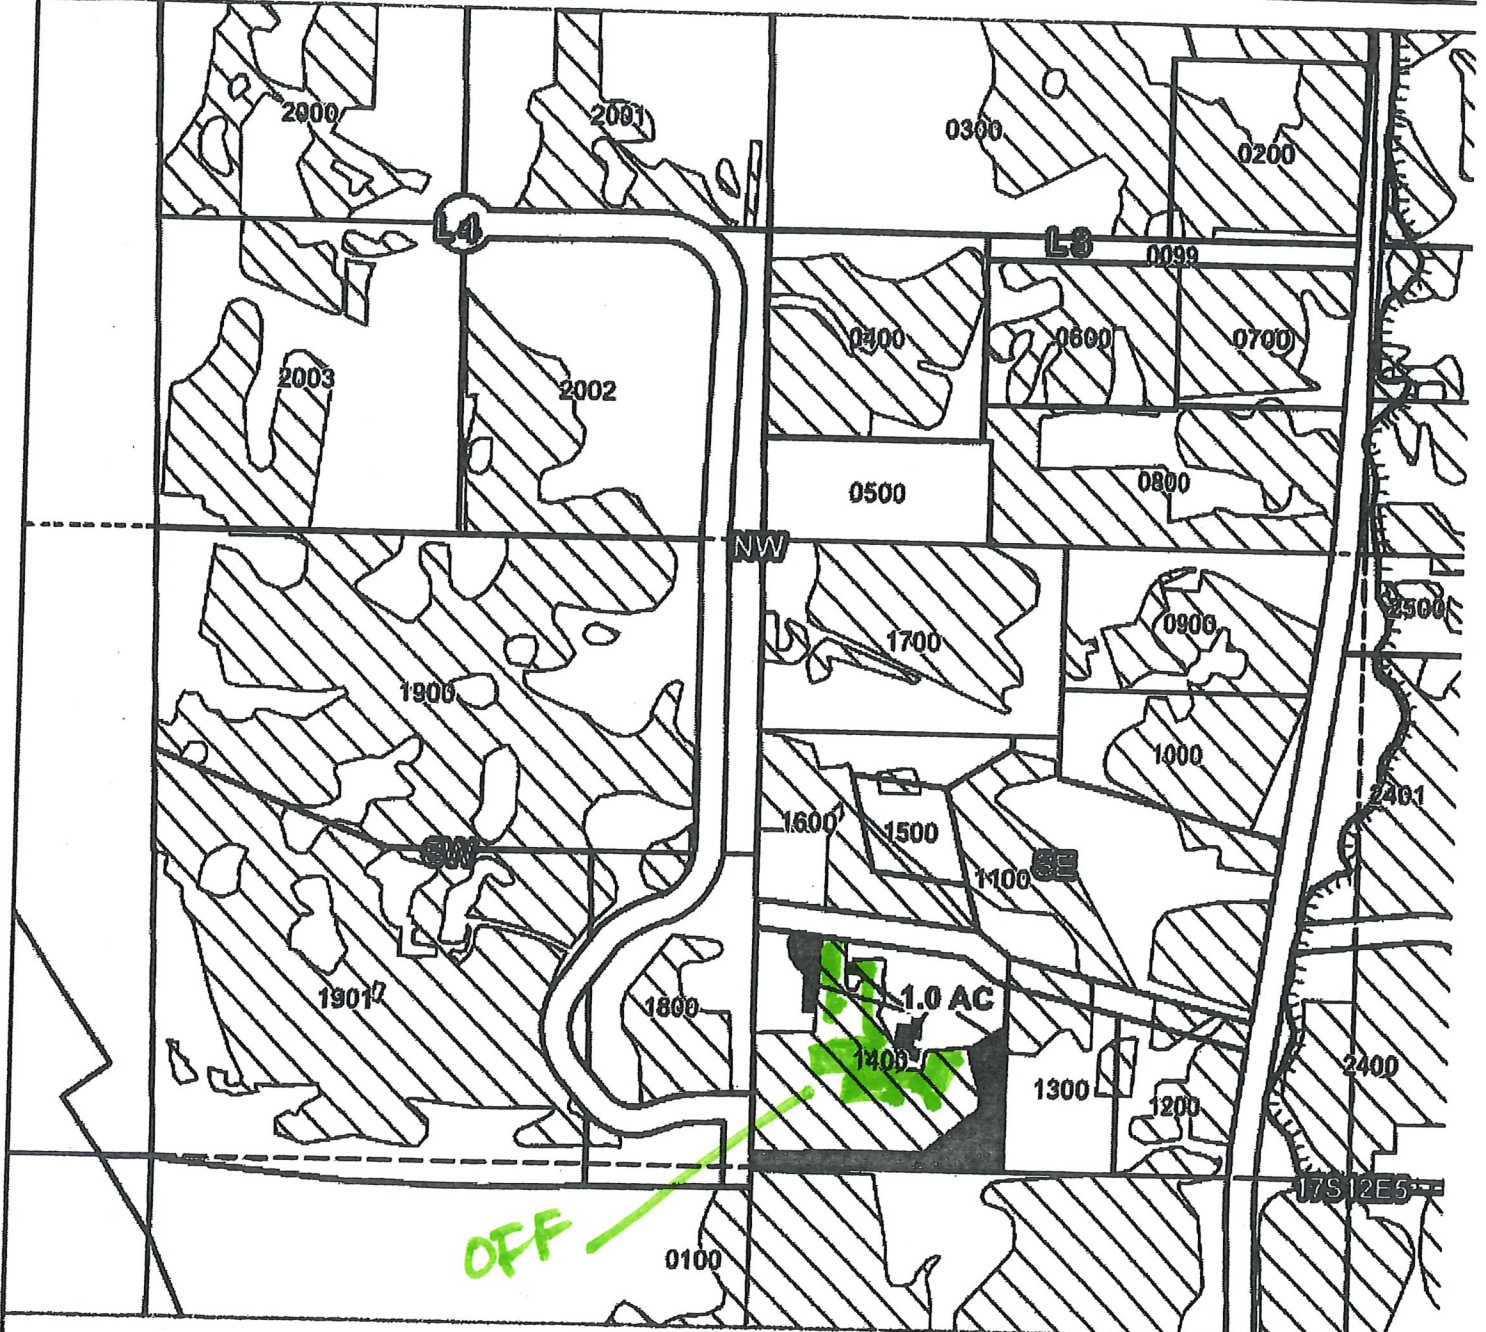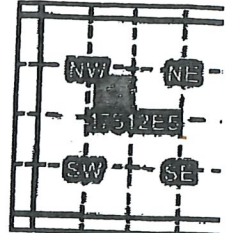

Taxlot 01400, 17S12E5SENW: 1.0 ac. On, 3.0 Acres Remaining

- Point of Diversion
- ▬ Canals
- ▭ Taxlots
- Transfer
- ▨ Cert 74145

RECEIVED

SEP 24 2018

OWRD

T-12230





1 inch = 400 feet

Swalley Irrigation District

2015 District Transfer Claim of Beneficial Use Map

Certificates: 74145

for Robert & Nancy Meyer

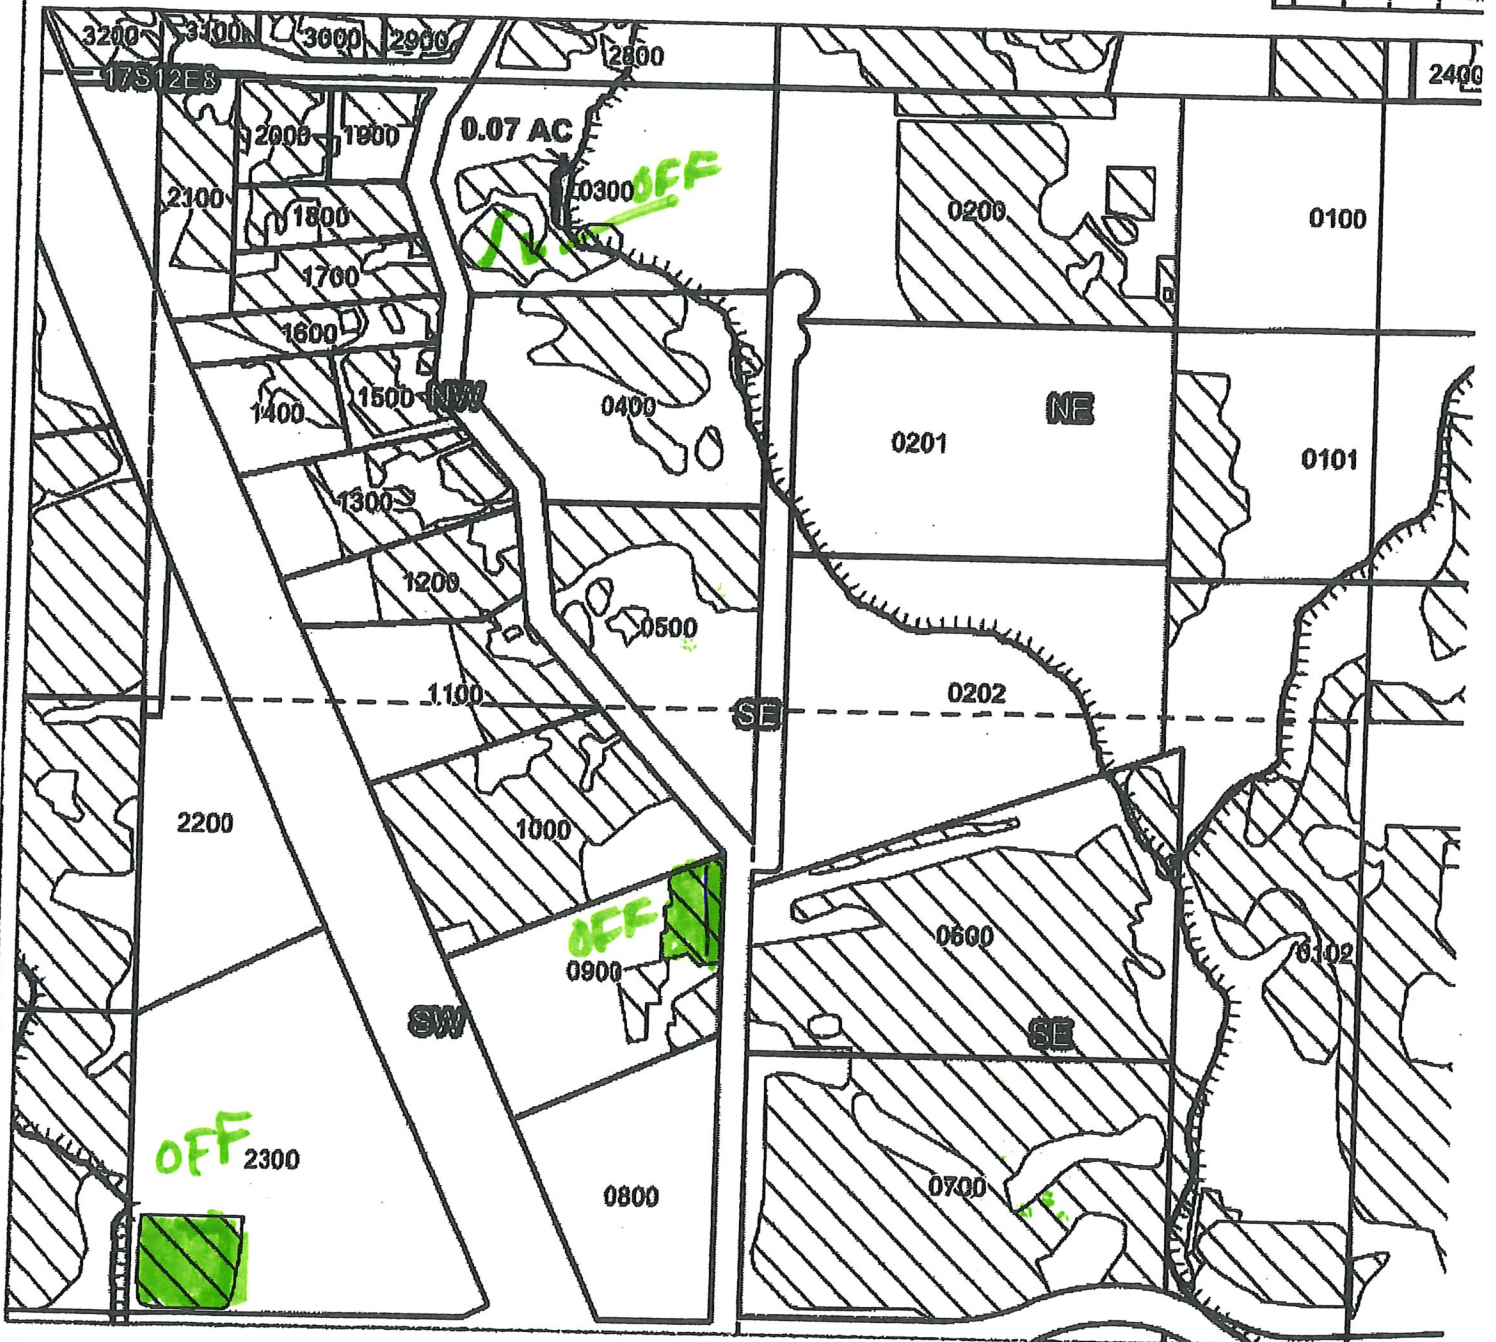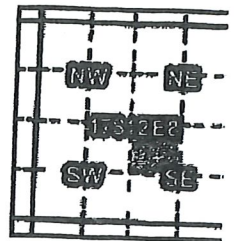

Taxlot 00300, 17S12E8NWSE: 0.07 ac. On, 1.50 Acres Total

T-12230

RECEIVED

SEP 24 2018

OWRD

- Point of Diversion
- ▤ Canals
- ▭ Taxlots
- ▨ Transfer
- ▩ Cert 74145





1 inch = 400 feet

Swalley Irrigation District

2015 District Transfer Claim of Beneficial Use Map

Certificates: 74145
for Elaine Yandle-Roth

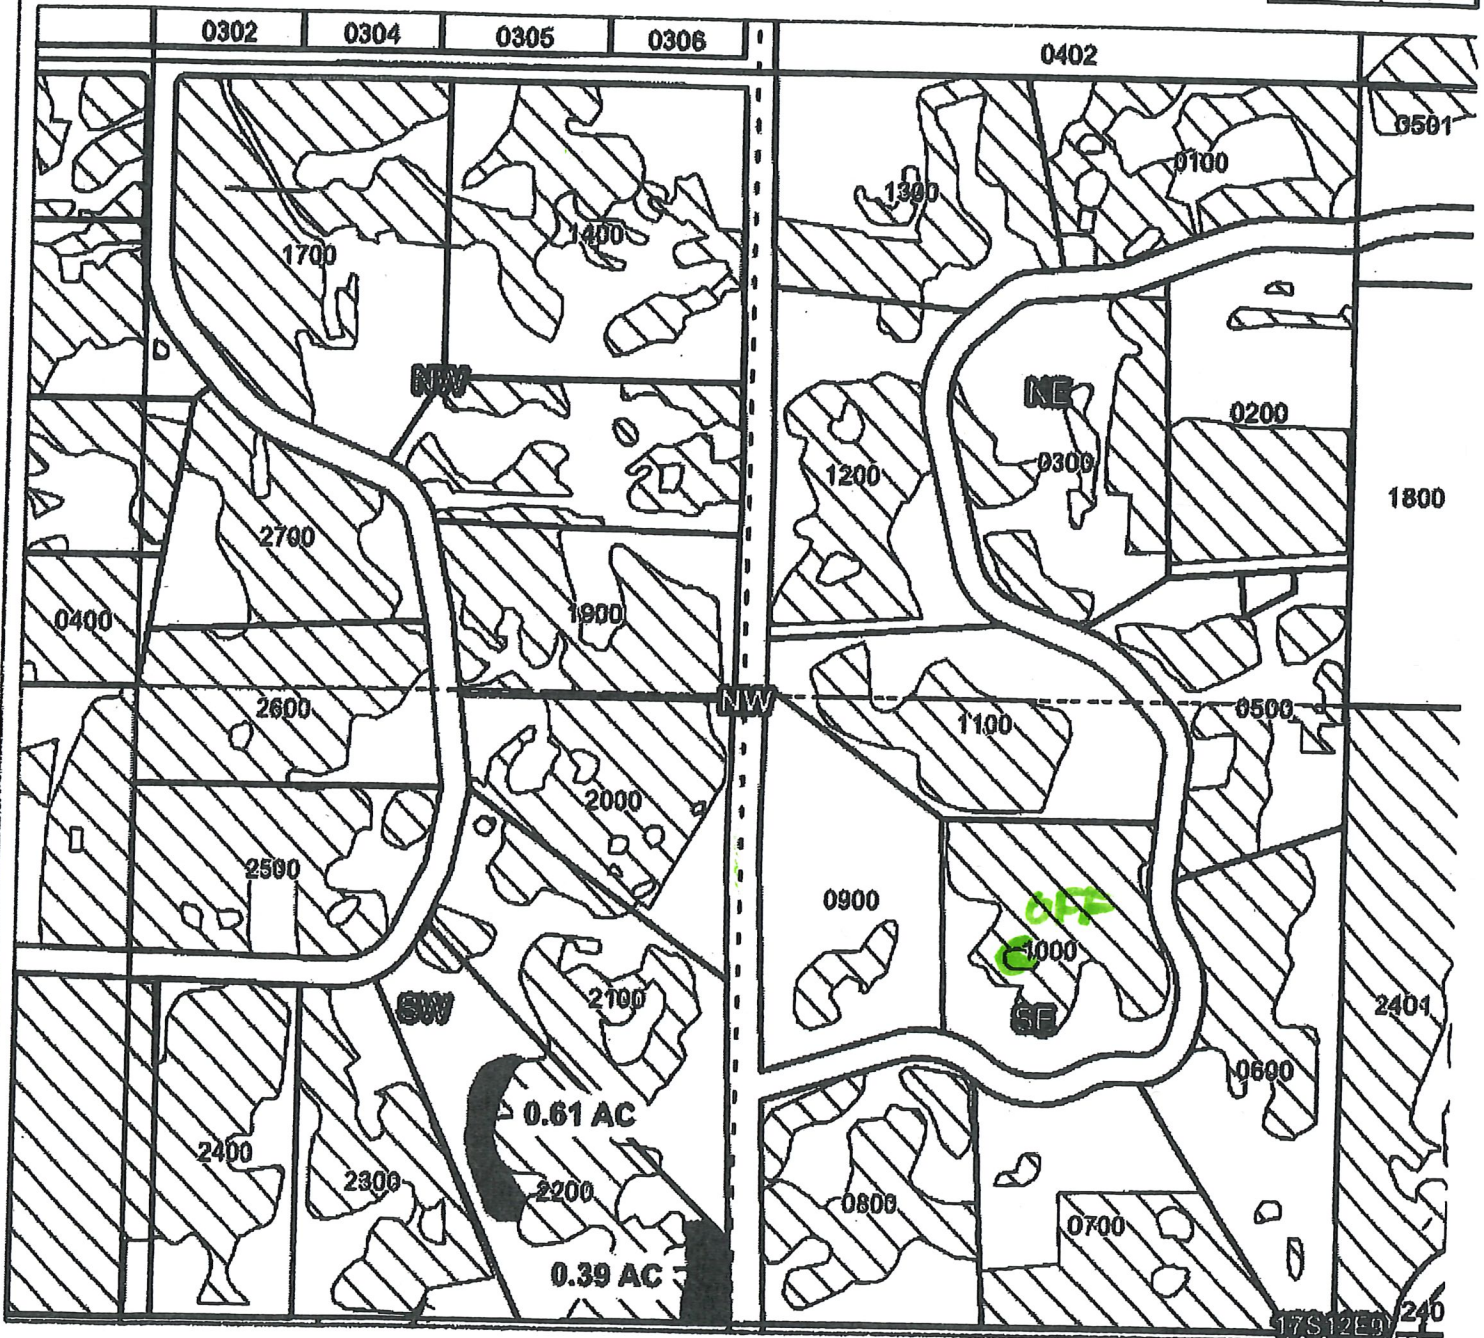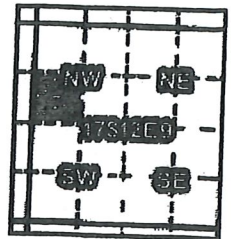

Taxlot 02200, 17S12E9SWNW: 0.61 ac. On, 0.61 Acres Total
Taxlot 02200, 17S12E9SWNW: 0.39 ac. On, 0.39 Acres Total

RECEIVED

SEP 24 2018

OWRD



- Point of Diversion
- Canals
- Taxlots
- Transfer
- Cert 74145



T-12230

Swalley Irrigation District 2015 District Transfer Claim of Beneficial Use Map

Certificates: 74145
for Duane Barker

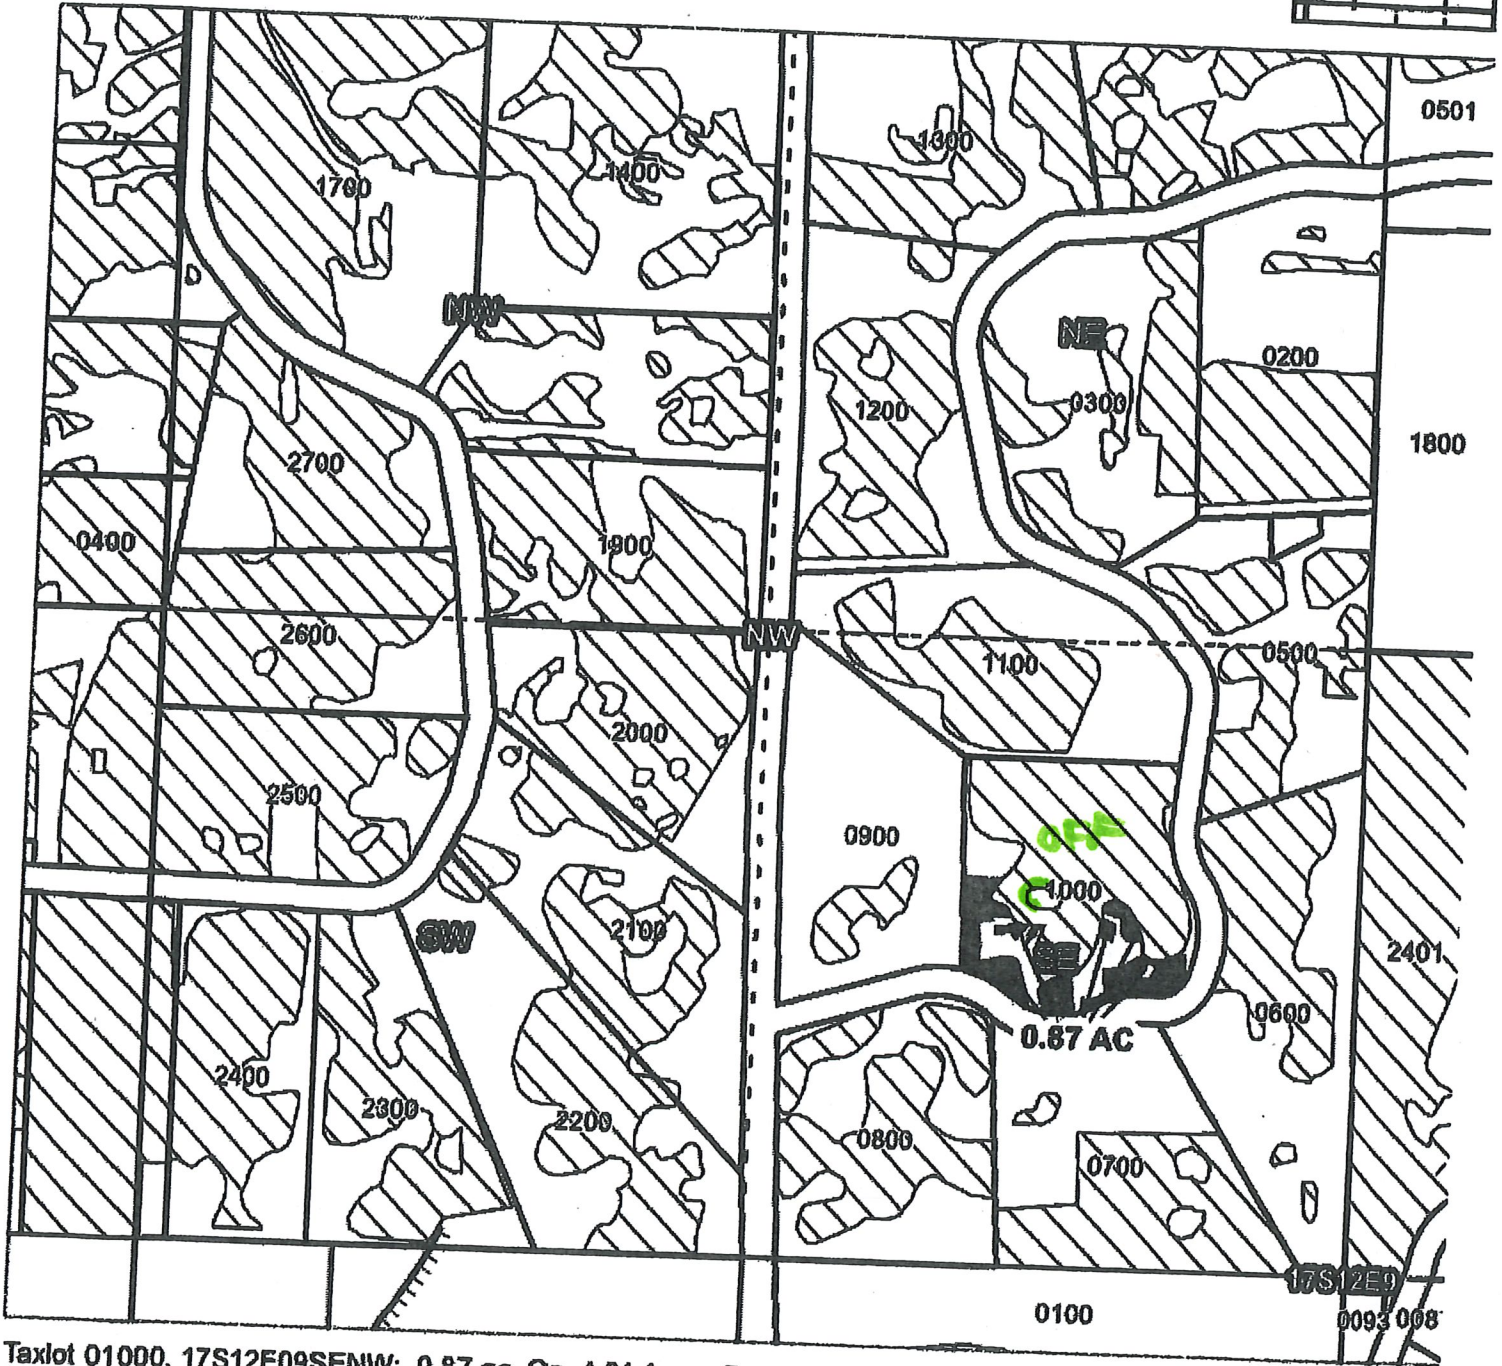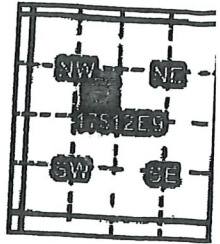

Taxlot 01000, 17S12E09SE9W: 0.87 ac. On, 4.31 Acres Remaining

- Point of Diversion
- Canals
- Taxlots
- Transfer
- Cert 74145

RECEIVED

SEP 24 2018

OWRD

T-12230




1 inch = 400 feet

Swalley Irrigation District

2015 District Transfer Claim of Beneficial Use Map

Certificates: 74145

for Todd & Joanie Penhollow

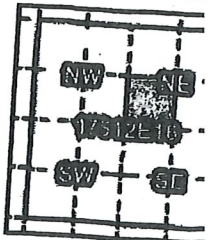

Taxlot 1500, 17S12E16SWNE: 0.40 ac ON, 0.40 Acres Total

RECEIVED

SEP 24 2018

OWRD

- Point of Diversion
- Canals
- Taxlots
- Transfer
- Cert 74145



1 inch = 400 feet

T-12230