

OFF

87035/86377

MAP #1

STANFIELD IRRIGATION DISTRICT  
TOWNSHIP 4 NORTH, RANGE 29 EAST, W.M.


T 12817 Draft

Proposed Map  
March 2018

1 Acres 1905 OFF  
Section 3

NWSW

TL 400

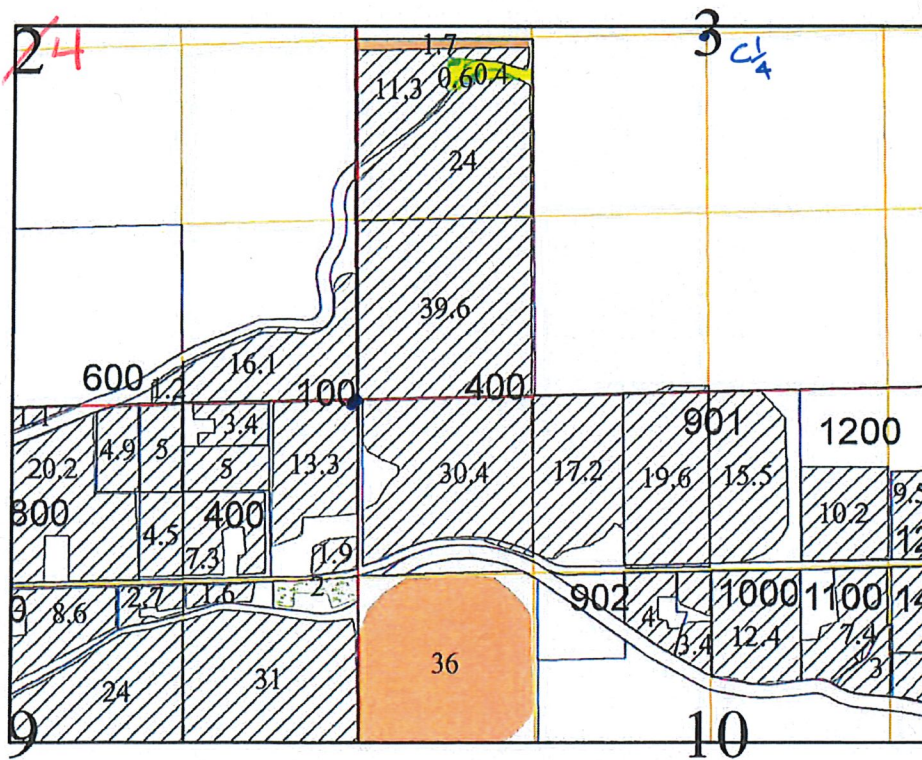

stan429final

Priority, USER, Stage

1965, 86203,

1905, 87035,

1905, 87035, OFF 1.0 / 86377

1905, 87035, ON



1 inch = 1320 feet

This map is not intended to provide legal dimensions or locations of property ownership lines.

JUN 15 2018

Salem, OR

T-12817

LATHAM


Map 1A

T. 4N., R. 29E., W.M., Sec. 10

Tax Lot 901

QQ NE NW 1.0 Acres

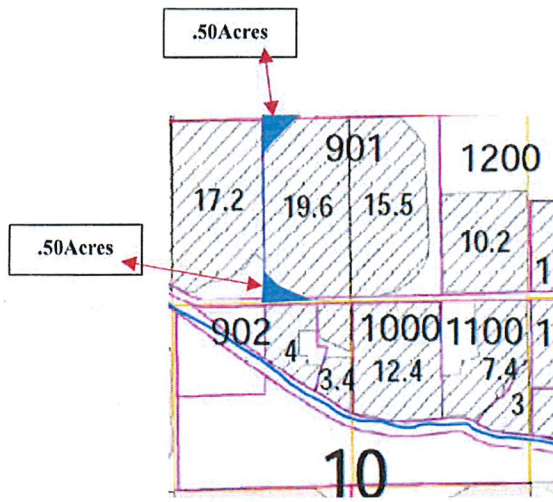

OFF



OK Key

### Legend

Priority, Primary, Suppl

-  1905, 87035, 86377
-  1965, 86203, 86377
-  1965, 86203, 86205
-  1905, 87035, 86377 – OFF

Scale: 1 in. = 1320 ft.

## “FROM” LANDS”

2017 STANFIELD IRRIGATION DISTRICT PERMANENT TRANSFER

PTT-2017-LATHAM

Received by OWRD

JUN 15 2018

Salem, OR

T-12817

LATHAM

MAP #3

STANFIELD IRRIGATION DISTRICT

TOWNSHIP 4 NORTH, RANGE 29 EAST, W.M.


T 12817 Draft

Proposed Map  
March 2018

87035

0.5 OFF  
Section 22 SESE TL 2800

OK Ray

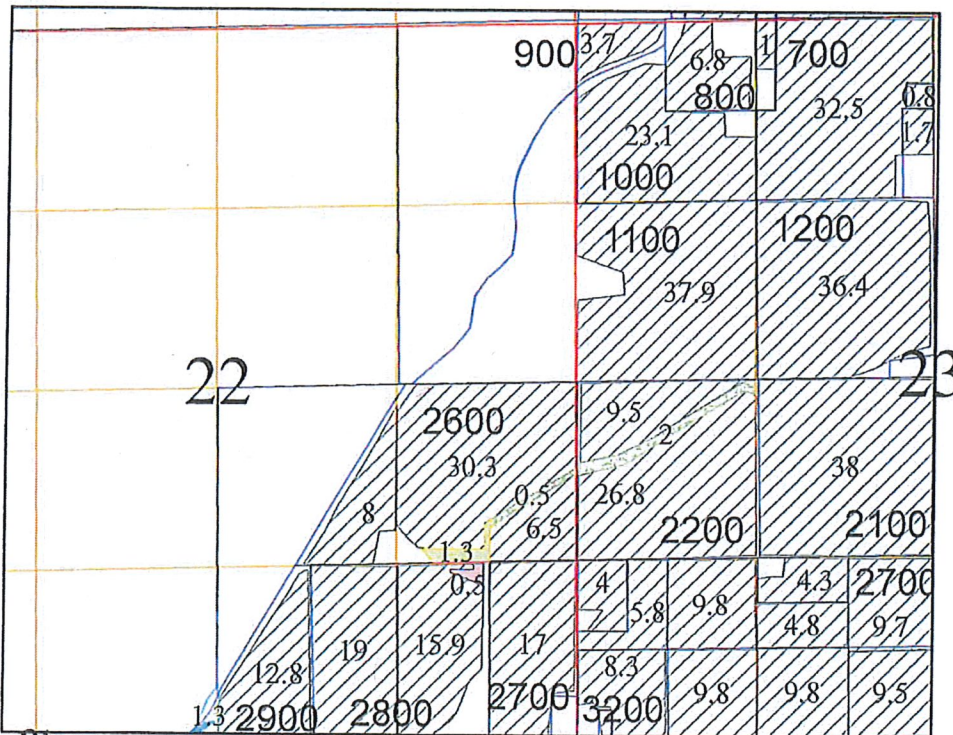

stan429final

Priority, USER, Stage

1965, 86203, ON

1965, 86203, OFF

1905, 87035,

1905, 87035, OFF \*

1905, 87035, ON

0.5 & 86377

N  
1 inch = 1320 feet

This map is not intended to provide legal dimensions or locations of property ownership lines.

Received by OWRD

JUN 15 2018

Salem, OR

T-12817

WALKER

MAP #5

STANFIELD IRRIGATION DISTRICT  
TOWNSHIP 4 NORTH, RANGE 29 EAST, W.M.

T 12817 Draft


Proposed Map  
March 2018

3.1 Acres of 1905 OFF

Section 27

TL 3302 NWNE 0.4 .2+.2 = .4  
TL 3500 SWNE 2.7  $\frac{1.9}{+.8} = 2.7$

OK  
Ry

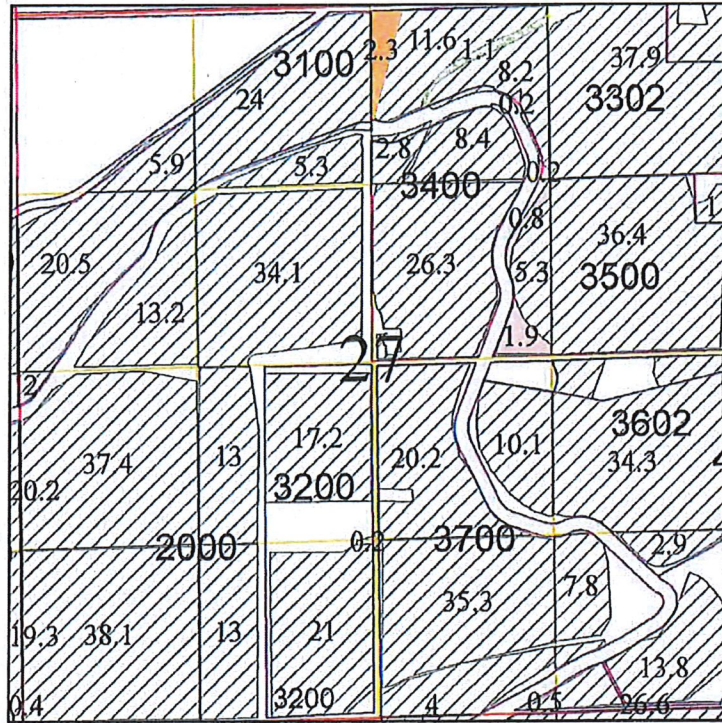

stan429final

Priority, USER, Stage

1965, 86203,

1905, 87035,

1905, 87035, OFF \*  $\$ 86377$

1905, 87035, ON



1 inch = 1320 feet

This map is not intended to provide legal dimensions or locations of property ownership lines.

Received by OWRD

JUN 15 2018


Salem, OR

T-12817

DITCHEN


# T. 4N, R. 29E, W.M., Sec. 28

## 1.0 acres TL 900 of SE SW OQ

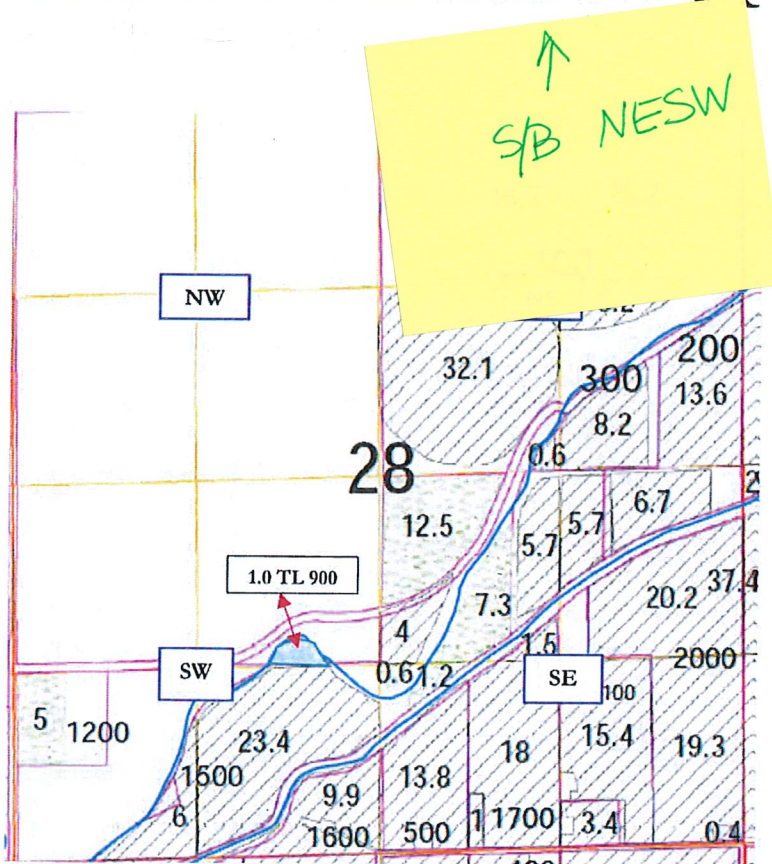

### Legend

Priority, Primary, Suppl

-  1905, 87035, 86377
-  1965, 86203, 86377
-  1965, 86203, 86205
-  1905, 87035, 86377 OFF \*

Received by OWRD

Scale: 1 in. = 1320 ft.

JUN 25 2018

# “FROM” LANDS”

Salem, OR



2017 STANFIELD IRRIGATION DISTRICT PERMANENT TRANSFER




Windblown - Prior

T-12817

WINDBLOWN RANCH
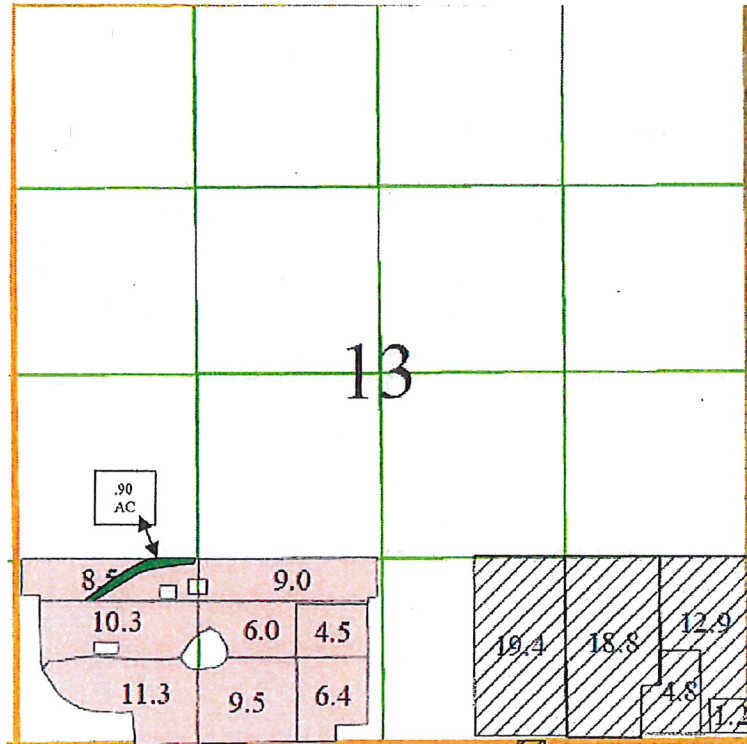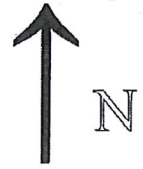
# T. 4 N., R. 28 E., W.M. Section QQ SWSW .90 Acres



	1905 Water Right
	1965 Water Right
	.80 Acres Transferred From

Scale: 1 in = 1320 ft.

## “FROM” LANDS

2018 STANFIELD IRRIGATION DISTRICT TRANSFER

Received by OWRD

APR 30 2018


Salem, OR




T-12817

C. 86203 / 86377

ROW
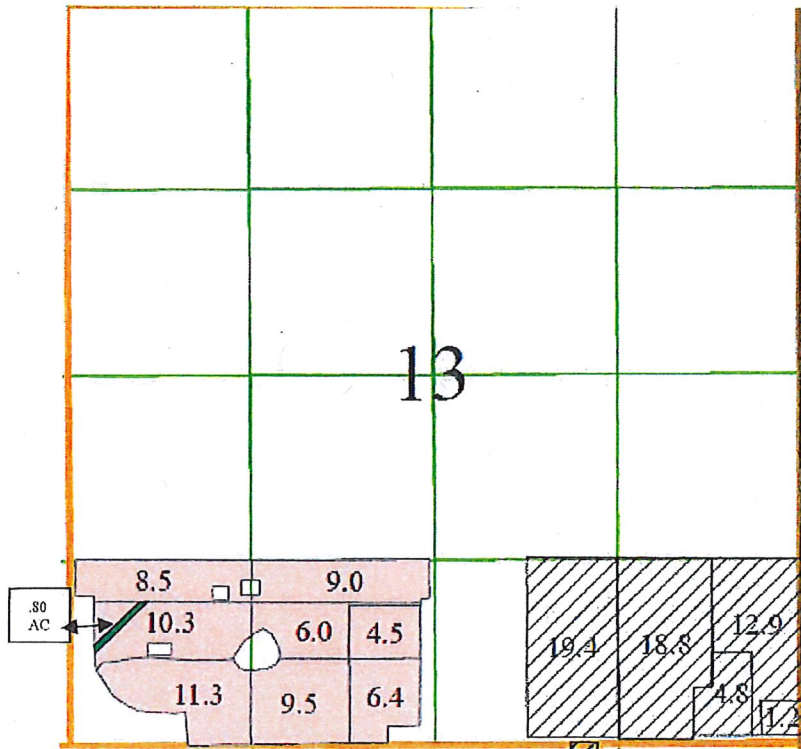
# T. 4 N., R. 28 E., W.M. Section QQ SWSW .80 Acres



	1905 Water Right
	1965 Water Right
	.80 Acres Transferred From

Scale: 1 in = 1320 ft.

## “FROM” LANDS

2018 STANFIELD IRRIGATION DISTRICT TRANSFER

Received by OWRD


APR 30 2018

Salem, OR

T-12817



C.86203/ 86377

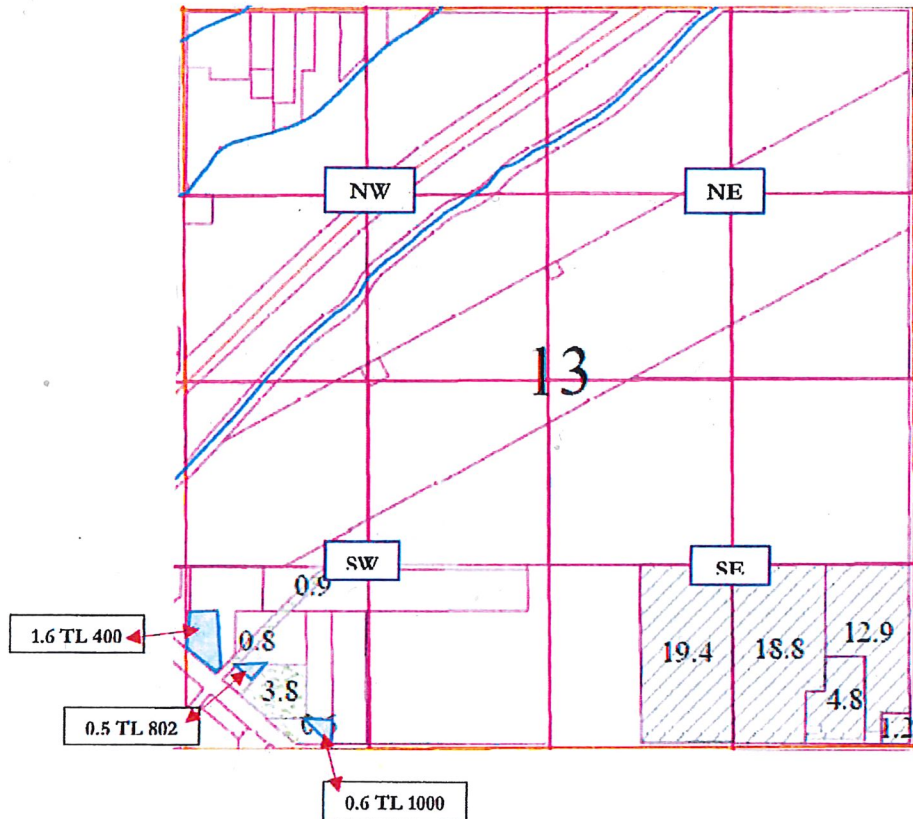**T. 4N, R. 28E, W.M., Sec. 13**  
**1.6 acres TL 400, 0.5 acres TL 802,**  
**0.6 acres TL 1000 of the SW SW QQ**



**Legend**

Priority, Primary, Suppl

-  1905, 87035, 86377
-  1965, 86203, 86377
-  1965, 86203, 86205
-  1965, 86203, 86377 OFF

Scale: 1 in. = 1320 ft.

**“FROM” LANDS”**

2017 STANFIELD IRRIGATION DISTRICT PERMANENT TRANSFER

Received by OWRD

JUN 25 2018

Salem, OR

T-12817



OFF

MAP # 8

STANFIELD IRRIGATION DISTRICT

TOWNSHIP 4 NORTH, RANGE 29 EAST, W.M.


T 12817 Draft

Proposed Map

March 2018

1.3 AC OFF Sec 22

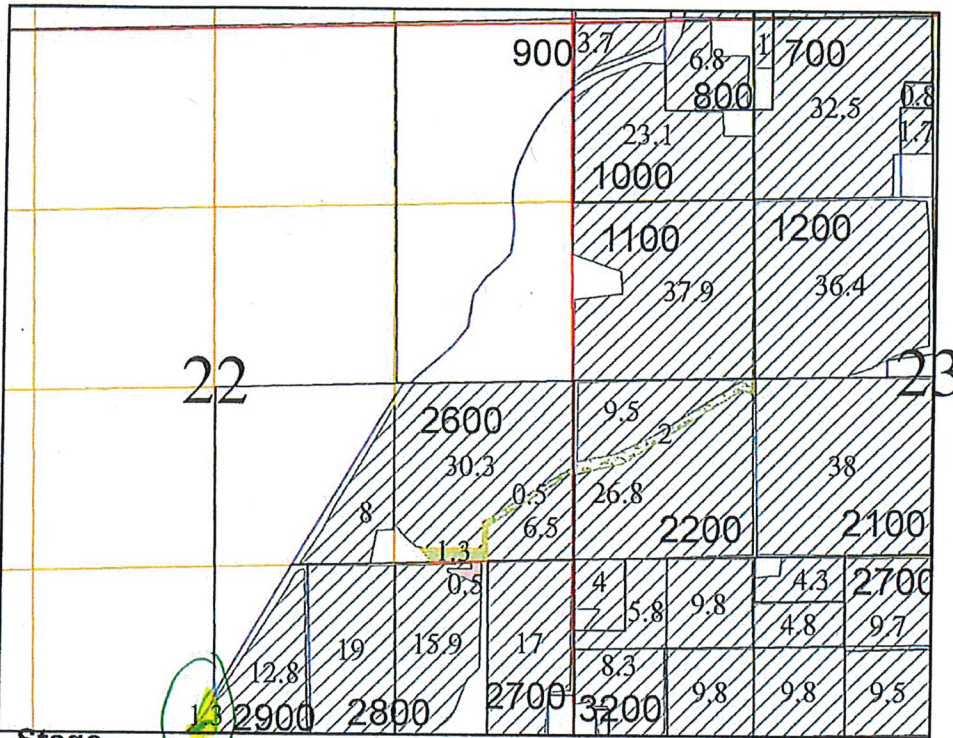




T L 2900 SESW 86203



OK Ray

stan429final

Priority, USER, Stage

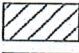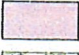-  1965, 86203, ON
-  1965, 86203, OFF \*
-  1905, 87035,
-  1905, 87035, OFF
-  1905, 87035, ON

\$ 86205



1 inch = 1320 feet

This map is not intended to provide legal dimensions or locations of property ownership lines.

Received by OWRD


JUN 15 2018

Salem, OR

T-12817




WALKER

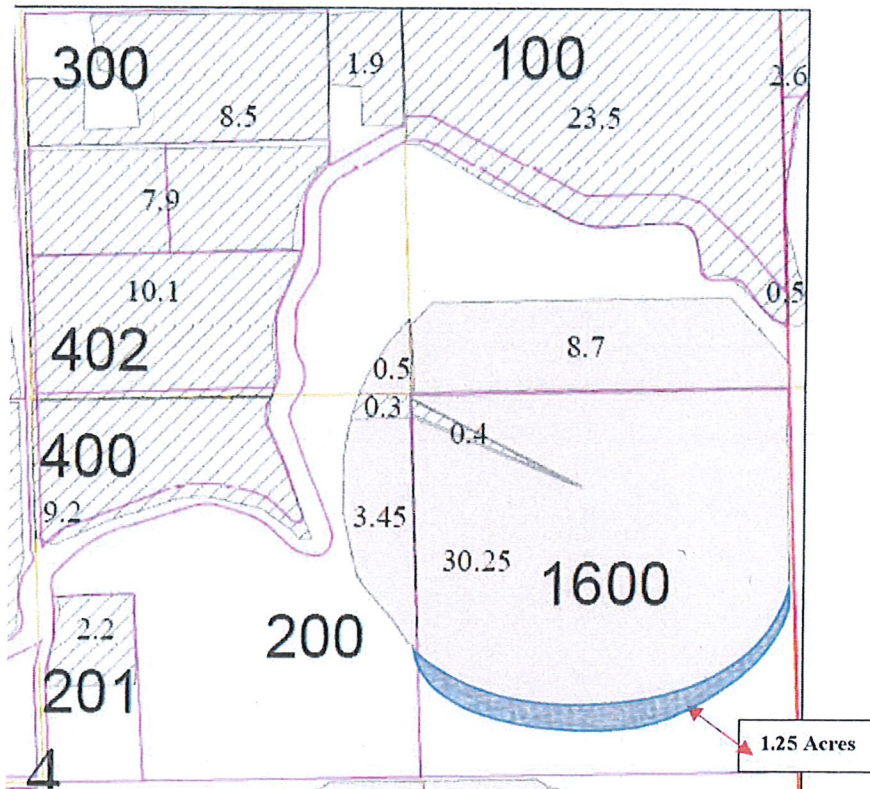T. 3N., R. 29E., W.M., Sec. 4  
 Tax Lot 1600  
 QQ SE NE 1.25 Acres



**Legend**

**Priority, Primary, Suppl**

-  1905, 87035, 86377
-  1965, 86203, 86205
-  1965, 86203, 86205 OFF

Received by OWRD

NOV 02 2018

Salem, OR

Scale: 1 in. = 660 ft.

“FROM” LANDS”

2017 STANFIELD IRRIGATION DISTRICT PERMANENT TRANSFER

T-12817

MAP #2

STANFIELD IRRIGATION DISTRICT  
TOWNSHIP 4 NORTH, RANGE 29 EAST, W.M.


T 12817 Draft ON

Proposed Map  
March 2018

Section 9 SENE

2 Acres ON (~~unbalanced~~) TL 1800

OK  
Log

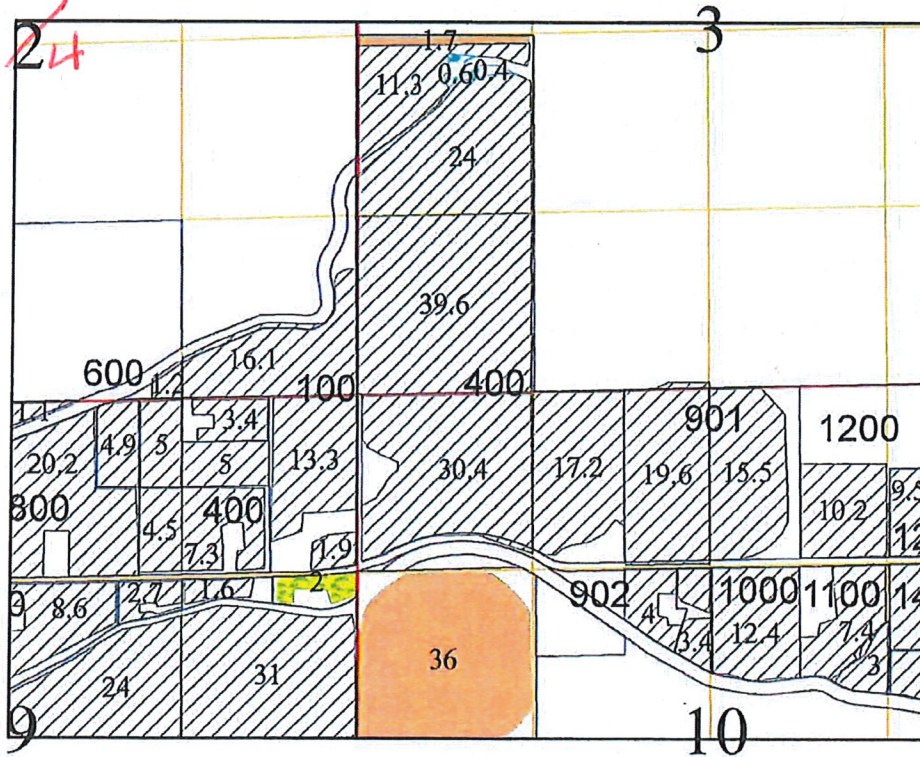



stan429final

Priority, USER, Stage

 1965, 86203,

 1905, 87035,

 1905, 87035, OFF

 1905, 87035, ON



1 inch = 1320 feet

& 86377 2.0 ON

This map is not intended to provide legal dimensions or locations of property ownership lines.

Received by OWRD

JUN 15 2018


Salem, OR

T-12817

HARMON


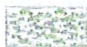



# T. 4N, R. 29E, W.M., Sec. 19
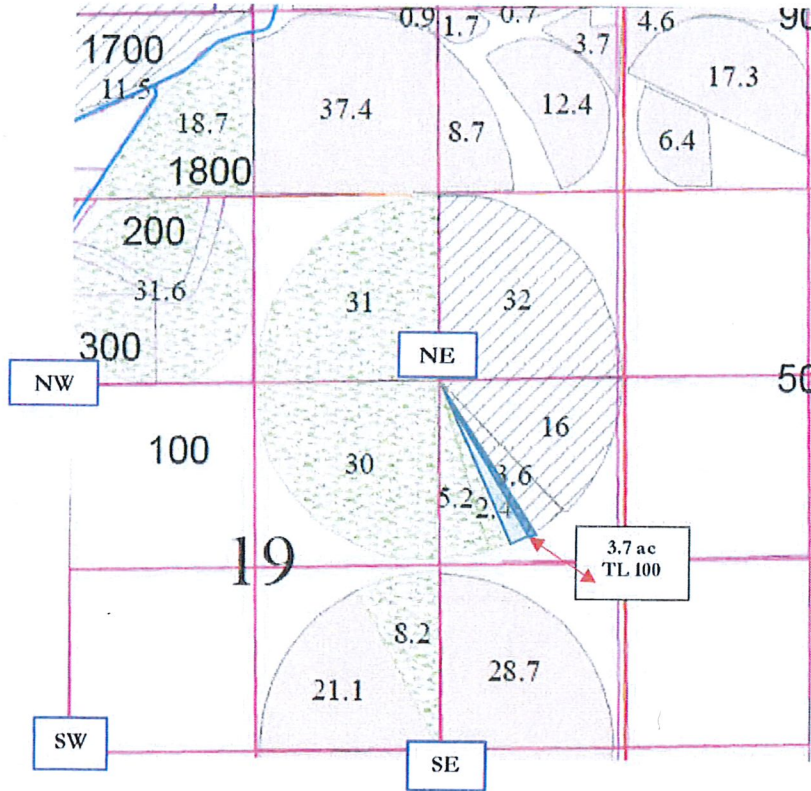
## 3.7 acres TL 100 of SE NE QQ



### Legend

#### Priority, Primary, Suppl

-  1905, 87035, 86377
-  1965, 86203, 86377
-  1965, 86203, 86205
-  1905, 87035, 86377 1.0 acres ON
-  1965, 86203, 86377 2.7 acres ON

Received by OWRD

JUN 25 2018

Salem, OR

Scale: 1 in. = 1320 ft.

# “TO” LANDS”

2017 STANFIELD IRRIGATION DISTRICT PERMANENT TRANSFER

Windblown - Prior

T-12817  
WINDBLOWN RAUCH


MAP #7

STANFIELD IRRIGATION DISTRICT  
TOWNSHIP 4 NORTH, RANGE 29 EAST, W.M.

T 12817 Draft



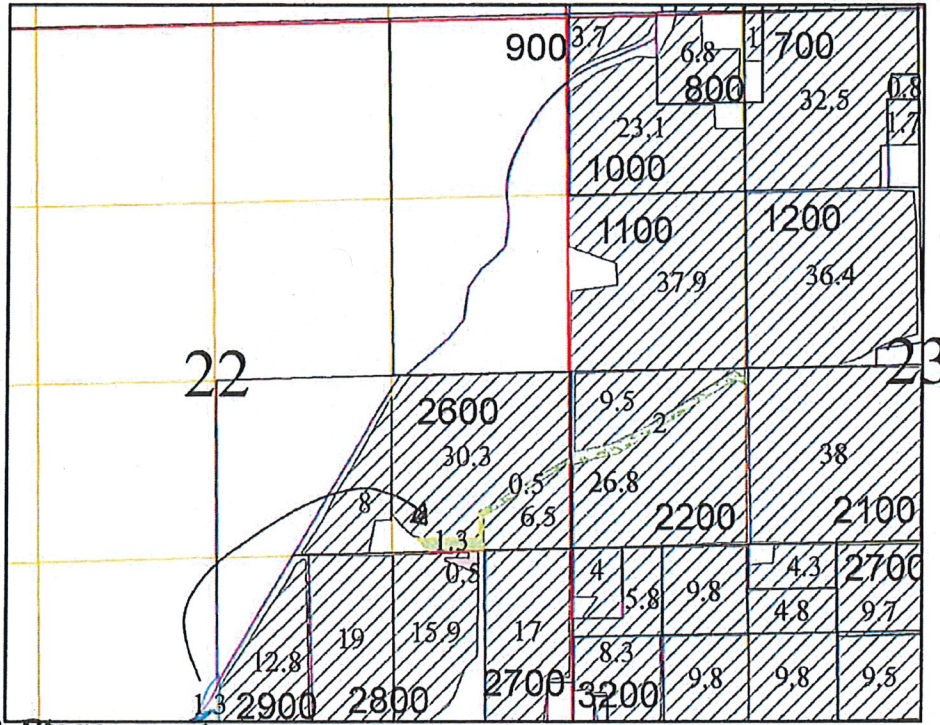


Proposed Map  
March 2018

2.0 acres NW3W  
Section 23  
TL 2200



stan429final

Priority, USER, Stage

-  1965, 86203, ON
-  1965, 86203, OFF
-  1905, 87035,
-  1905, 87035, OFF
-  1905, 87035, ON

\* \$ 86377 2.0 AC



1 inch = 1320 feet

This map is not intended to provide legal dimensions or locations of property ownership lines.

Received by OWRD

JUN 15 2018

Salem, OR

T-12817

DITCHEN LAND CO


MAP #4

STANFIELD IRRIGATION DISTRICT  
TOWNSHIP 4 NORTH, RANGE 29 EAST, W.M.


T 12817 Draft *ON* Proposed Map  
March 2018

*sec 22 TL 2600  
.5 NESE*

*OK  
Ray*

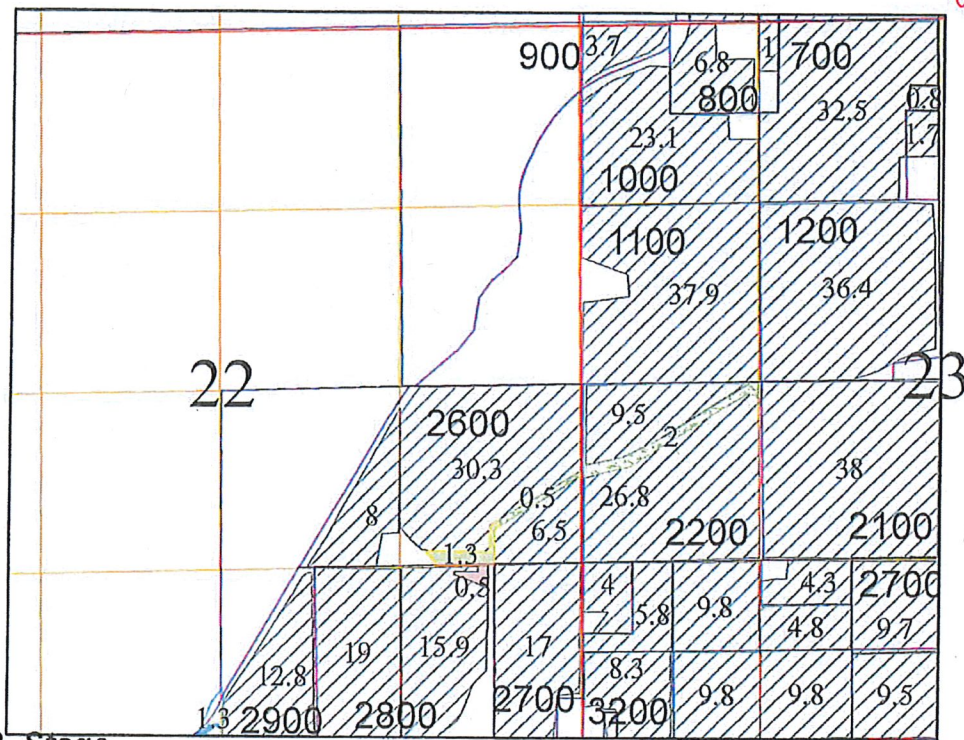

stan429final  
Priority, USER, Stage

-  1965, 86203, ON
-  1965, 86203, OFF
-  1905, 87035,
-  1905, 87035, OFF
-  1905, 87035, ON

*‡ 86377 \* .5AC*



1 inch = 1320 feet

This map is not intended to provide legal dimensions or locations of property ownership lines.

Received by OWRD

*walker*

JUN 15 2018

Salem, OR

T-12817

MAP #6

STANFIELD IRRIGATION DISTRICT  
TOWNSHIP 4 NORTH, RANGE 29 EAST, W.M.

T 12817 Draft


Proposed Map  
March 2018

NWNE, Section 27

TL 3302

1.1 Acres of 1905 ON

OK Key

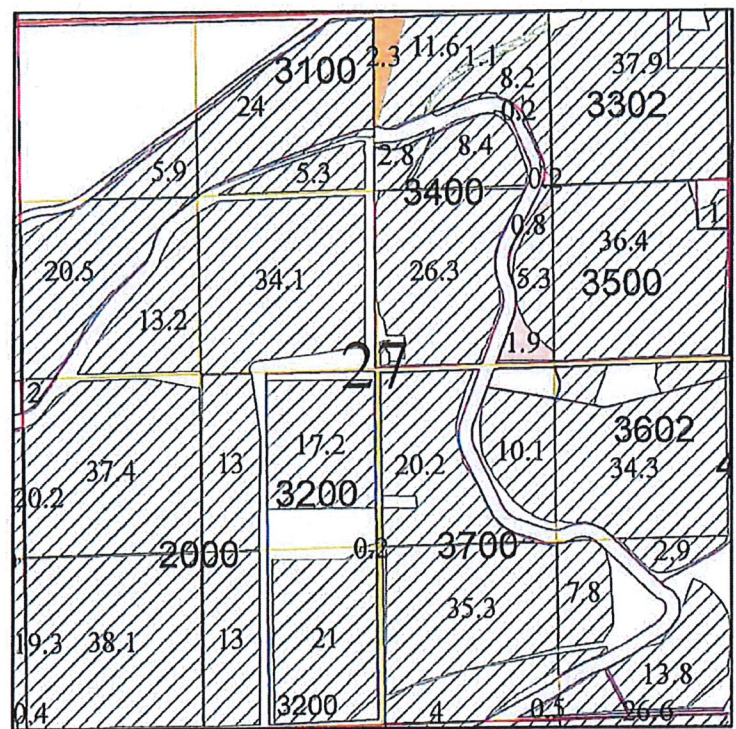

stan429final

Priority, USER, Stage

1965, 86203,

1905, 87035,

1905, 87035, OFF

1905, 87035, ON

1.1 AC & 86377



1 inch = 1320 feet

This map is not intended to provide legal dimensions or locations of property ownership lines.

Received by OWRD

JUN 15 2018

Salem, OR

T-12817

DITCHEN LAND CO

ON

MAP #9

STANFIELD IRRIGATION DISTRICT


TOWNSHIP 4 NORTH, RANGE 29 EAST, W.M.

T 12817 Draft

Proposed Map  
March 2018

NE SE Section 22  
1.3 ac - ON TL 2600

OK Ray

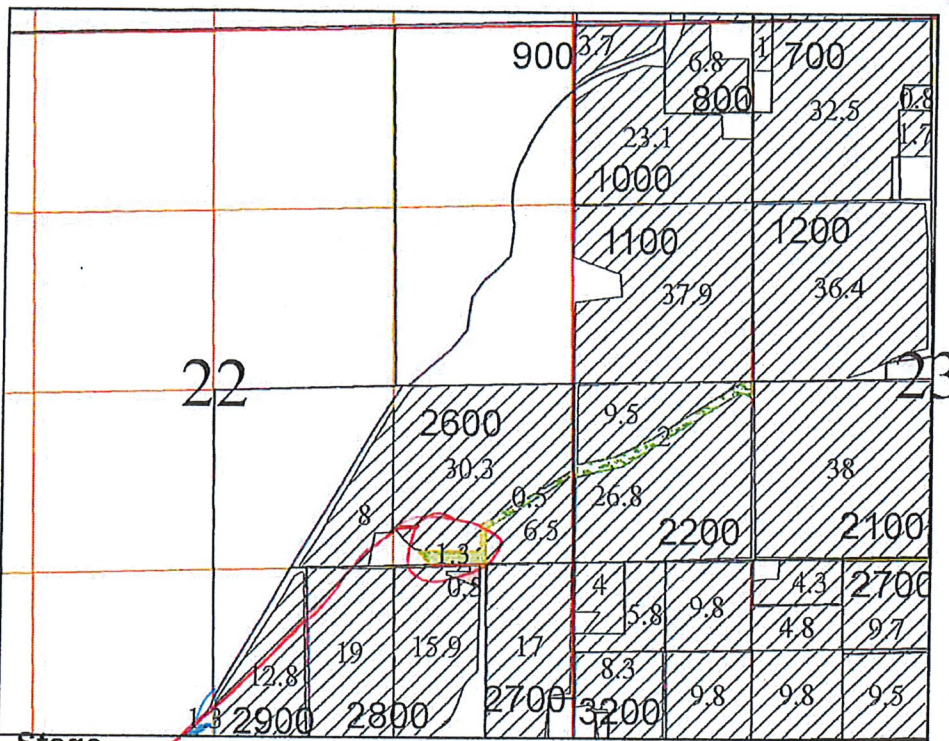

stan429final

Priority, USER, Stage

1965, 86203, ON

1965, 86203, OFF

1905, 87035,

1905, 87035, OFF

1905, 87035, ON

→ \$ 86205 1.3



1 inch = 1320 feet

This map is not intended to provide legal dimensions or locations of property ownership lines.

Received by OWRD

JUN 15 2018


Salem, OR




T-12817

WALKER

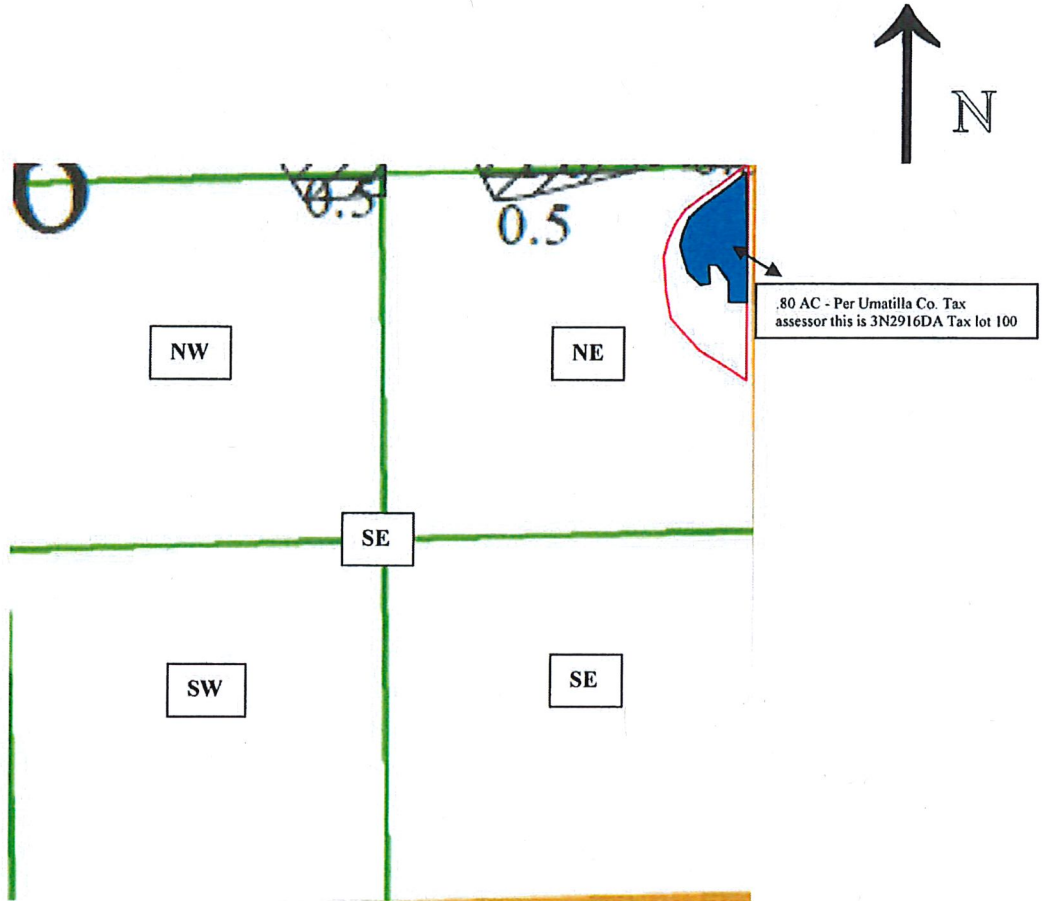

# T. 3 N., R. 29 E., W.M. Section 16 QQ NESE .80 Acres

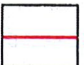

	1905 Water Right
	Transferred To 1965 Water Right
	Property Tax Line Lot 600

86203 & 86377  
Received by OWRD

APR 30 2018

Salem, OR

Scale: 2 in = 1320 ft.


## “TO” LANDS




2018 STANFIELD IRRIGATION DISTRICT PERMANENT TRANSFER

T-12817

EVANS
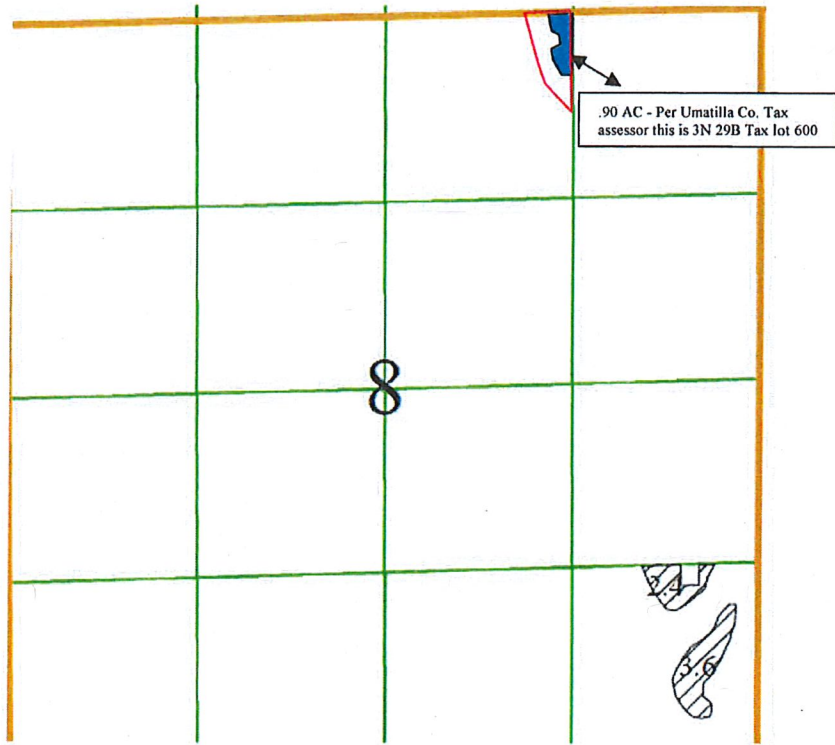
# T. 3 N., R. 29 E., W.M. Section 8 QQ NWNE .90 Acres



	1905 Water Right
	Transferred To 1965 Water Right
	Property Tax Line Lot 600

Received by OWRD

86203 APR 30 2018  
\$  
86377 Salem, OR

Scale: 1 in = 1320 ft.


## “TO” LANDS

2018 STANFIELD IRRIGATION DISTRICT PERMANENT TRANSFER

T-12817


HUXOLL

T. 3N., R. 29E., W.M., Sec. 4  
 Tax Lot 200  
 QQ NE NE 1.25 Acres

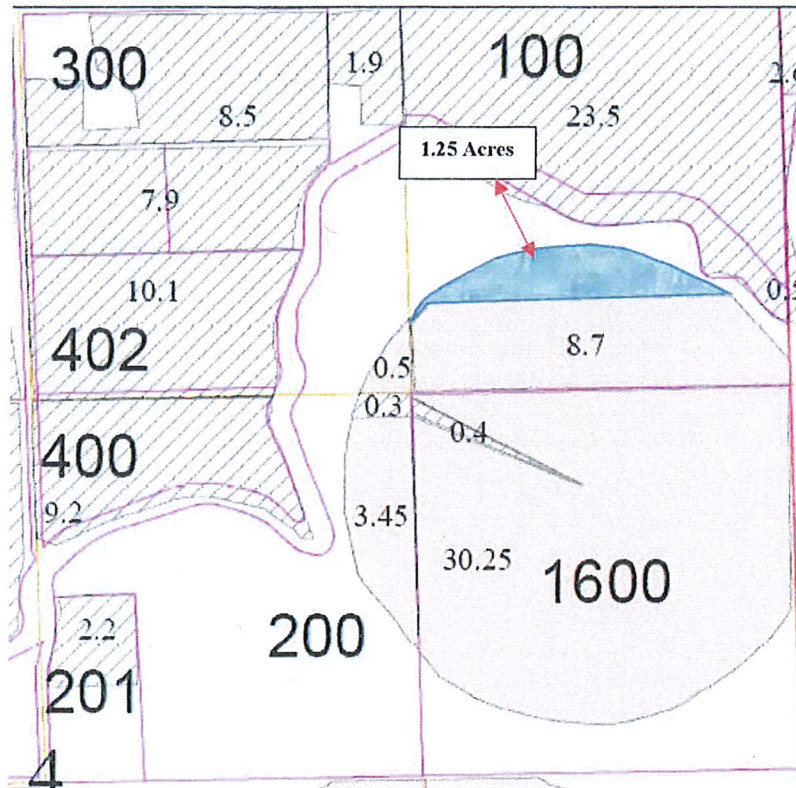

**Legend**

**Priority, Primary, Suppl**

-  1905, 87035, 86377
-  1965, 86203, 86205
-  1965, 86203, 86205 ON

Received by OWRD

NOV 02 2018

Salem, OR

Scale: 1 in. = 660 ft.

“TO” LANDS”

2017 STANFIELD IRRIGATION DISTRICT PERMANENT TRANSFER

T-12817