



~~"FROM" MAP~~  
TO:

T. 6S., R. 1 & 2W., W.M.

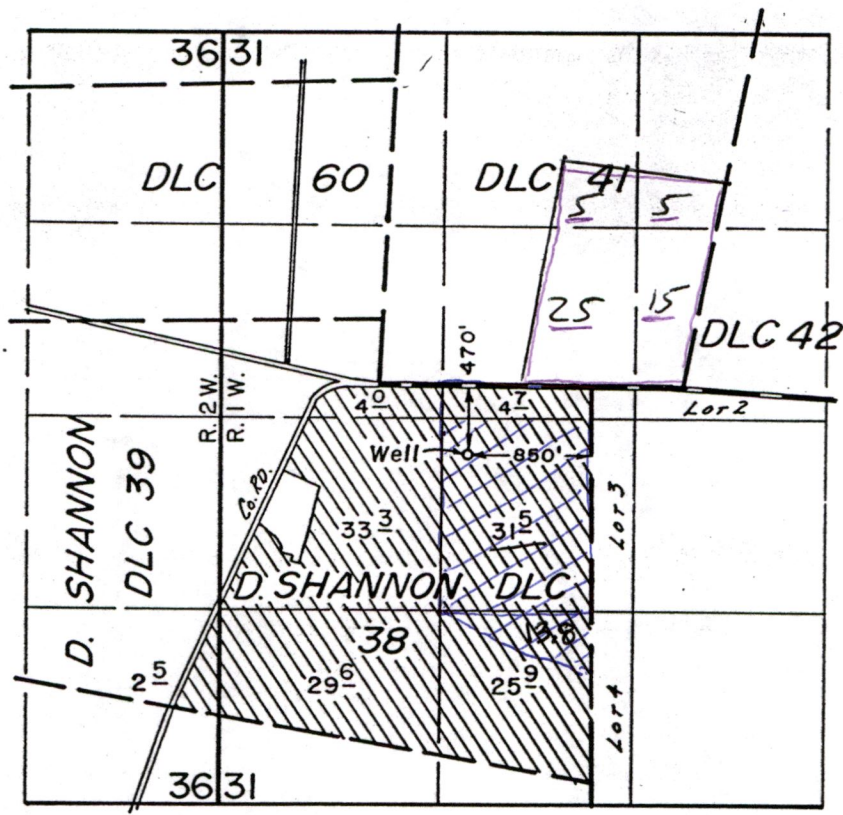

exact Acres

SCALE: 1"=1320'

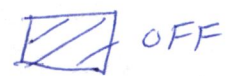

### FINAL PROOF SURVEY UNDER

Application No. G-10608 Permit No. G-9617.....  
IN NAME OF

.....WESLEY J. JOHNSON.....

Surveyed July 23... 1984, by B.W. BISHOP.....

RECEIVED

DEC 04 2018

OWRD

13071