


0575

FINAL PROOF SURVEY/CLAIM OF BENEFICIAL USE - T 10291
LOCATED IN: SECTION 32, T17S, R12E AND SECTION 5, T18S, R12E, W.M.,
CITY OF BEND, DESCHUTES COUNTY, OREGON

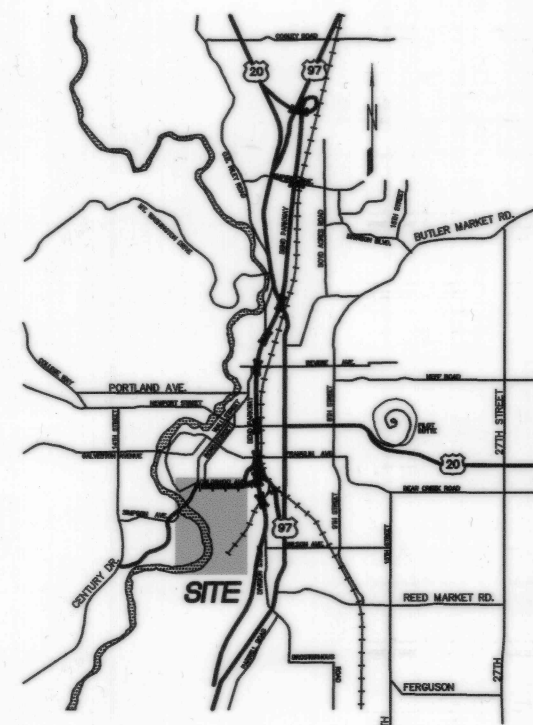

VICINITY MAP

RECEIVED
MAR 14 2011
WATER RESOURCES DEPT
SALEM, OREGON

COBU MAP # 0575

- LEGEND**
- T-10291 WATER METERS (ALSO INCLUDES T-9769, T-9283, T-7574 FROM PREVIOUS CLAIM OF BENEFICIAL USE)
 - T-10291 QUASI MUNICIPAL IRRIGATION TAX LOTS (ALSO INCLUDES T-9769, T-9283, T-7574 FROM PREVIOUS CLAIM OF BENEFICIAL USE)
(NOTE ACTUAL IRRIGATED AREAS WILL BE LESS)
- NOTE: THE PREPARATION OF THIS MAP IS FOR THE PURPOSE OF IDENTIFYING THE LOCATION OF THE WATER RIGHT ONLY AND HAS NO INTENT TO PROVIDE DIMENSIONS OR LOCATION OF PROPERTY OWNERSHIP LINES.



1" = 400'



COPYRIGHT 2010
HICKMAN, WILLIAMS & ASSOCIATES
ALL RIGHTS RESERVED

FINAL PROOF SURVEY/CLAIM OF BENEFICIAL USE
APPLICATION T 10291
MILLSITE MANAGEMENT COMPANY/
CENTRAL OREGON IRRIGATION DISTRICT

HWA SURVEYORS, ENGINEERS & PLANNERS
HICKMAN, WILLIAMS & ASSOCIATES, INC.
62700 O.E. & BILEY ROAD, SUITE 100
BEND, OREGON 97701
PHONE: 541.389.9351 FAX: 541.388.5416
WWW.HWA-INC.ORG

REVISIONS	
1.	
2.	
3.	

DESIGNED BY: AAA
DRAWN BY: DRW
CHECKED BY: AAA
SCALE: 1"=400'
FILE: 100910-COBU

DATE: 3/9/11

SHEET
1 / 1

HWA # 100910