

APPLICATION FOR PERMANENT DISTRICT TRANSFER – 2018

EAGLE POINT IRRIGATION DISTRICT

SECTION 4, T.35S, R.1E, W.M.

JACKSON COUNTY, OREGON

RECEIVED

DEC 06 2018


OWRD

Assessor Map T-35S-R1E-4

District Internal Notice
T-2018-001

Certificate 89373

TRANSFER FROM & TRANSFER TO

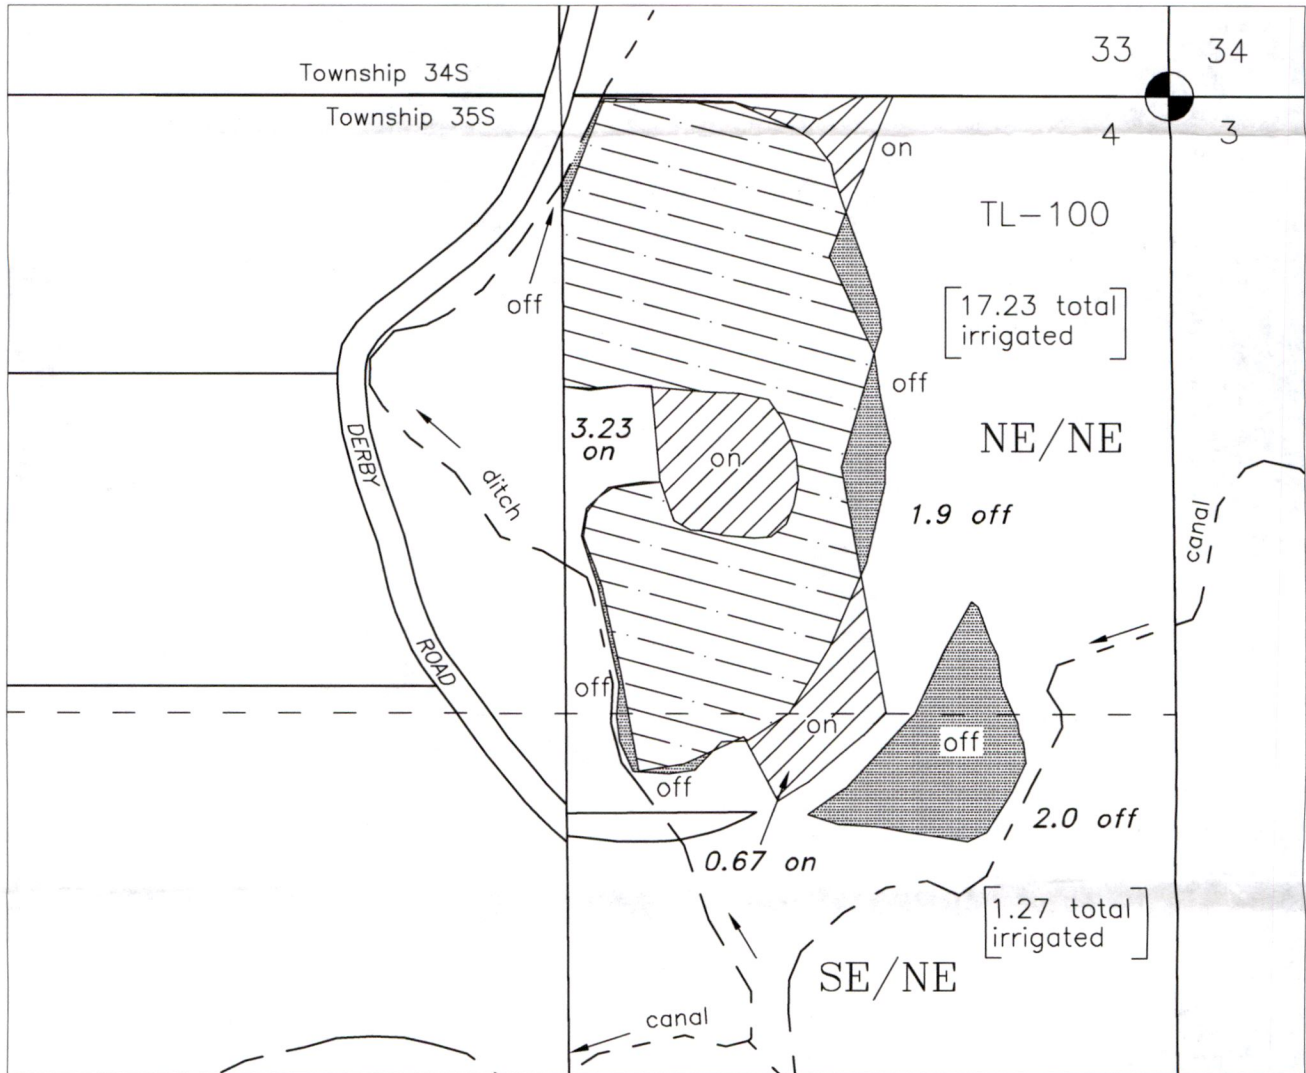

Water User :
Scott R. Rosendahl



3.9 Acres OFF
TL-100



3.9 Acres ON
TL-100



14.6 Acres
No Change

EAGLE POINT IRRIGATION DISTRICT
2329 BROPHY ROAD – P.O. BOX 157
EAGLE POINT, OR 97524
PHONE 541-826-3411 – FAX 541-826-8738

This map is not intended to provide legal
dimensions or locations of property ownership lines

Scale

1 inch = 400 feet



11/29/2018 n.e.d.

13073