


**FINAL PROOF SURVEY/CLAIM OF BENEFICIAL USE - T 10004 AND T 9769, T 9283, T 9288, T 7574 - LOCATED IN SECTION 5, T8S, R18E, W1E, CITY OF BEND, DESCHUTES COUNTY, OREGON**



**NOTE:**  
DIVERSION POINT  
BEARS: S65°46'27"W,  
3621.45 FEET FROM THE  
NORTHEAST CORNER OF  
SECTION 5

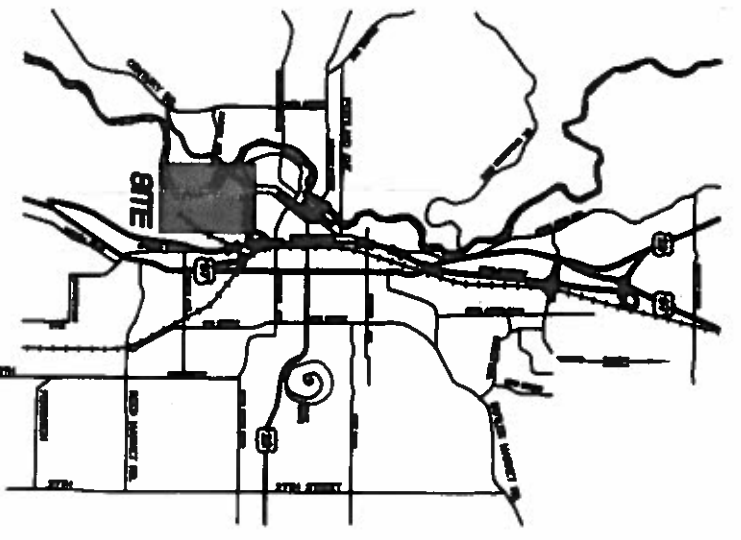

**VICINITY MAP**

- LEGEND**
- T-10004 WATER METERS
  - T-9769, T-9283, T-7574 WATER METERS
  - ▨ T-10004 IRRIGATED AREAS
  - ▩ T-9769, T-9283, T-7574 QUASI MUNICIPAL TAXLOTS

(NOTE ACTUAL IRRIGATED AREAS WILL BE LESS)

**NOTE:** THE PREPARATION OF THIS MAP IS FOR THE PURPOSE OF IDENTIFYING THE LOCATION OF THE WATER RIGHT ONLY AND HAS NO INTENT TO PROVIDE DIMENSIONS OR LOCATION OF PROPERTY OWNERSHIP LINES.

PLACE OF IRRIGATION WATER USE FOR TRANSFER 10004:

NW1/4NW1/4 -	0.919 AC
SW1/4NW1/4 -	1.051 AC
SE1/4NW1/4 -	4.590 AC
NE1/4SW1/4 -	0.540 AC
TOTAL WATER ON -	7.100 AC

**RECEIVED**  
OCT 10 2007  
WATER RESOURCES DEPT  
SALEM, OREGON

Central Oregon Water Right Exchange  
419 WINE  
DAVID R. WILLIAMS  
MAY 16, 1985  
STATE OF OREGON  
NOON  
9/24/07

**OLD MILL CLAIM OF BENEFICIAL USE (COBU) MAP APPLICATIONS T-10004 + T-9769, T9283, T-7574**  
**CENTRAL OREGON IRRIGATION DISTRICT**  
BEND OREGON

**HWA** SURVEYORS, ENGINEERS & PLANNERS  
**HICKMAN, WILLIAMS & ASSOCIATES, INC**  
898 NW YORK DRIVE, BEND, OREGON 97701  
PHONE: (541) 388-8351 FAX: (541) 388-8418  
EMAIL: jwb@hwa-ho.org

DATE: **SEPT 25, 2007**  
DRAWN BY: **DW/AS**  
CHECKED BY: **DW/AS**  
SCALE: **1"=400'**

**A-1**

**COBU MAP # 0294**